


1941
 FOUNTAIN ~ SL GILBERT TO N.L. MORRIS
 30' CONC.

*From Sta 2+0 to 6+0
 set grade with
 flow grade
 P.S.A.*

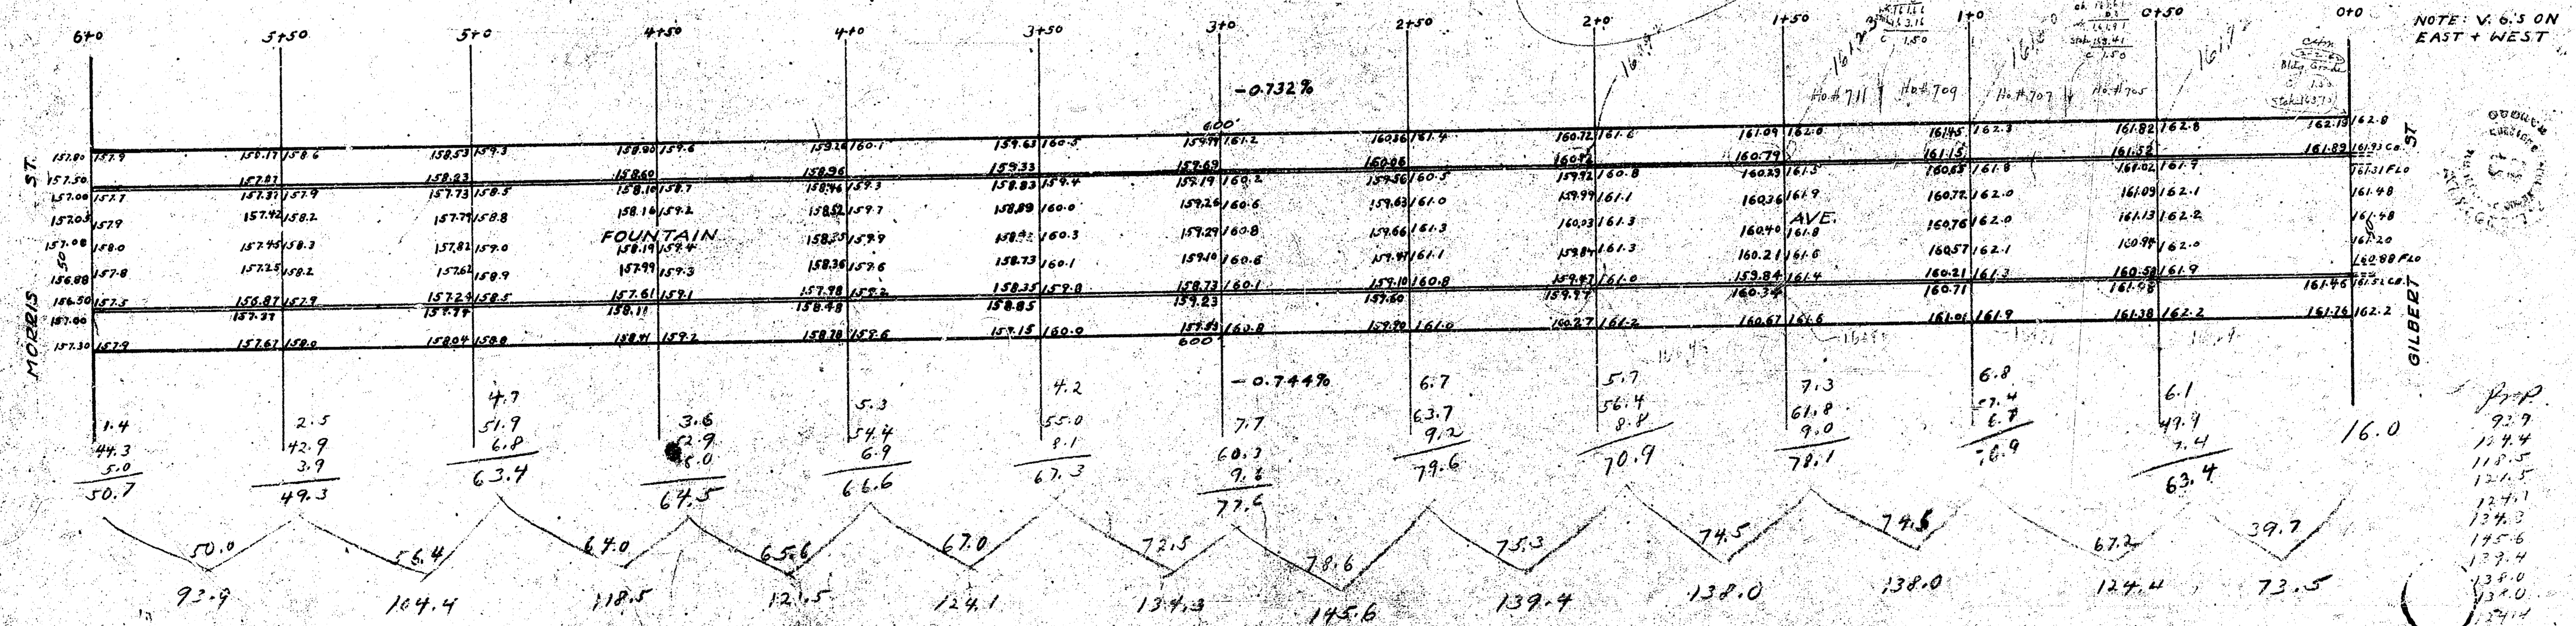

B.M. 16152 END OF EAST CB. SE FOUNTAIN + GILBERT

Handwritten notes and calculations:
 1455.6
 145.6
 1601.2
 7100
 1601.2