Book 1
J.Y.

B.M. 102.35 "A" in Rail Rd. Sta. Wk. N. NW. Cor. Topeka & Funston

Prop.	City
10.3	3.4
6.5	10.0
16.9	0.7
22.0	14.1
4.5	+109.
10.7	Total 15.5 Cu Yds.
26.5	
27.8	
4.4	
6.4	
136.0	
+109.	
Total 149.6 Cu Yds.	

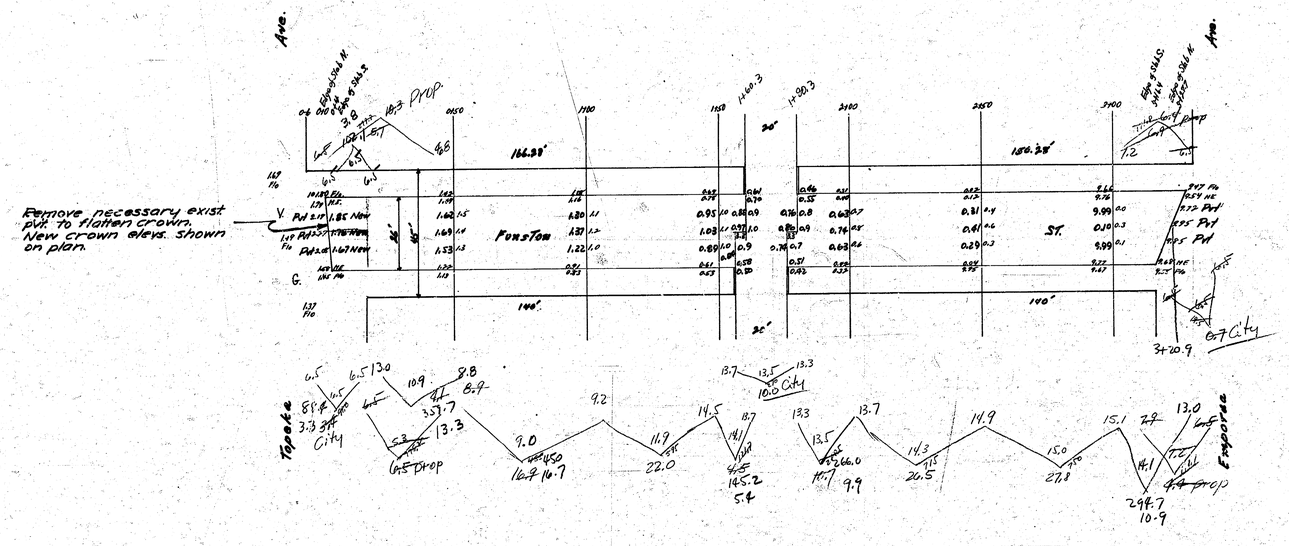
Ave.
Ave.
Remove necessary exist pvt. to flatten crown. New crown elevs. shown on plan.
Funston
ST.
166.38'
186.38'
140'
140'
30'
30'
3+20.9
Topeka
City
Emporia
City
Prop
Prop
Prop

DON 1941 PLAT

FUNSTON ST. - E.L. TOPEKA W.L. EMPORIA AVE
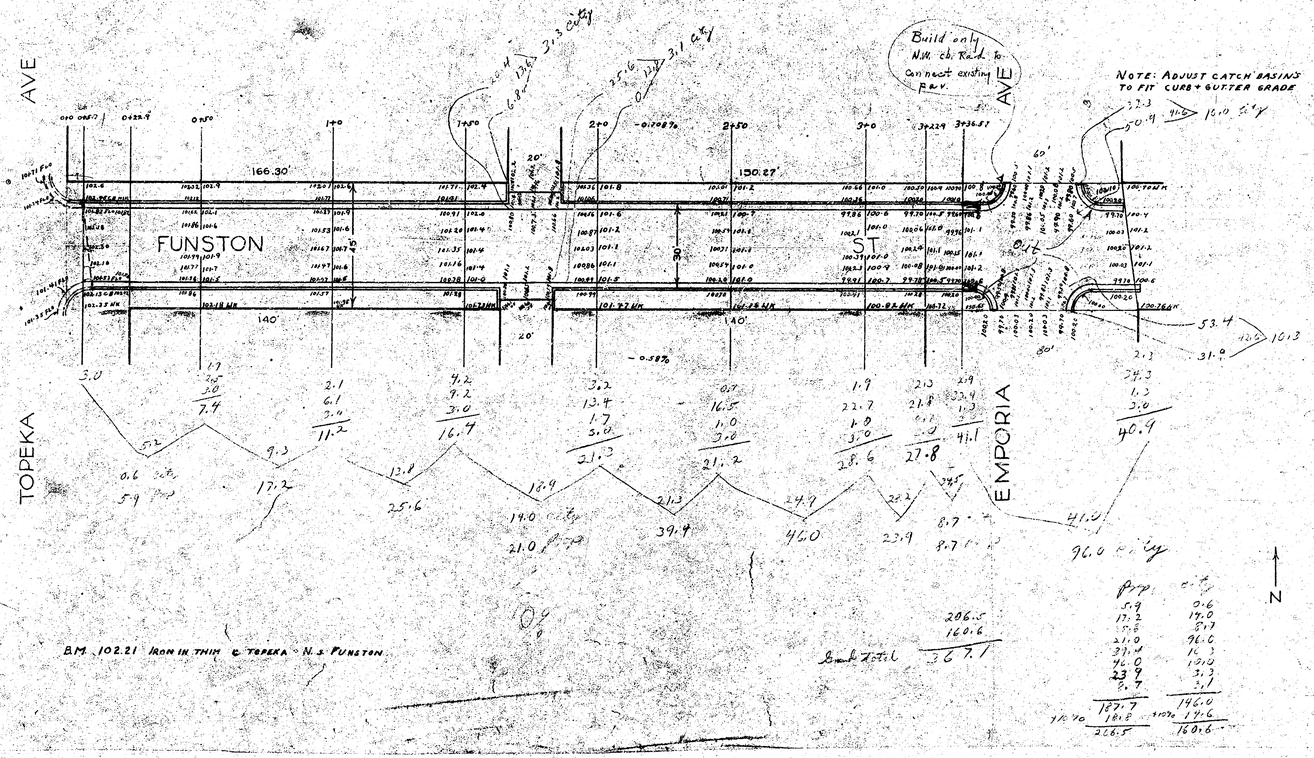
Cb & Gtr.