B.M. 99.19 Iron at ctr. Hydraulic & Funston.
B.M. 100.44 "G" in Globe at N cb N.E. Funston & Ellis.
B.M. 99.77 "G" in Globe N cb Funston & E.L. Lulu.

Excavation	
Prop.	City
1558.1	1959
155.8	196
1713.9	2155

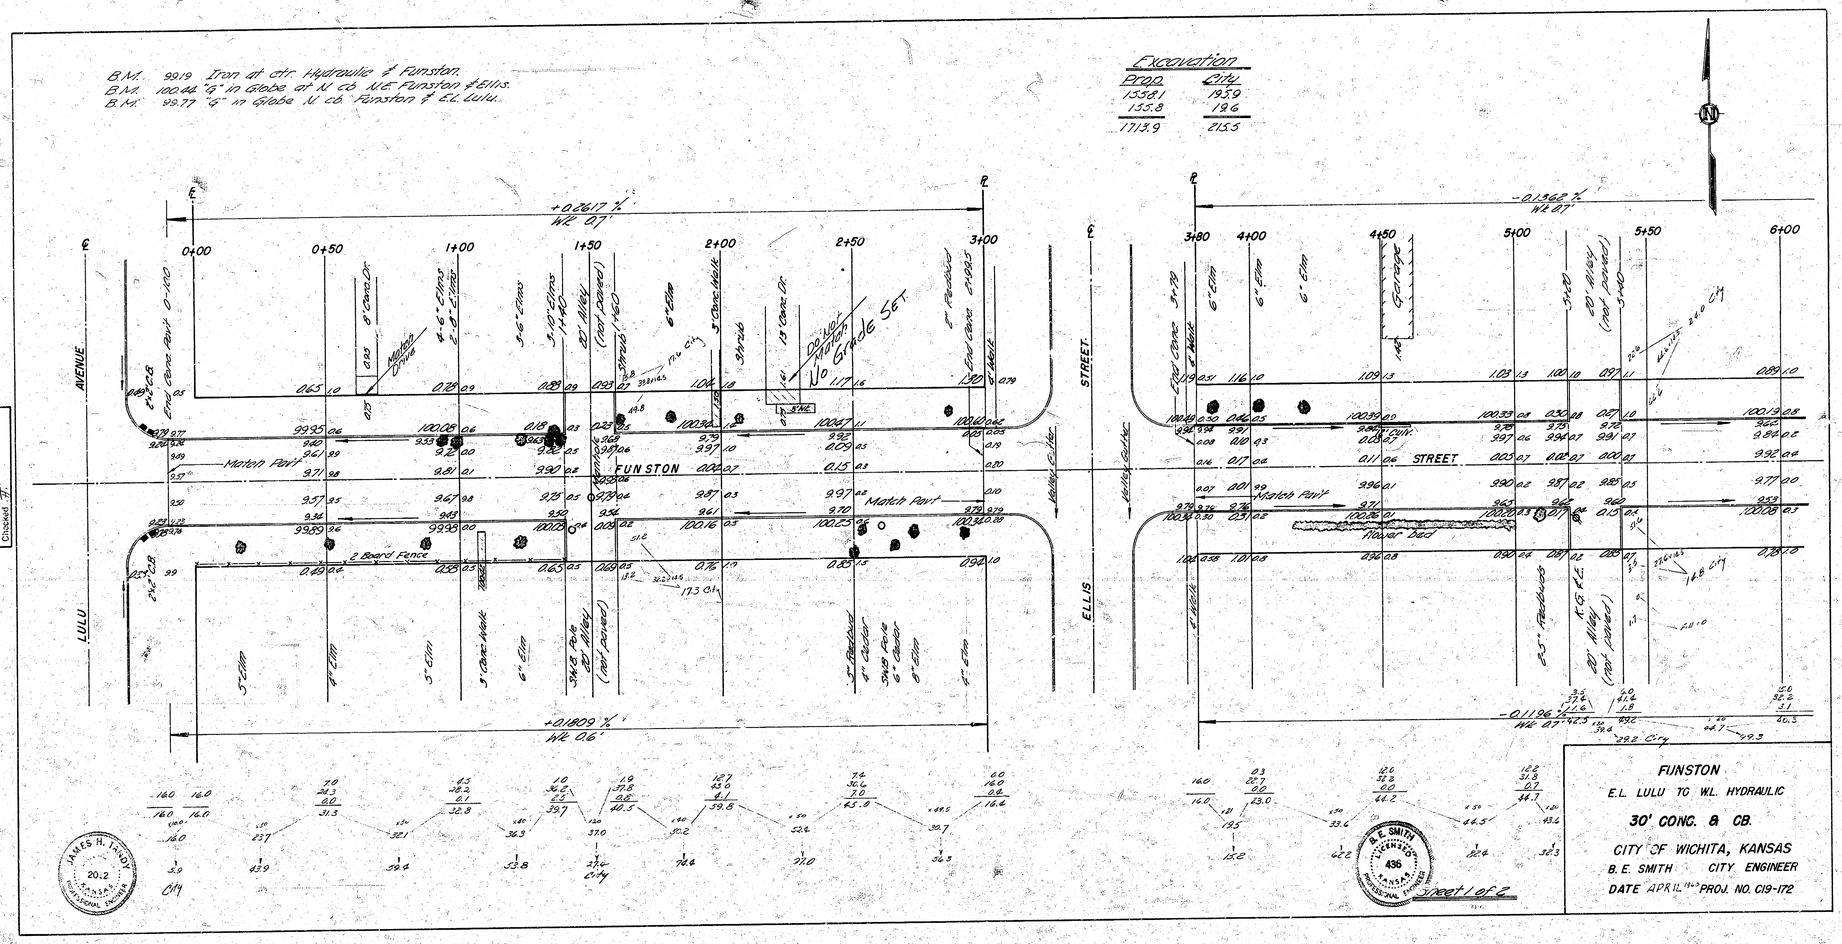

JAMES H. TANDY 20.2 KANSAS PROFESSIONAL ENGINEER

B. E. SMITH LICENSED 436 KANSAS PROFESSIONAL ENGINEER

Sheet 1 of 2

FUNSTON
E.L. LULU TO W.L. HYDRAULIC
30' CONC. & CB.
CITY OF WICHITA, KANSAS
B. E. SMITH CITY ENGINEER
DATE APRIL 1940 PROJ. NO. C19-172

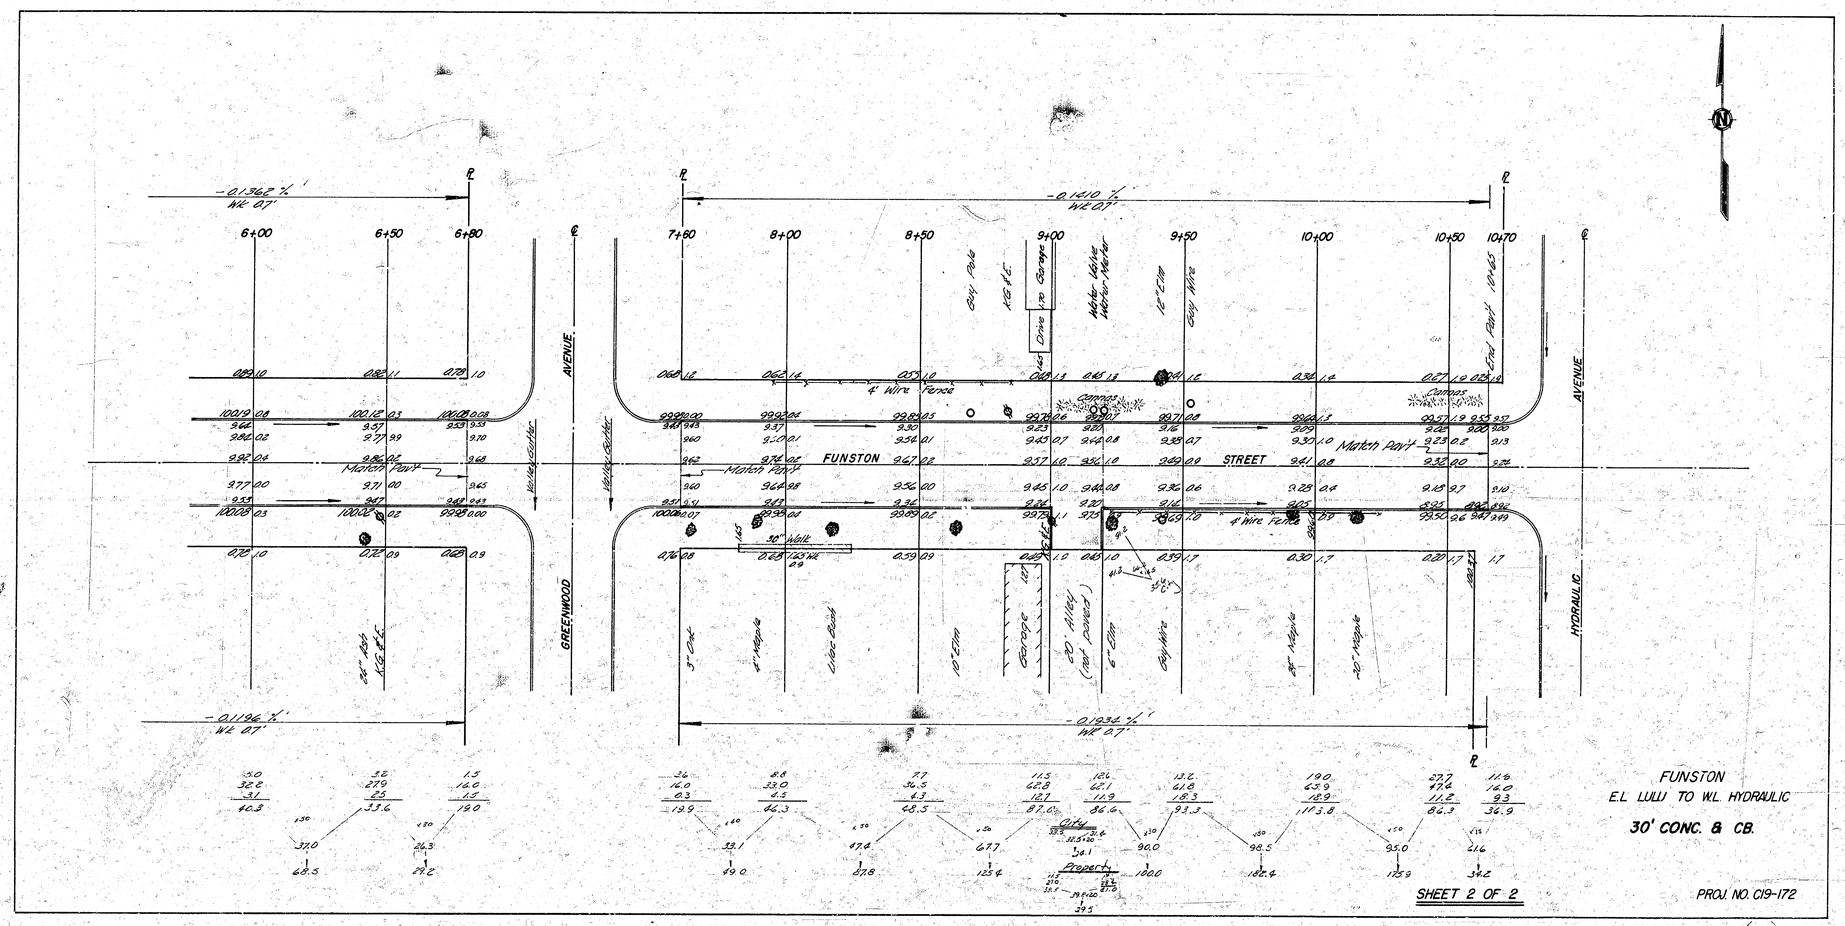
6+00
6+50
6+80
7+60
8+00
8+50
9+00
9+50
10+00
10+50
10+70
AVENUE
GREENWOOD
HYDRAULIC
FUNSTON
STREET
Match Part
4' Wire Fence
Garage
Drive
Guy Pole
Guy Wire
Valley Gutter
FUNSTON
E.L. LULU TO W.L. HYDRAULIC
30' CONC. & CB.
SHEET 2 OF 2
PROJ. NO. C19-172

10 8 1 (13)