


BK # 19.34

B.M. 10454 "W" in East Wacoate Front W. N. M.W. Don. Waco & Funston.
B.M. 10410 "T" in Troy Top Hyd. NW Cor. Wichita & Funston

Property	City
38.4	13.3
54.3	7.3
58.3	27.3
48.7	47.9
37.3	110%
287.2	52.7 a. 74.
710%	
3073 a. 74.	

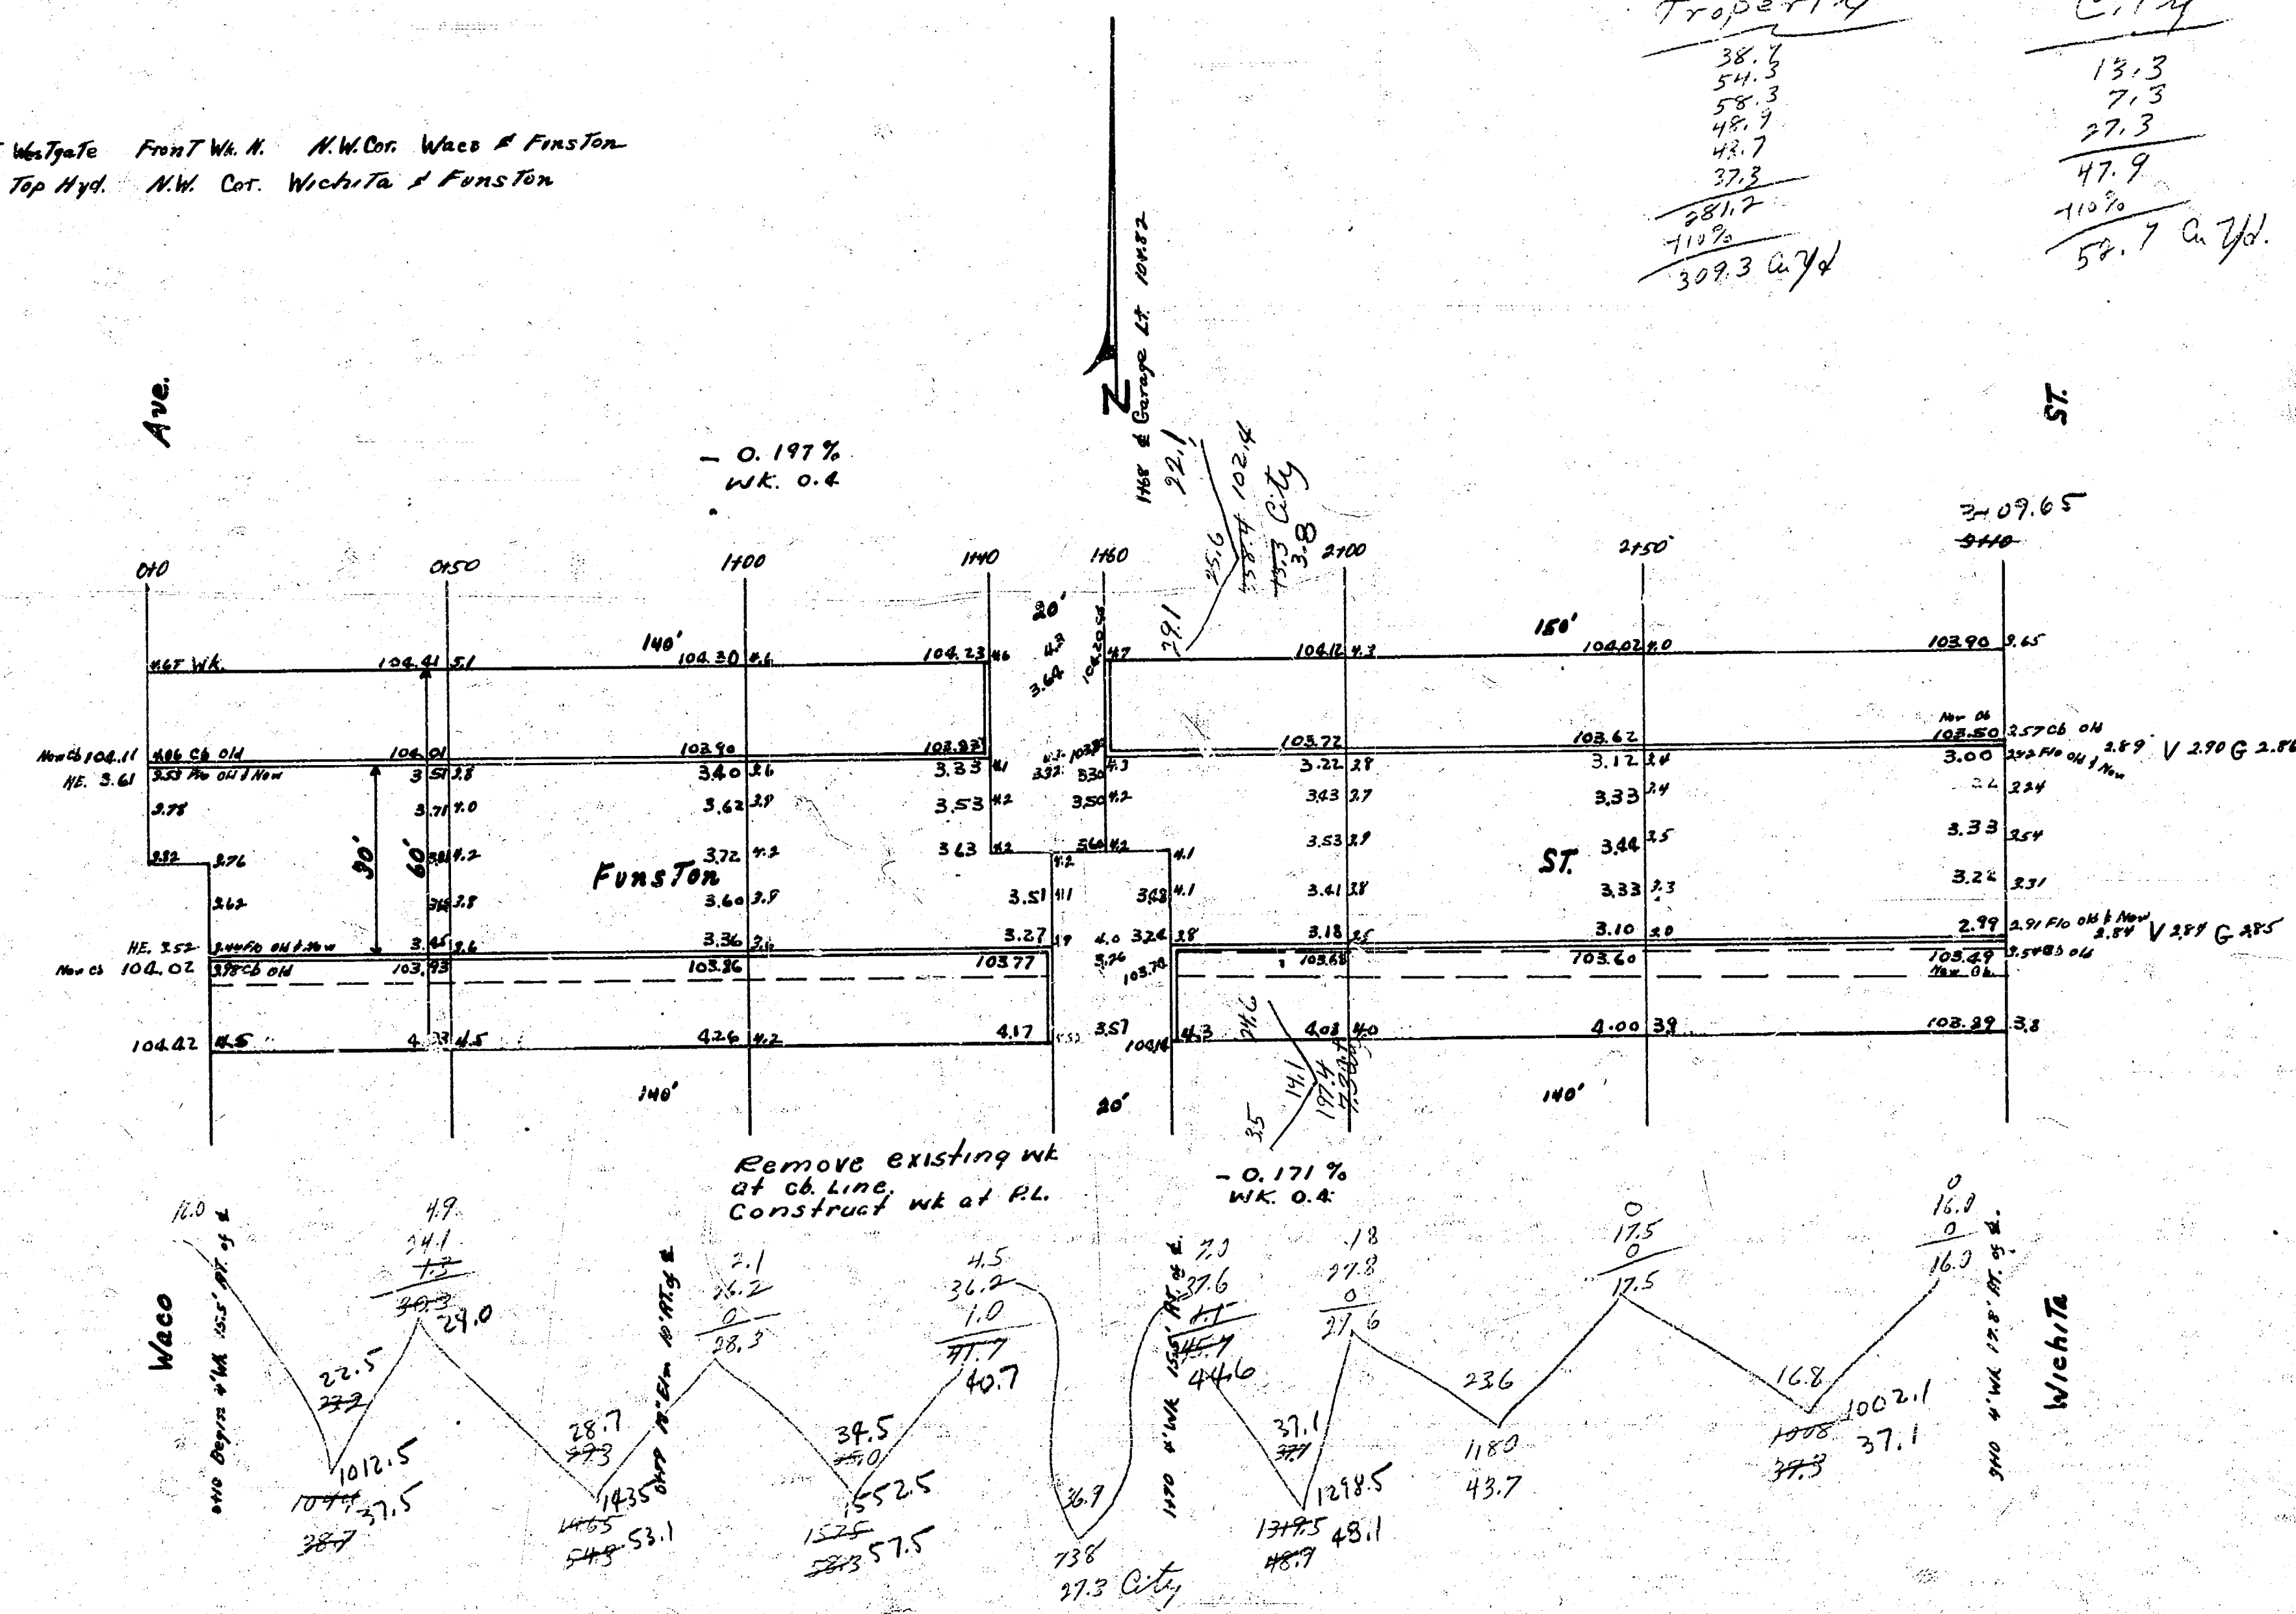

Funston ST.
E.L. Waco — W.L. Wichita
30' Conc. + Cb.
City of Wichita, Kansas
L.M. White City Engineer
May 1948 Project C18-48

4 14 5 10