



BM. 155.22 S.E. COR. CONC. STEP HOLE 8' 8" SO. WOODLAWN

SCALE: 1" = 20'

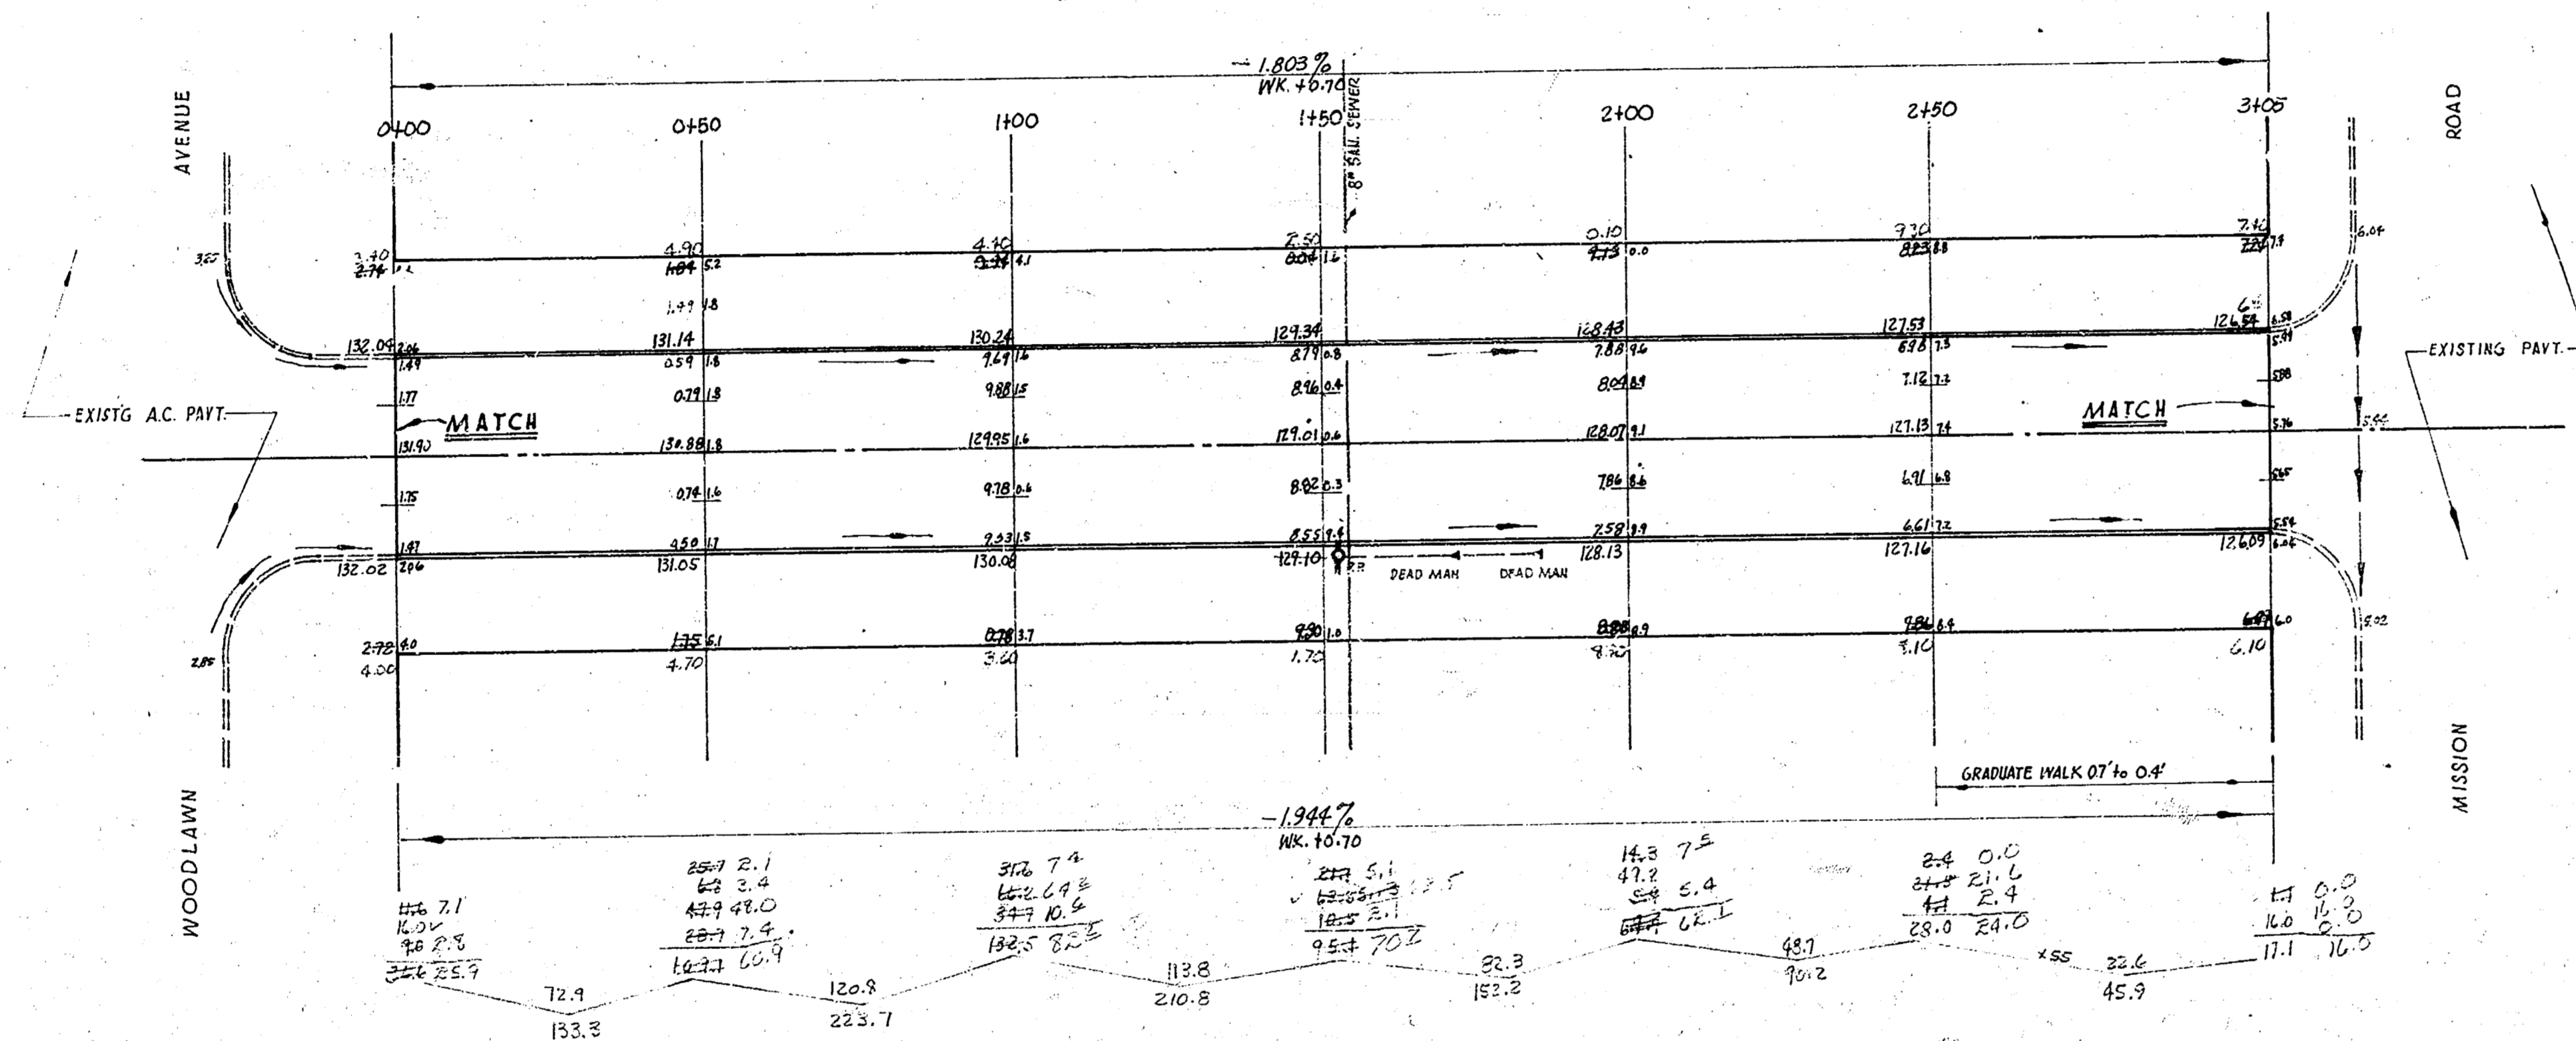

CHECKED BY: [Signature]  
 DATE: 8-22-58  
 DRAWN BY: [Signature]  
 DATE: 8-22-58  
 PROJECT: [Signature]  
 DATE: 8-22-58

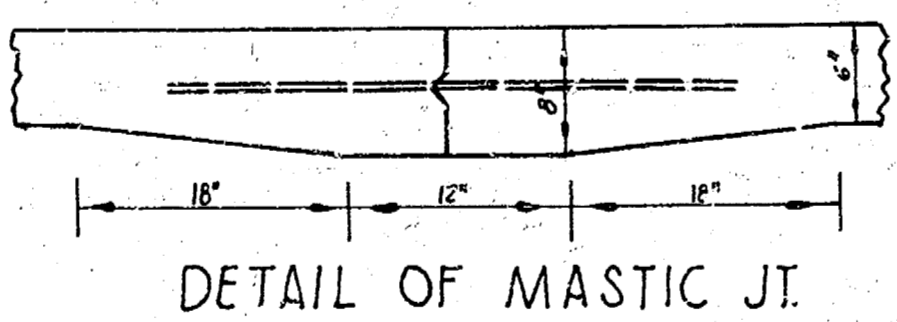

EXCAVATION TOTALS

PROP	CITY
856.1	0
+1078 85.6	
941.7 CK	0 CK & E SMITH

**FUNSTON AVENUE**  
 EL. WOODLAWN AVE. - 1/2 MI. MISSION ROAD  
 30' CONCRETE + CB  
**CITY OF WICHITA, KANSAS**  
 D.E. SMITH CITY ENGINEER  
 DATE: Sept. 1958 PROJ. NO. C12-261

