


B.M. 10321 Top W Edge of part of Geo Wash Blvd, S.L. Aloma
 Note: Stationing is on E.P.L.

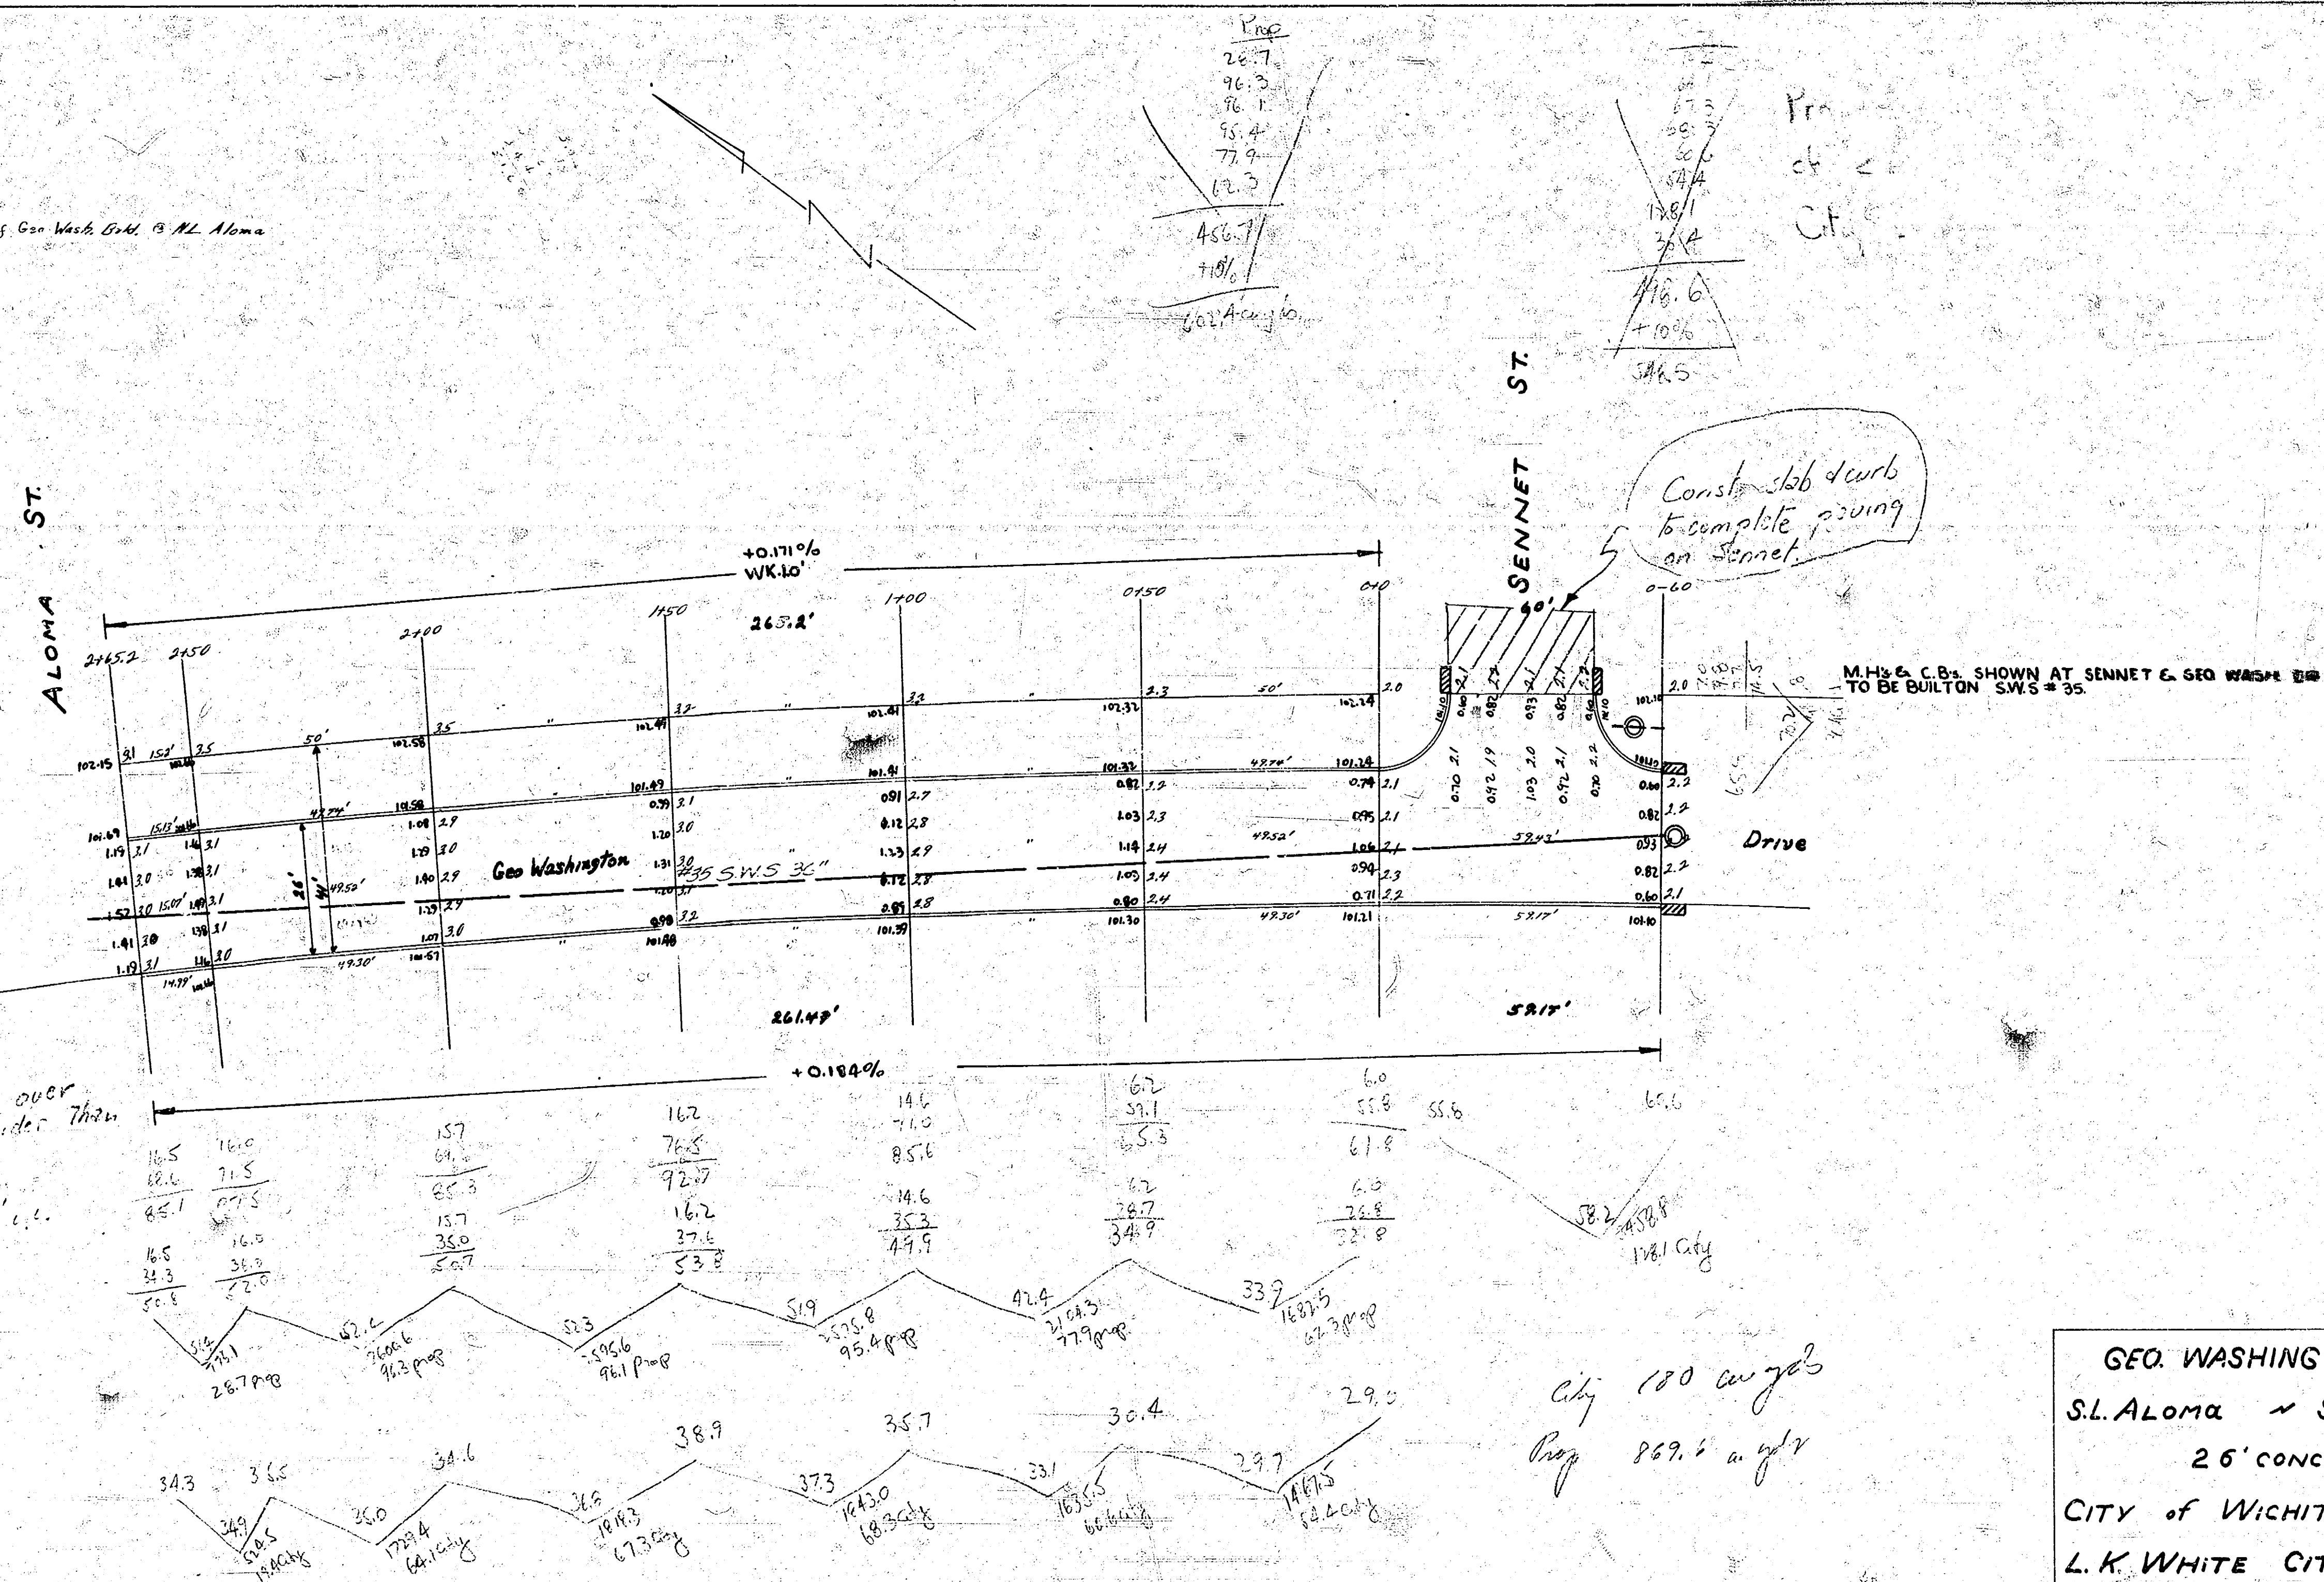

GEO. WASHINGTON DR.
 S.L. Aloma ~ S.L. SENNET
 26' CONC. CB.
 CITY OF WICHITA, KANSAS
 L. K. WHITE CITY ENGINEER
 JUNE 1943 PROV. NO. 19-87