
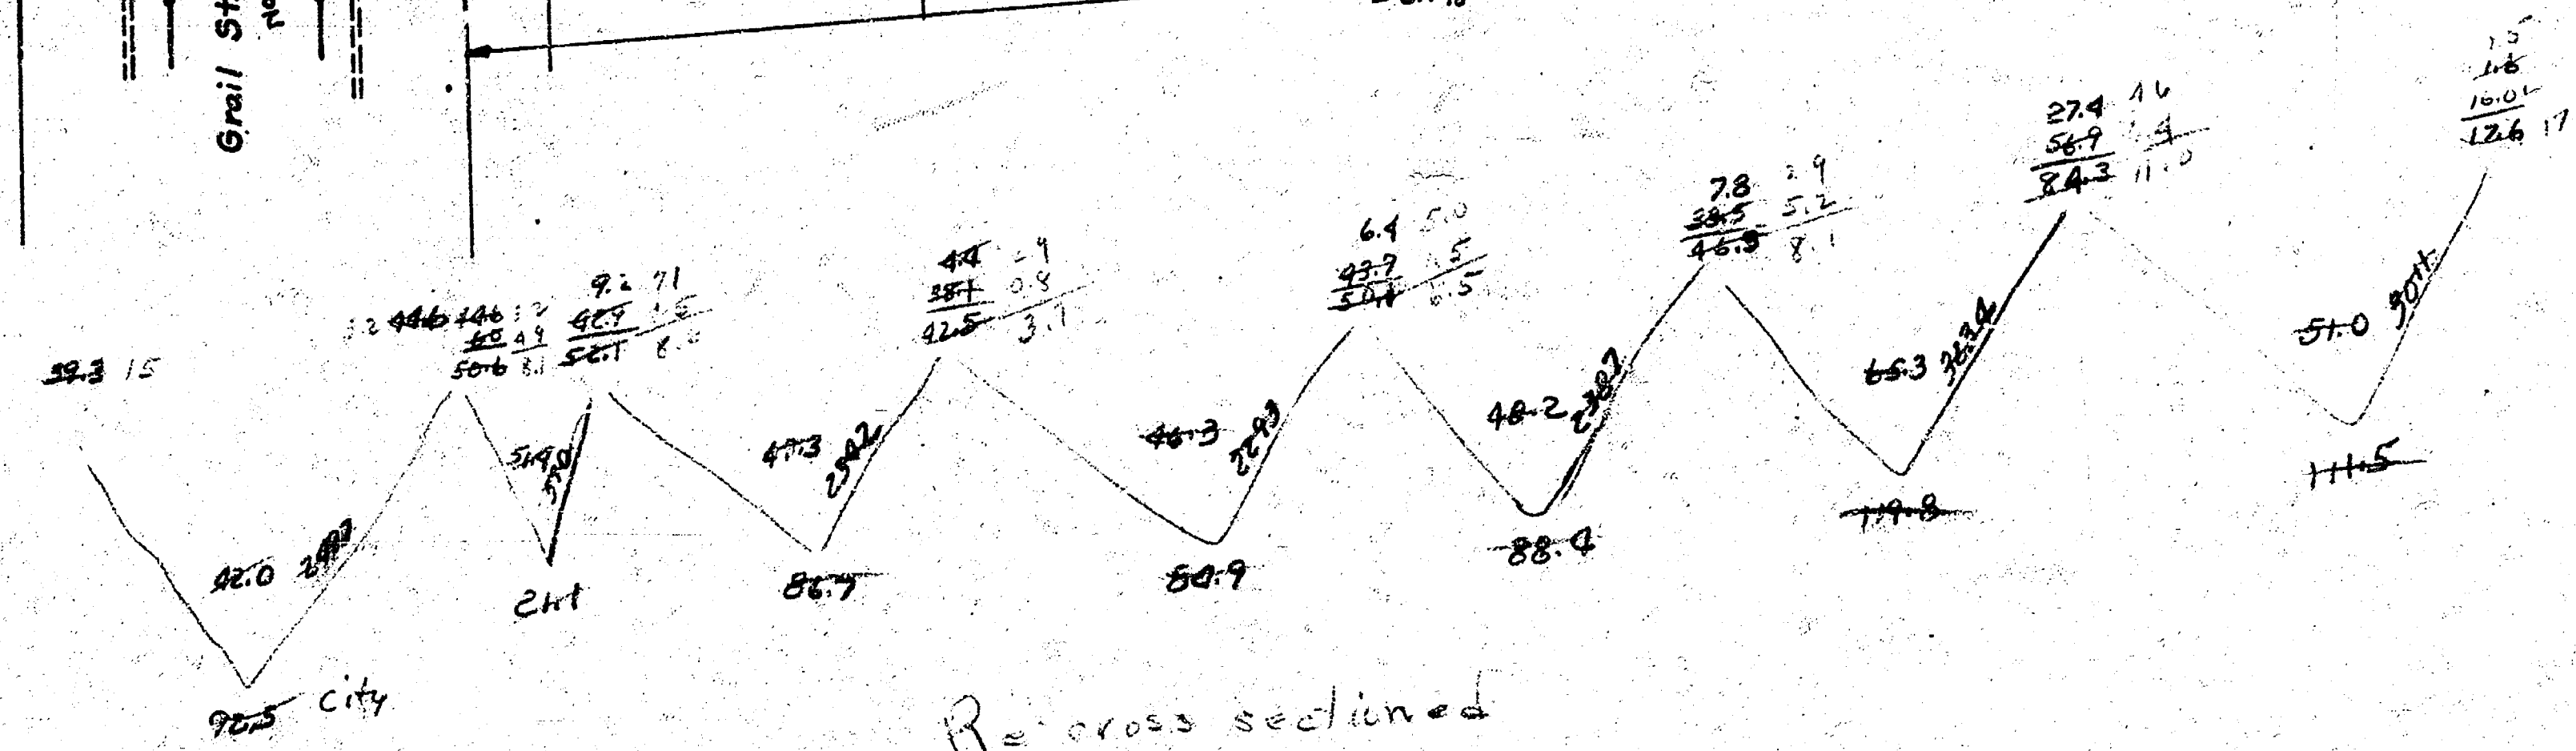


BL 52 Y'


Property	City
81.1	92.5
86.7	19.7
84.9	8.0
88.4	15.9
119.8	7.0
111.5	138.1
512.4	

Property Excavation
 +10% 512.4
 -10% 512.4
 Total 512.4 cu yds.
 City - 138.1
 13.8
 151.9 cu yds.

BM 104.25 "M" in Mueller Fireplug west side Geo. Washington Dr. @ Sennet.
 NOTE: Property pays for all of 26' slab. City pays for intersection.

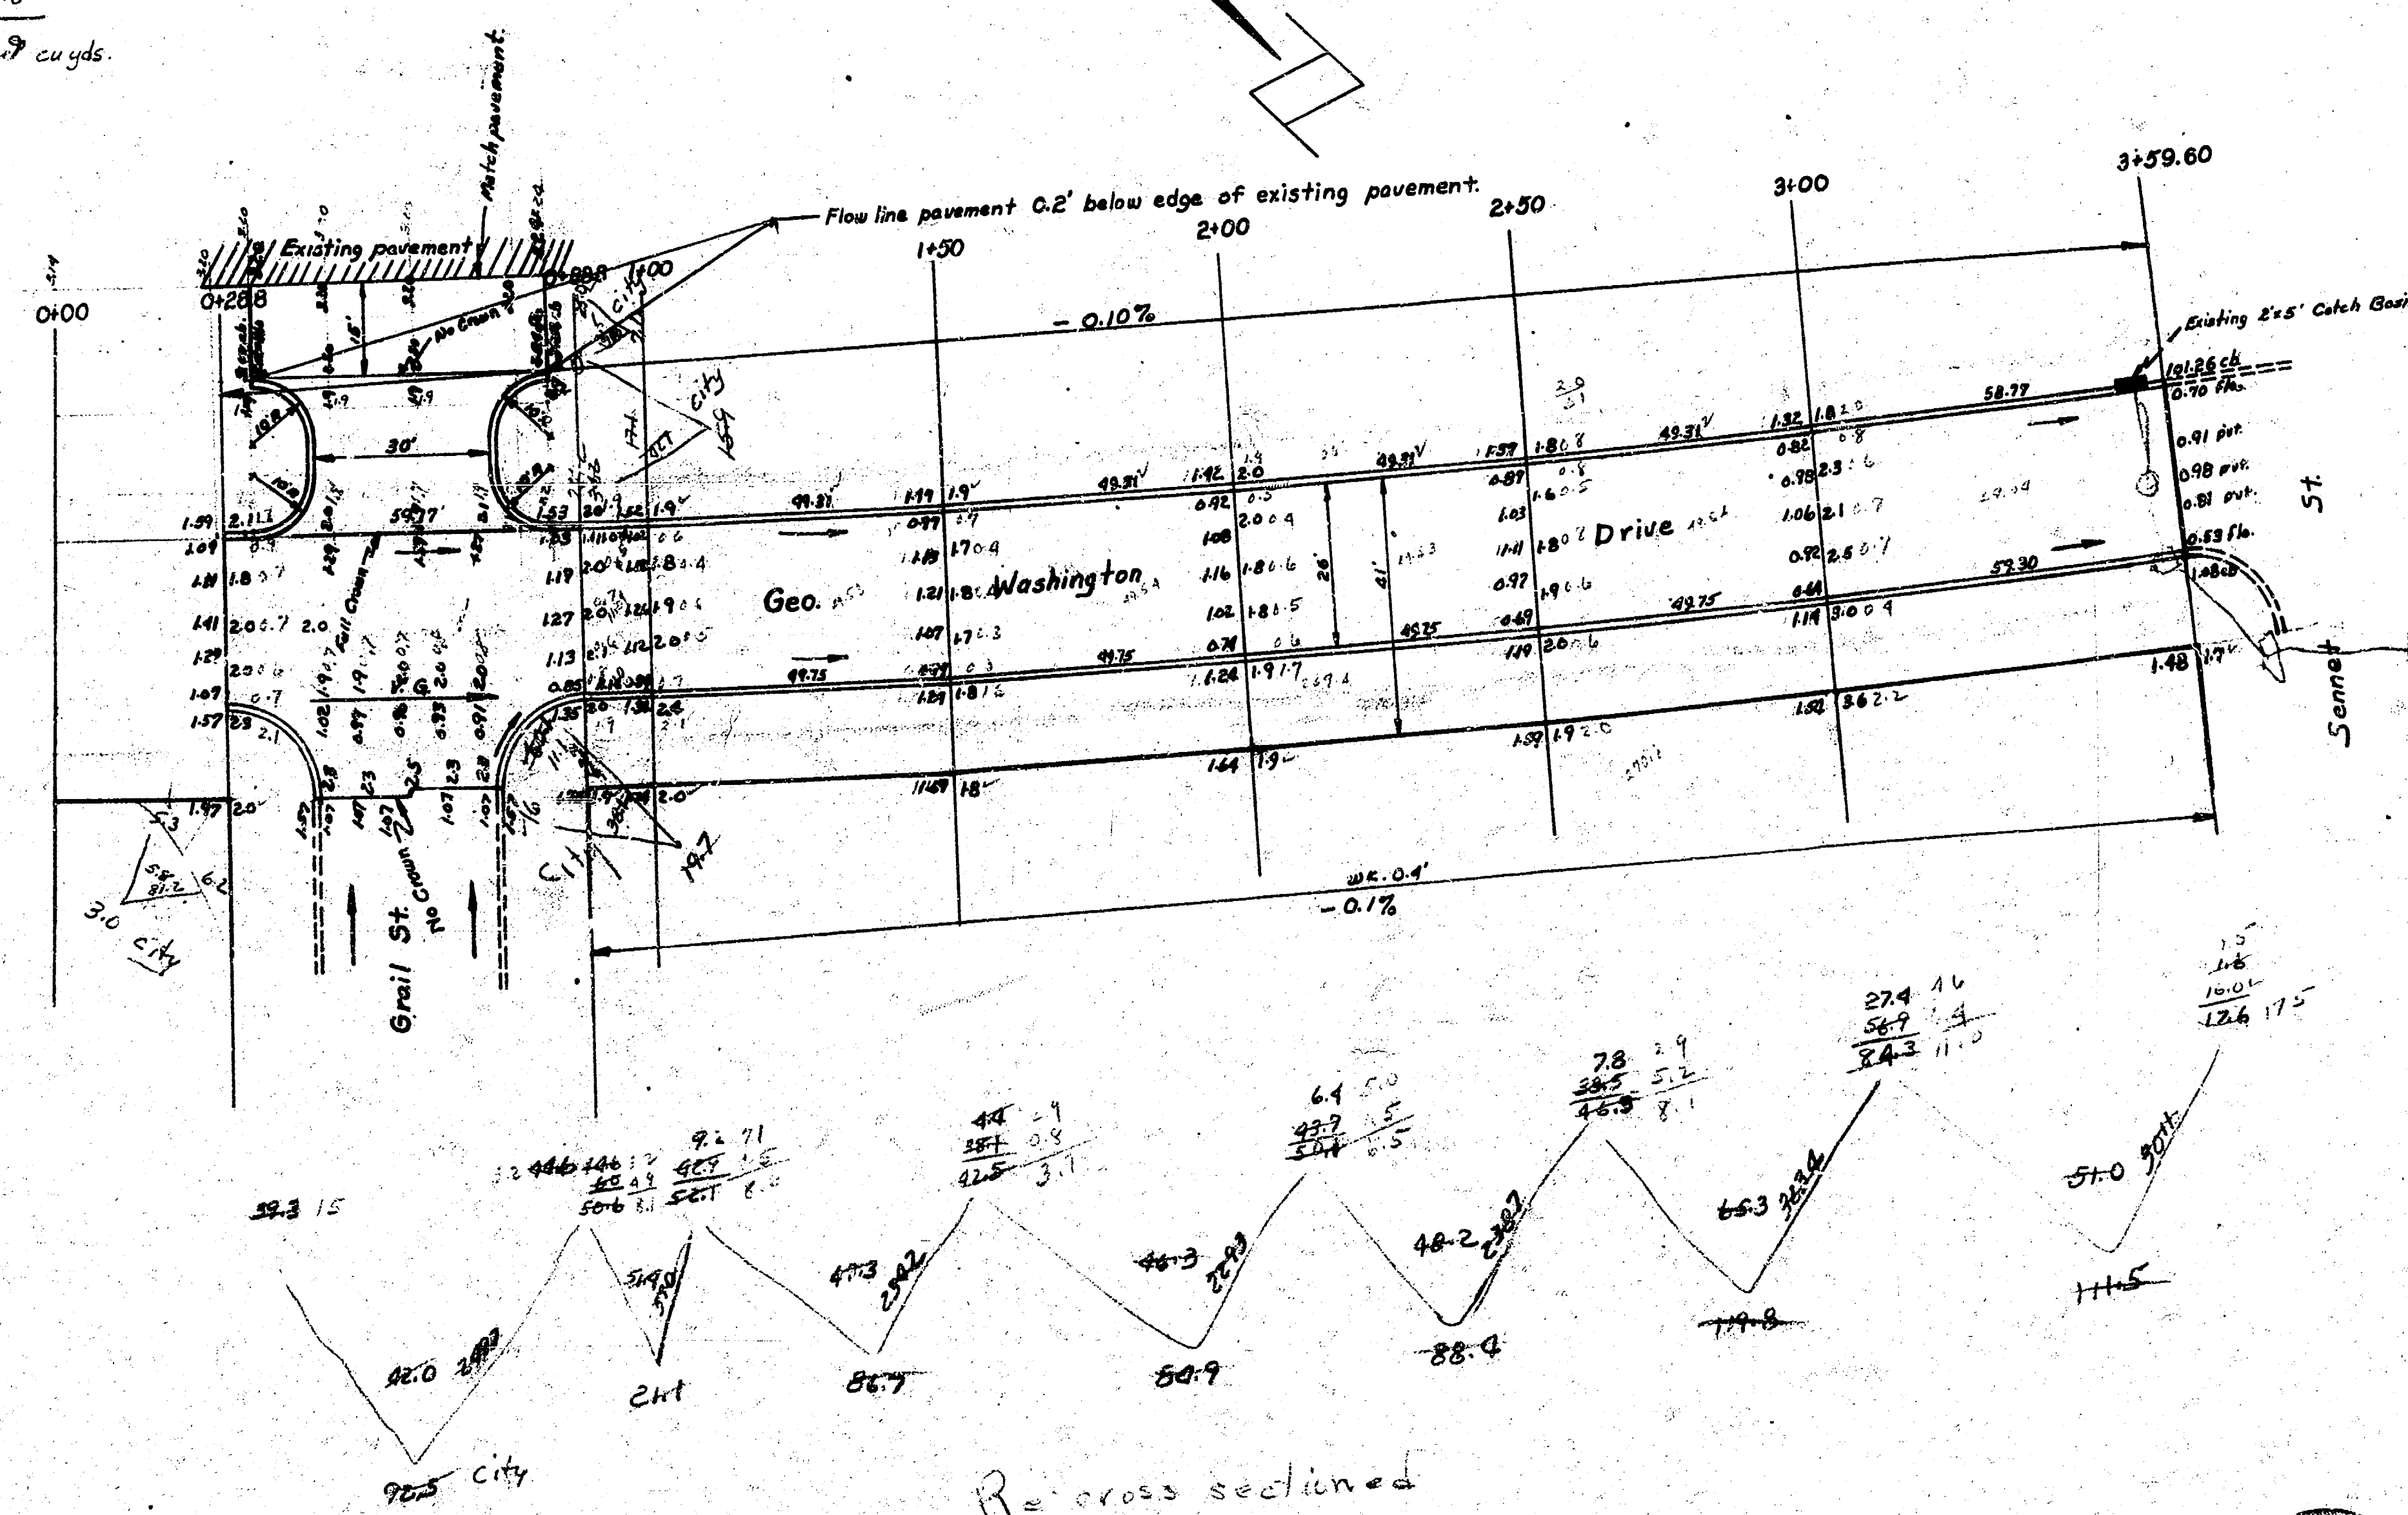

Geo. WASHINGTON DRIVE
 SL. Grail St to SL. Sennet St
 26' Conc. & Cb.
 City of Wichita, Kansas
 L. K. White City Engineer
 January 1951 Proj. No. C-10-114.

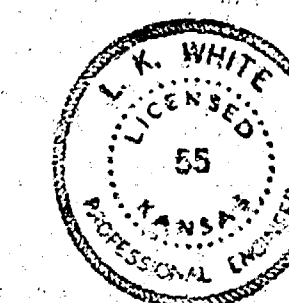

4 3 5 (51)