B.M. 103.87 W.L. Geo. Wash. Ave & Mesita "O" in Globe So. Cb.
B.M. 109.10 Geo. Wash. Blvd. & N.L. Rivera "X" on W. Edge Pvt.

REMOVE EXISTING C.B. & GTR. & REPLACE TO GRADES SHOWN ON PLAN.

+0.13% WN 0.4'

+0.149%

LINCOLN ST

GEORGE WASHINGTON

EXISTING DRIVE TO REMAIN

6" DRIVE

DRIVE

MESITA DRIVE

0+00 0+50 1+10 1+50 2+10 2+50 3+10 3+50 4+10 4+50 5+10 5+50 5+90

Prop 17.9 17.1 16.6 15.8 15.9 16.0 15.5 15.5 15.5 16.4 12.2 12.3 169.2 +12.0 181.2 cu yds

City 15.1 15.3 15.3 16.7 17.0 16.0 16.0 15.6 15.5 15.5 10.5 12.2 12.3 169.8 +12.0 181.8 cu yds


TOTALS

Prop 1.1.8 333.9

City 1.1.3 334.3 555.4

GEORGE WASHINGTON DRIVE
S.L. LINCOLN TO N.L. RIVERA
ASPHALTIC CONCRETE 22-2-26
CITY of WICHITA, KANSAS
L.K. WHITE CITY ENGINEER
NOV. 1946

1/2

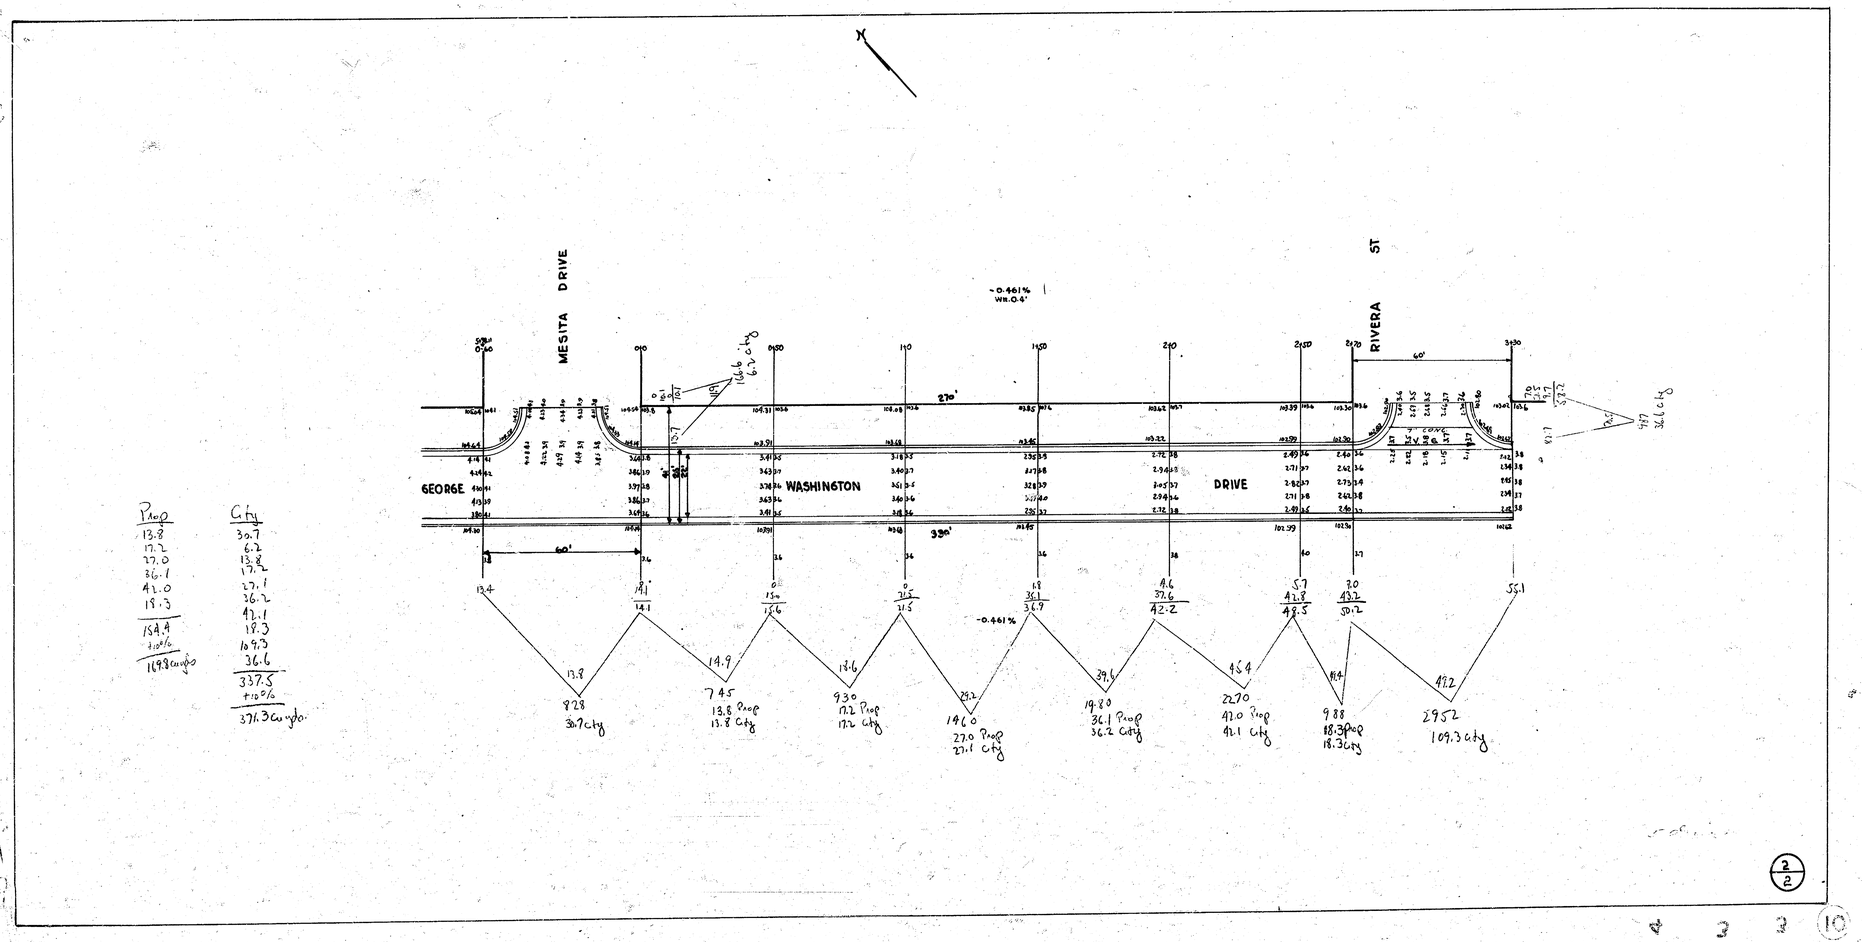

Prop
13.8
17.2
27.0
36.1
42.0
18.3
154.4
+10%
169.8 cu yds

Cty
30.7
6.2
13.8
17.2
27.1
36.2
42.1
18.3
109.3
36.6
337.5
+10%
371.3 cu yds

2/2