


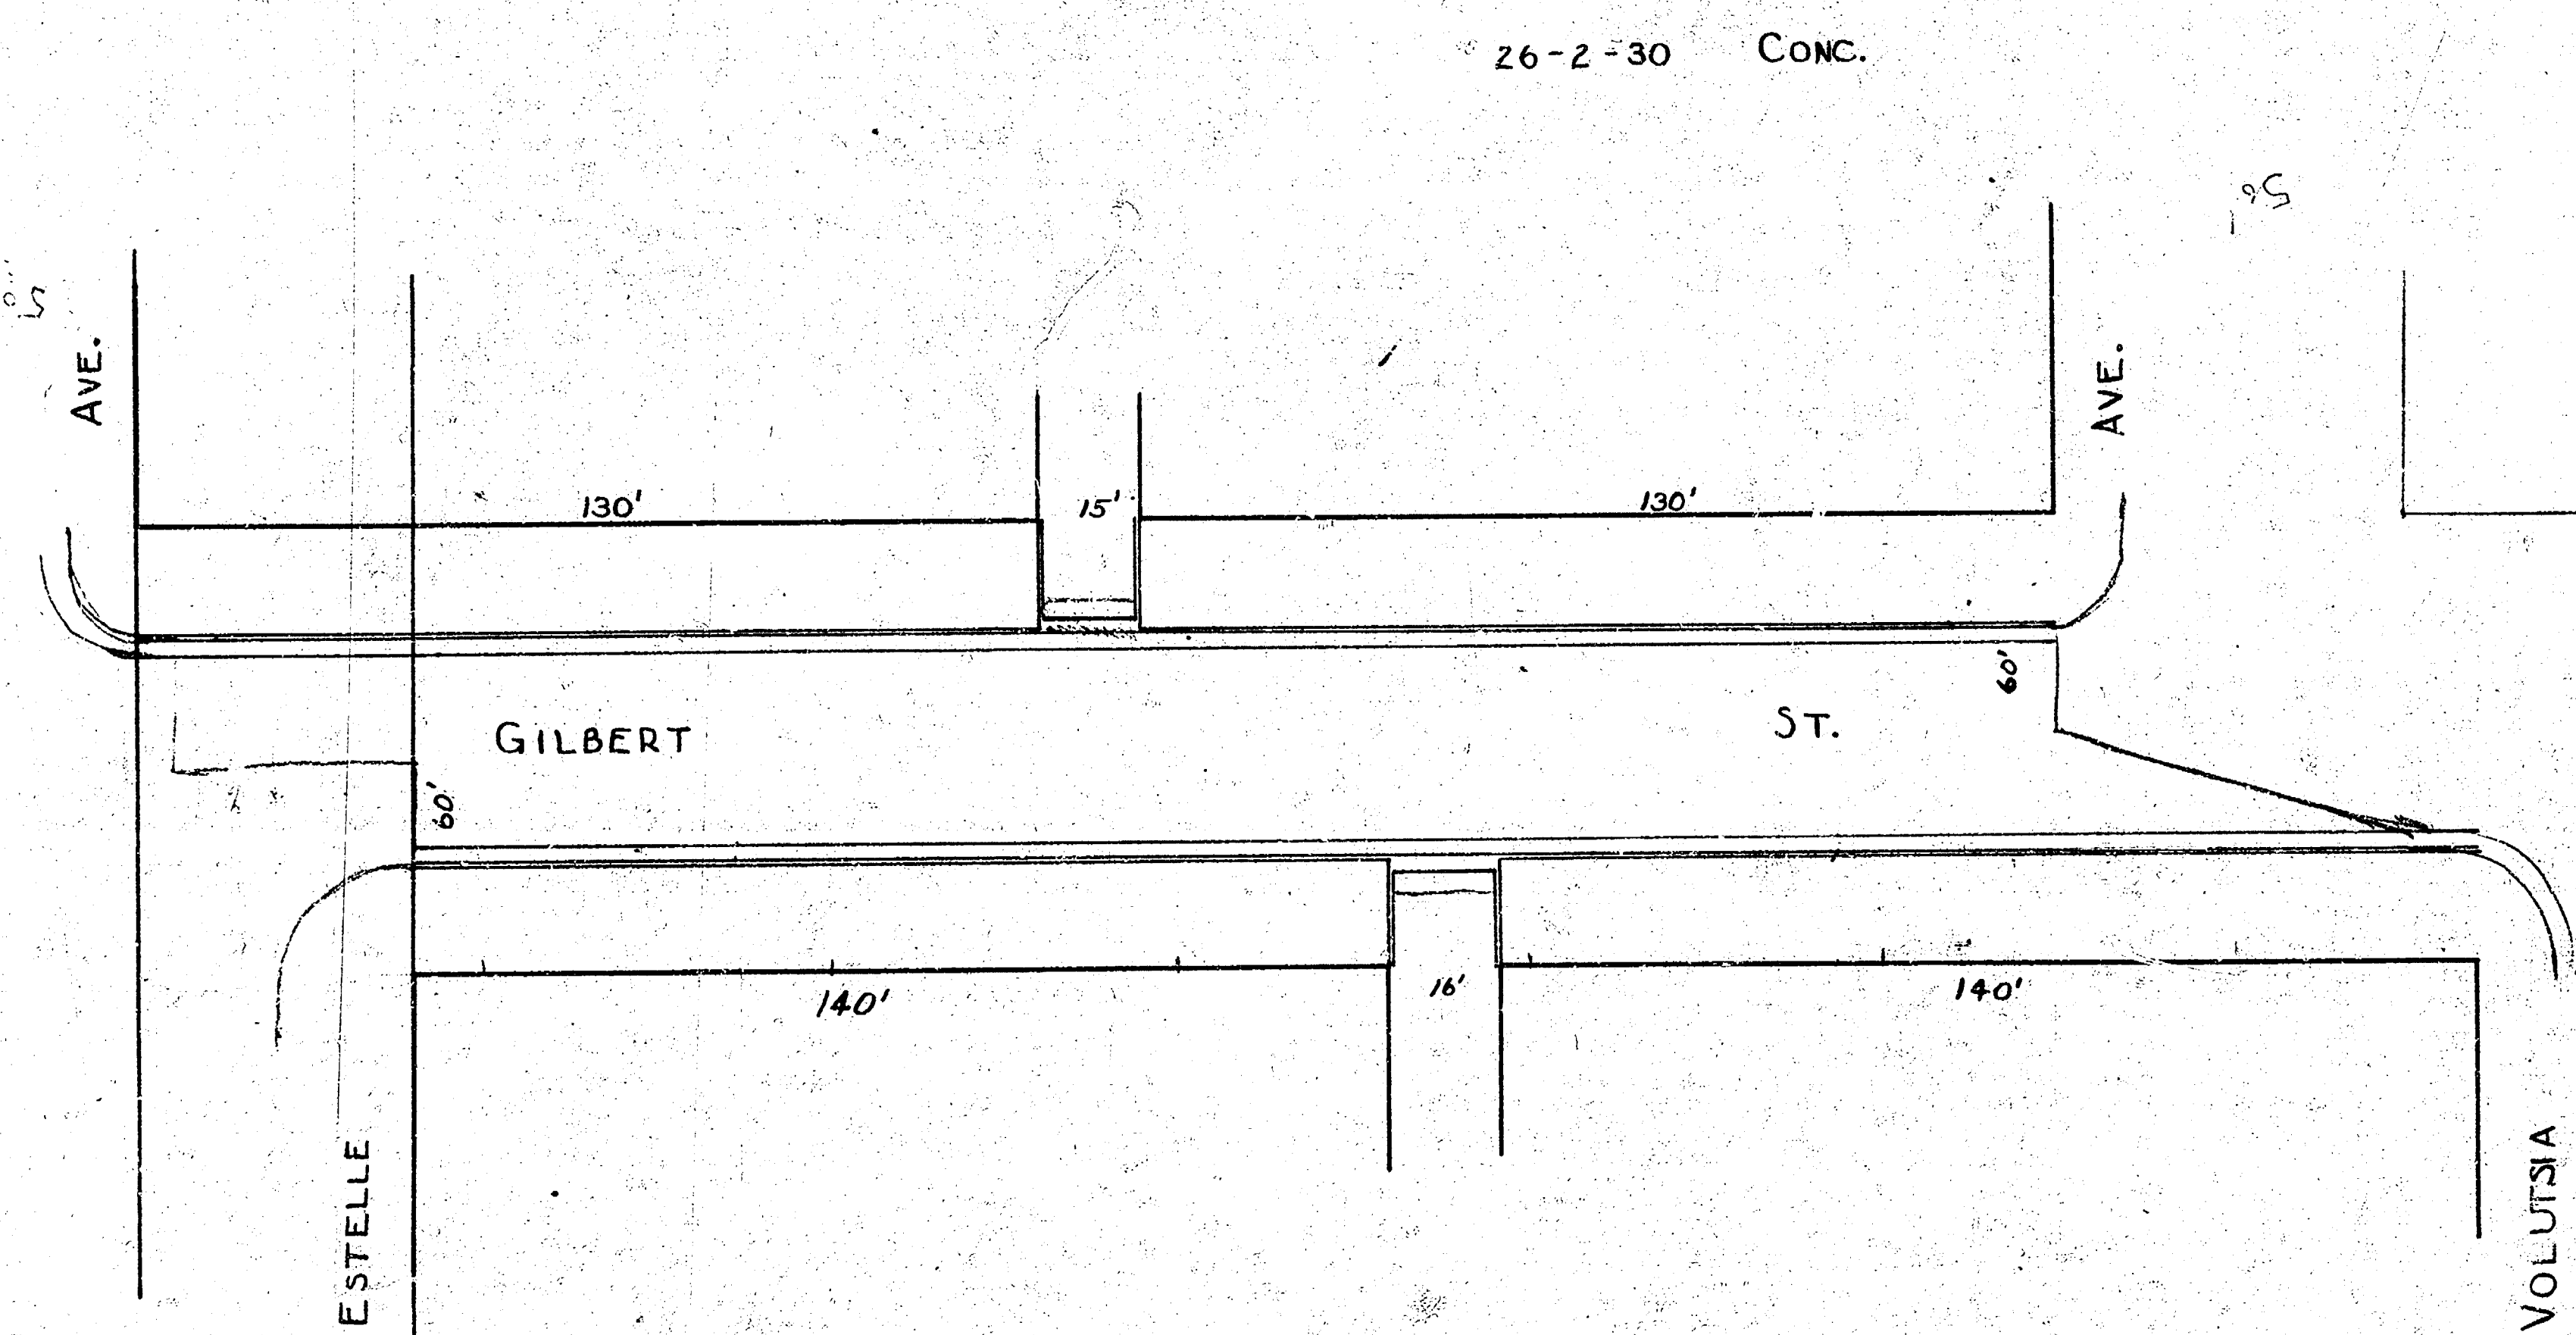


PAVED PLAN
1937
GILBERT
LL. Estelle
WL. Volutsa

Gilbert E.L. Estelle W.L. Volusia

30' E curb concr.

B.M. Elev. 105.79 "K" in Keeler Inter. SW Gilbert & Volusia
B.M. Elev. 106.21 W of Volusia NPL Morris.

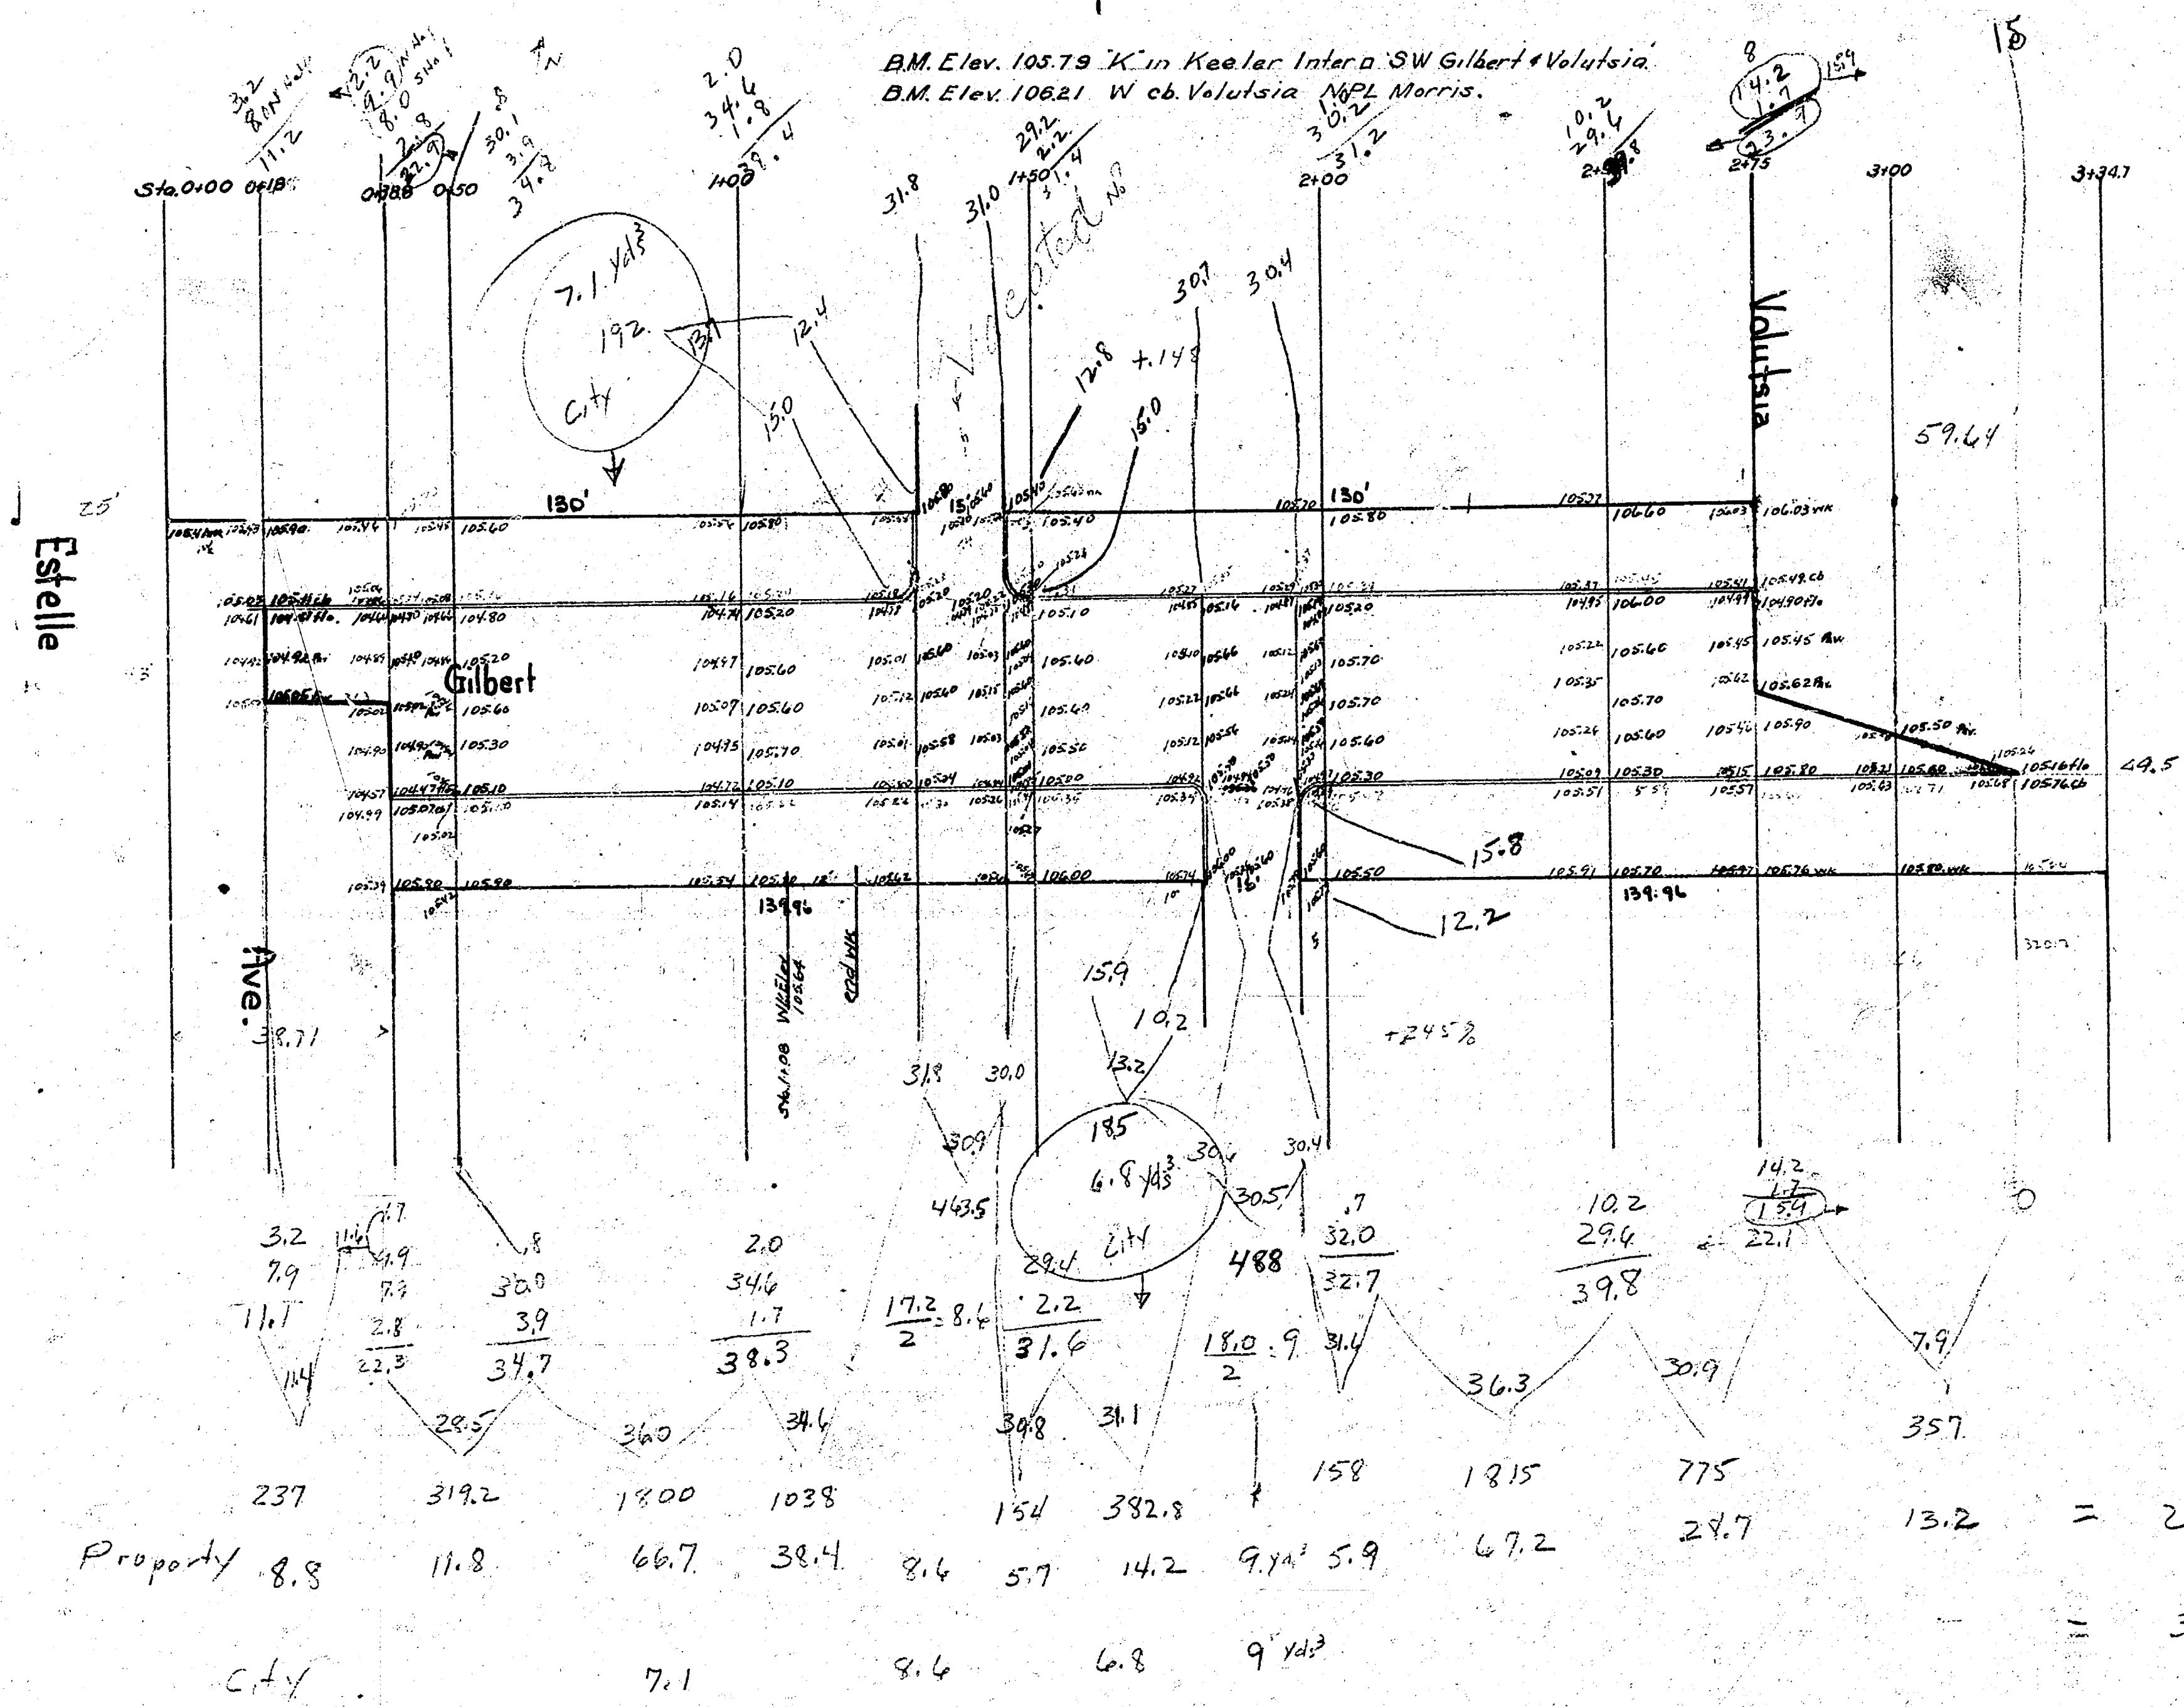

Survey Plan
1940
Gilbert St.
E.L. Estelle
To
W.L. Volusia