




481



(2)  
2

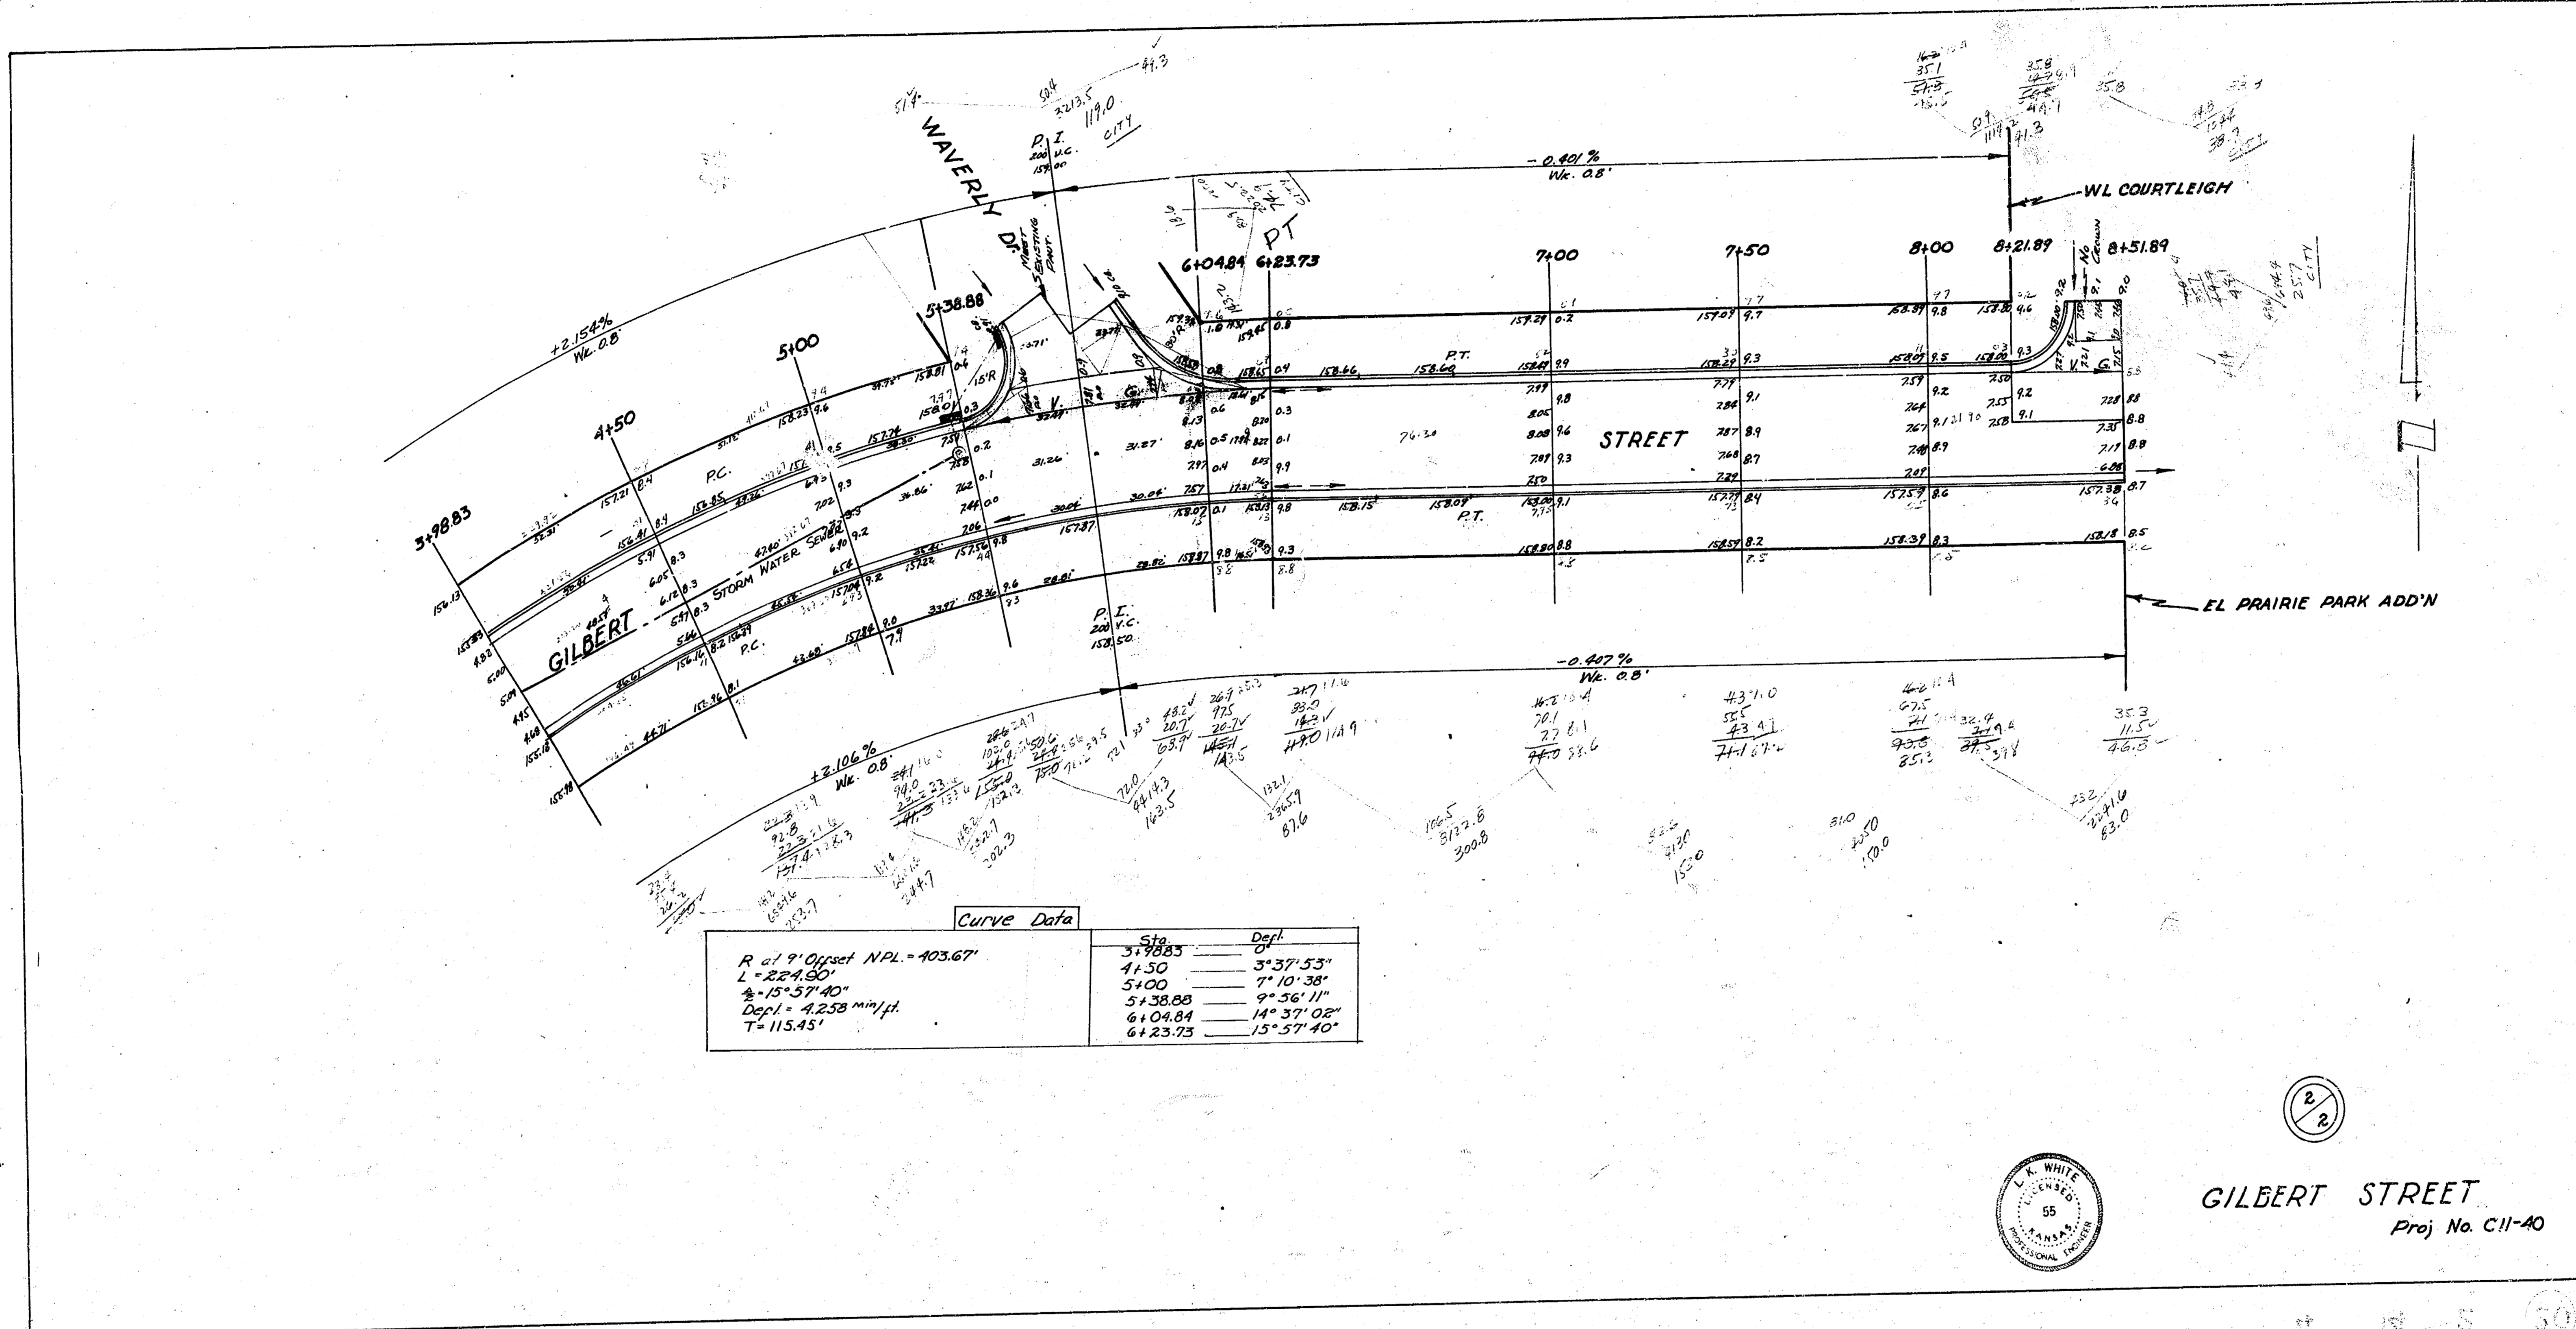

GILBERT STREET  
 Proj No. C11-40

4 7 5 30