
18Y

Exc.

Fur.	City
337.1	87.9
337.7	28.7
337.7	17.0
337.8	72.9
337.9	23.7
337.9	12.7
338.0	338.9
338.7	+10%
338.7	372.8
338.7	
338.7	
338.7

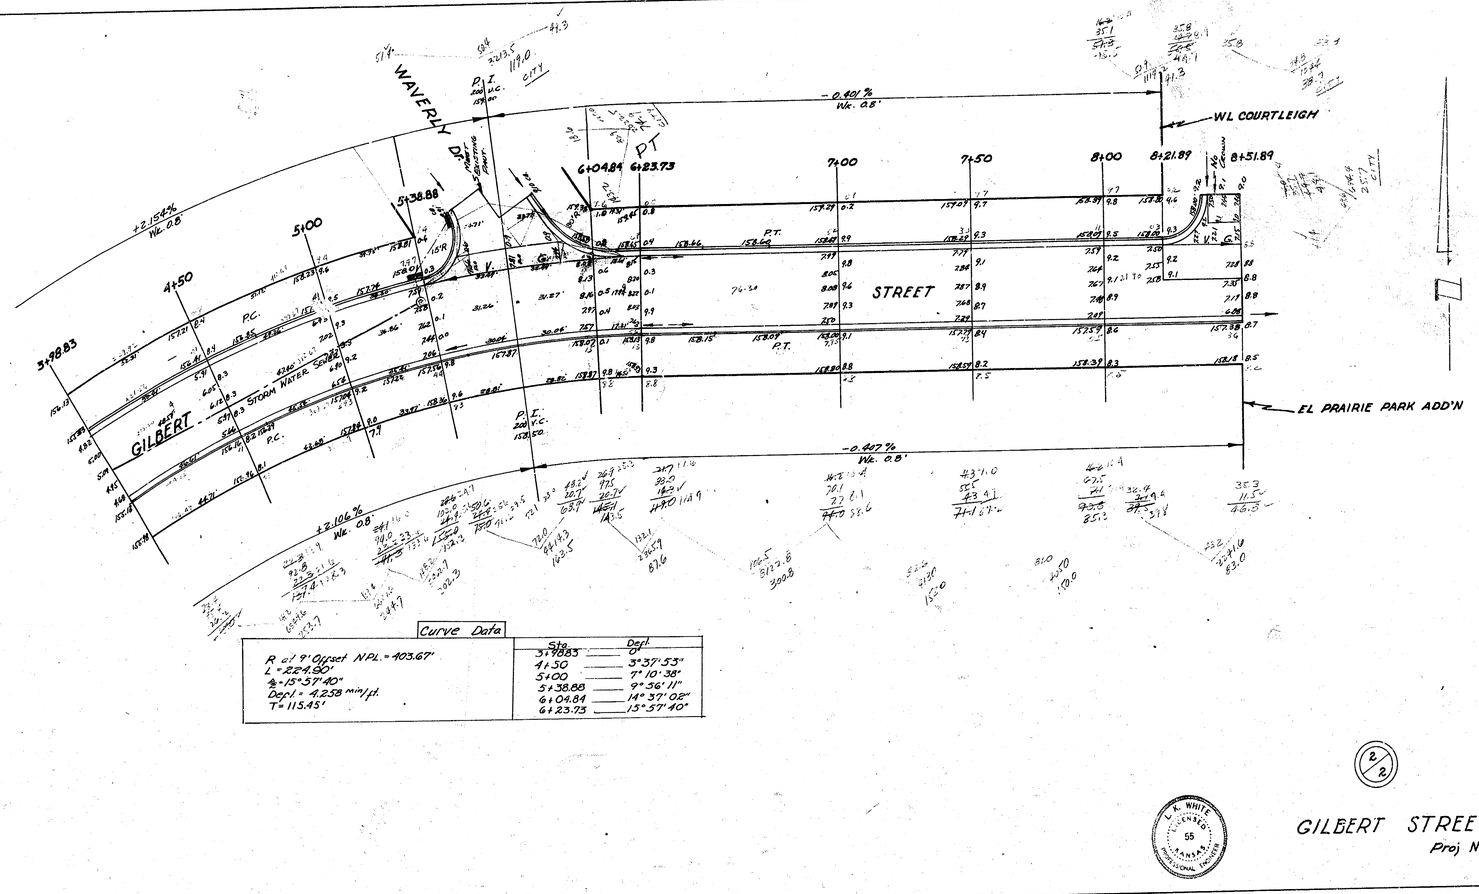

Curve Data

R of 9' Offset NPL. = 403.67'	Sta	Dep'l
	6+23.73	


(2/2)

GILBERT STREET

Proj No. C11-40