28-2-30 Conc.



Prop: 394.5 + 39.5 = 434.0 cu yds

Cut: 22.1 + 2.2 = 24.3 cu yds
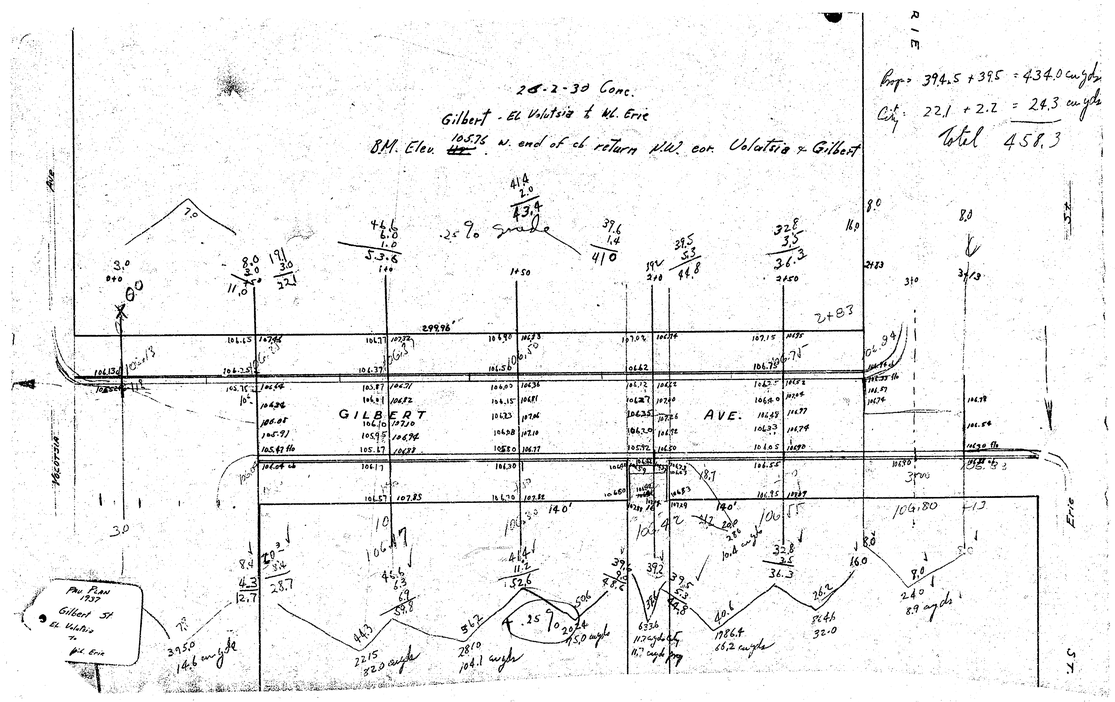
Total 458.3