


Note:  
 Take new sections on stations indicated  
 at Pt. E to E of paving when you  
 set cut stakes.

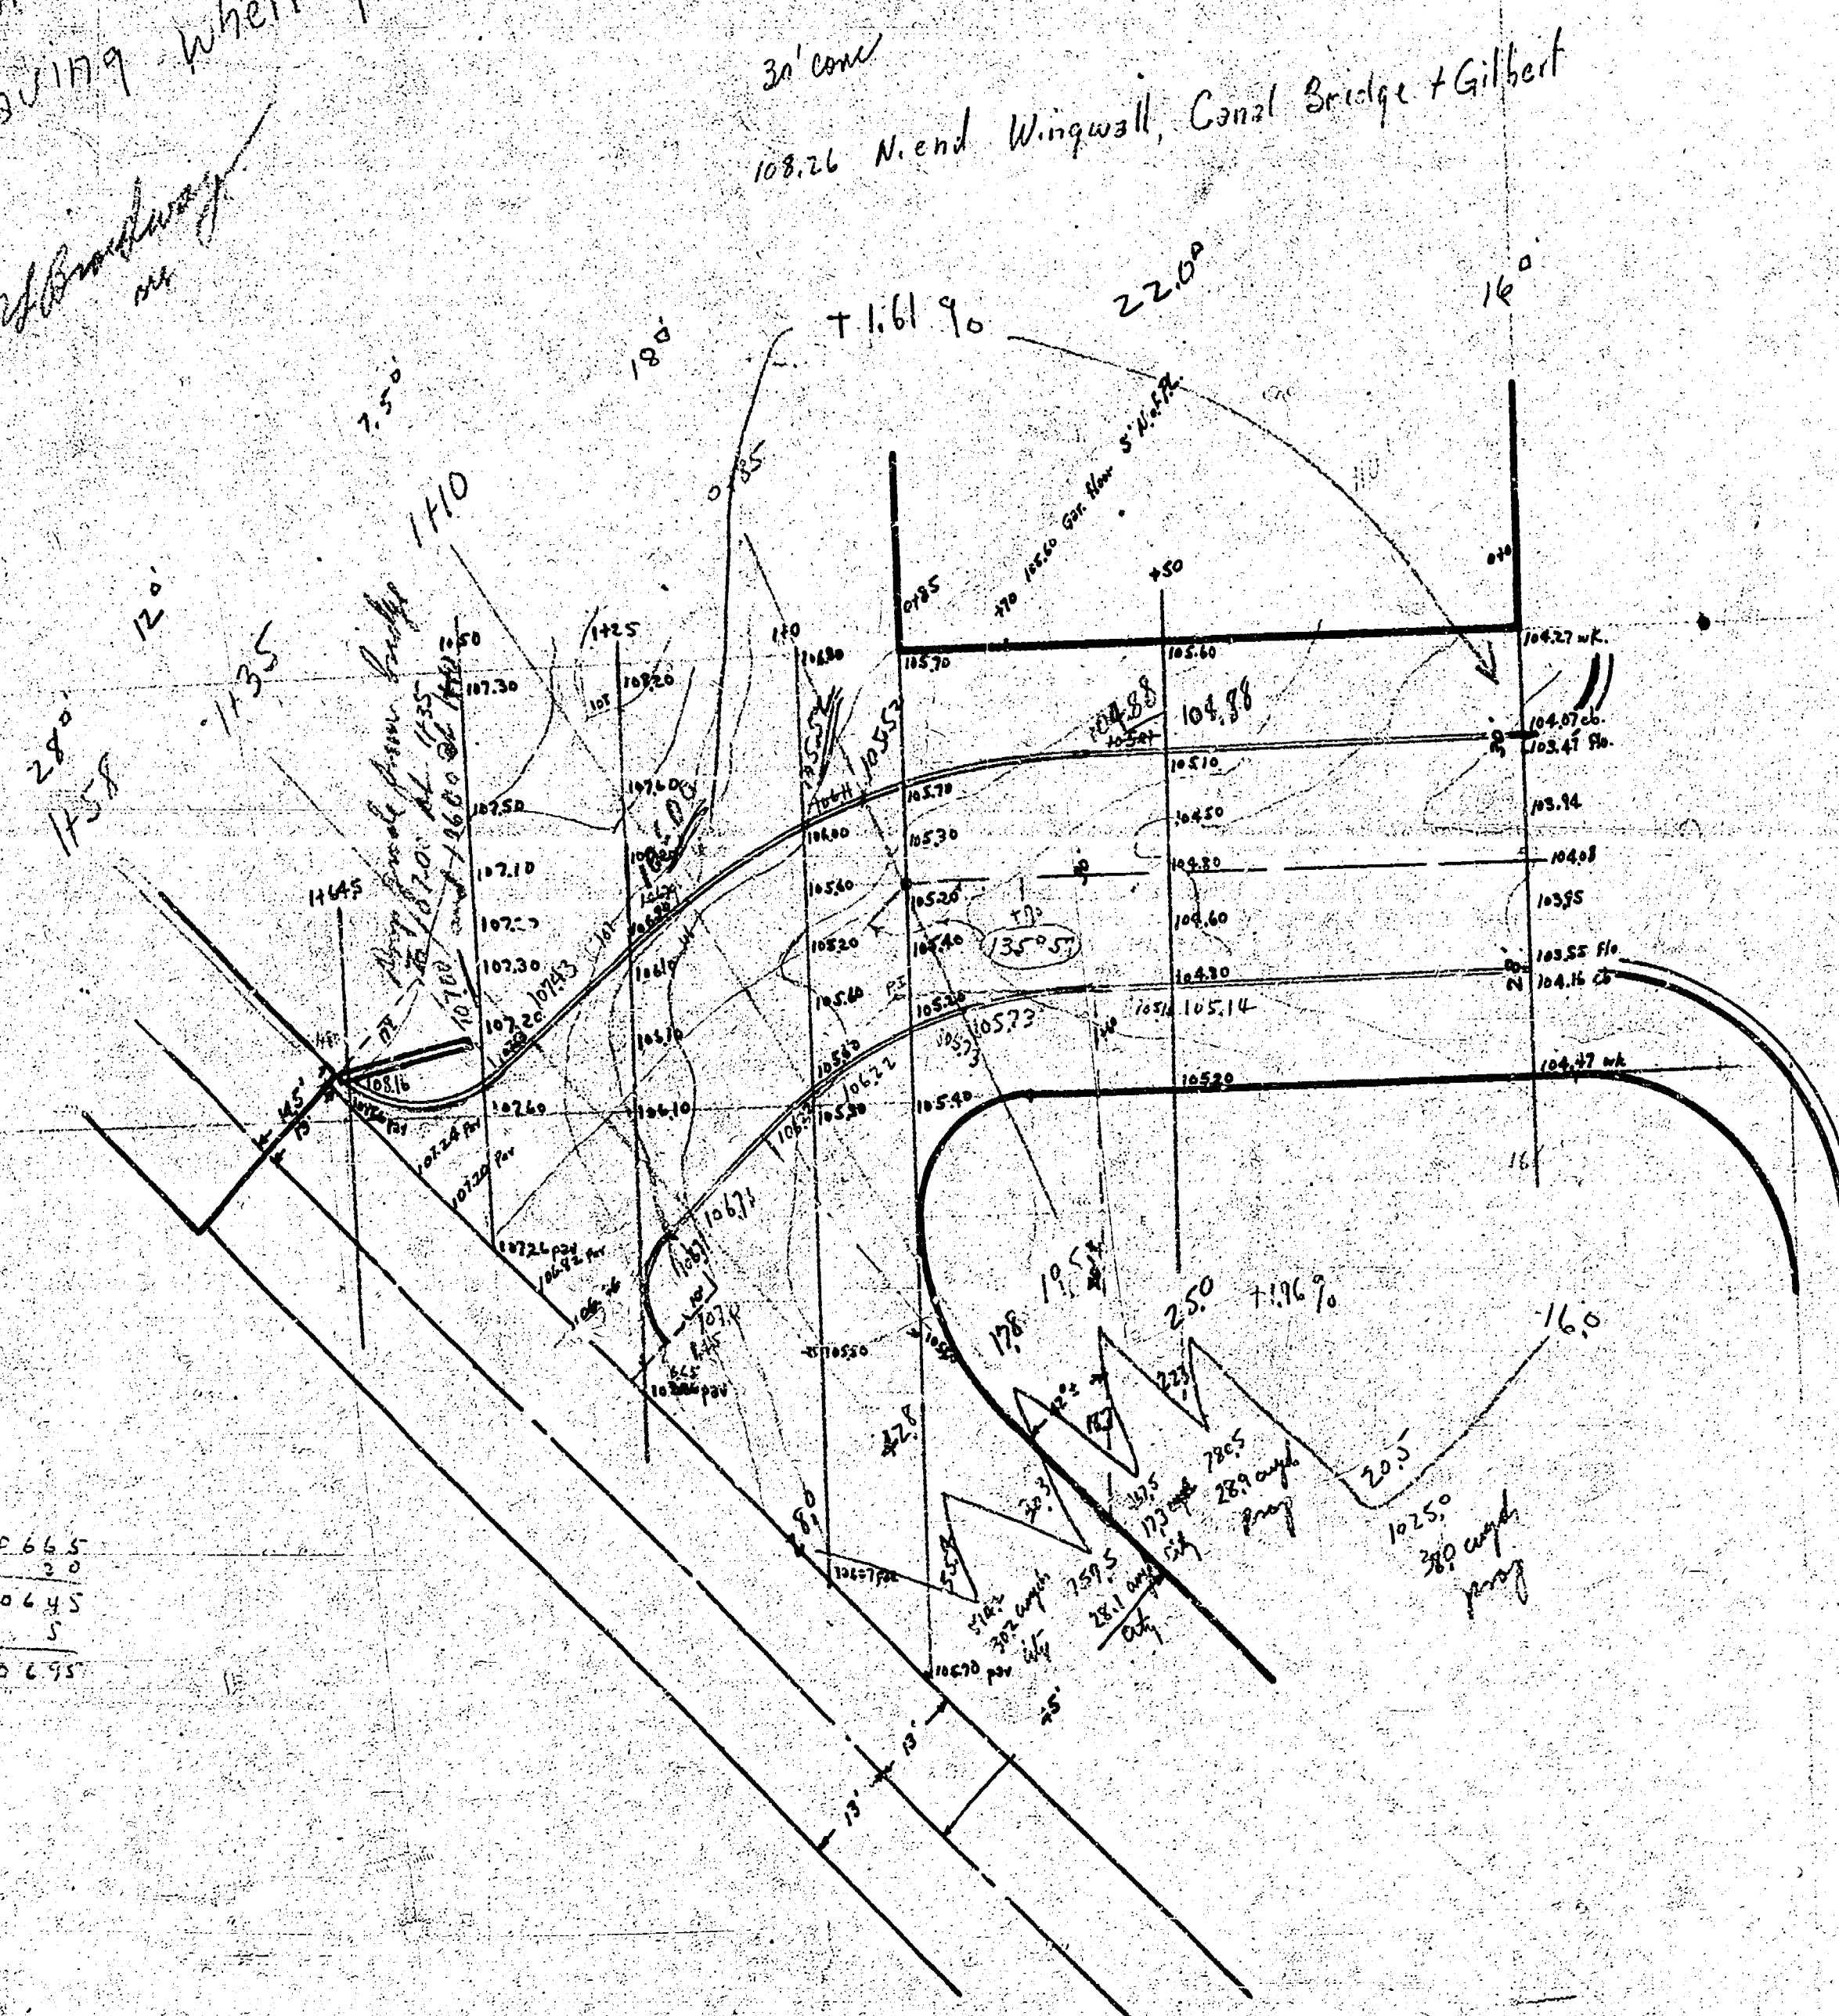

$Prq = 66.9 + 6.7 = 73.6 \text{ ay/b}$   
 $city = 75.6 + 7.6 = 83.2 \text{ ay/b}$

Paving Plan  
 1940  
 Gilbert St.  
 N.E. Ash  
 to  
 Glen-Hall Blvd.