



26-2-20 City

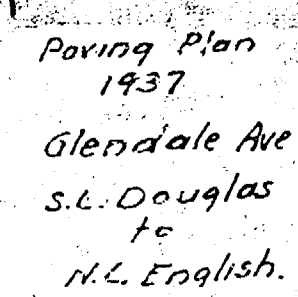

GLENDALE AVE. S.L. DOUGLAS to S.L. ENGLISH. 26' Conc.
 B.M. elev. 158.84 '6' in Globe E of Glendale N.E. English.

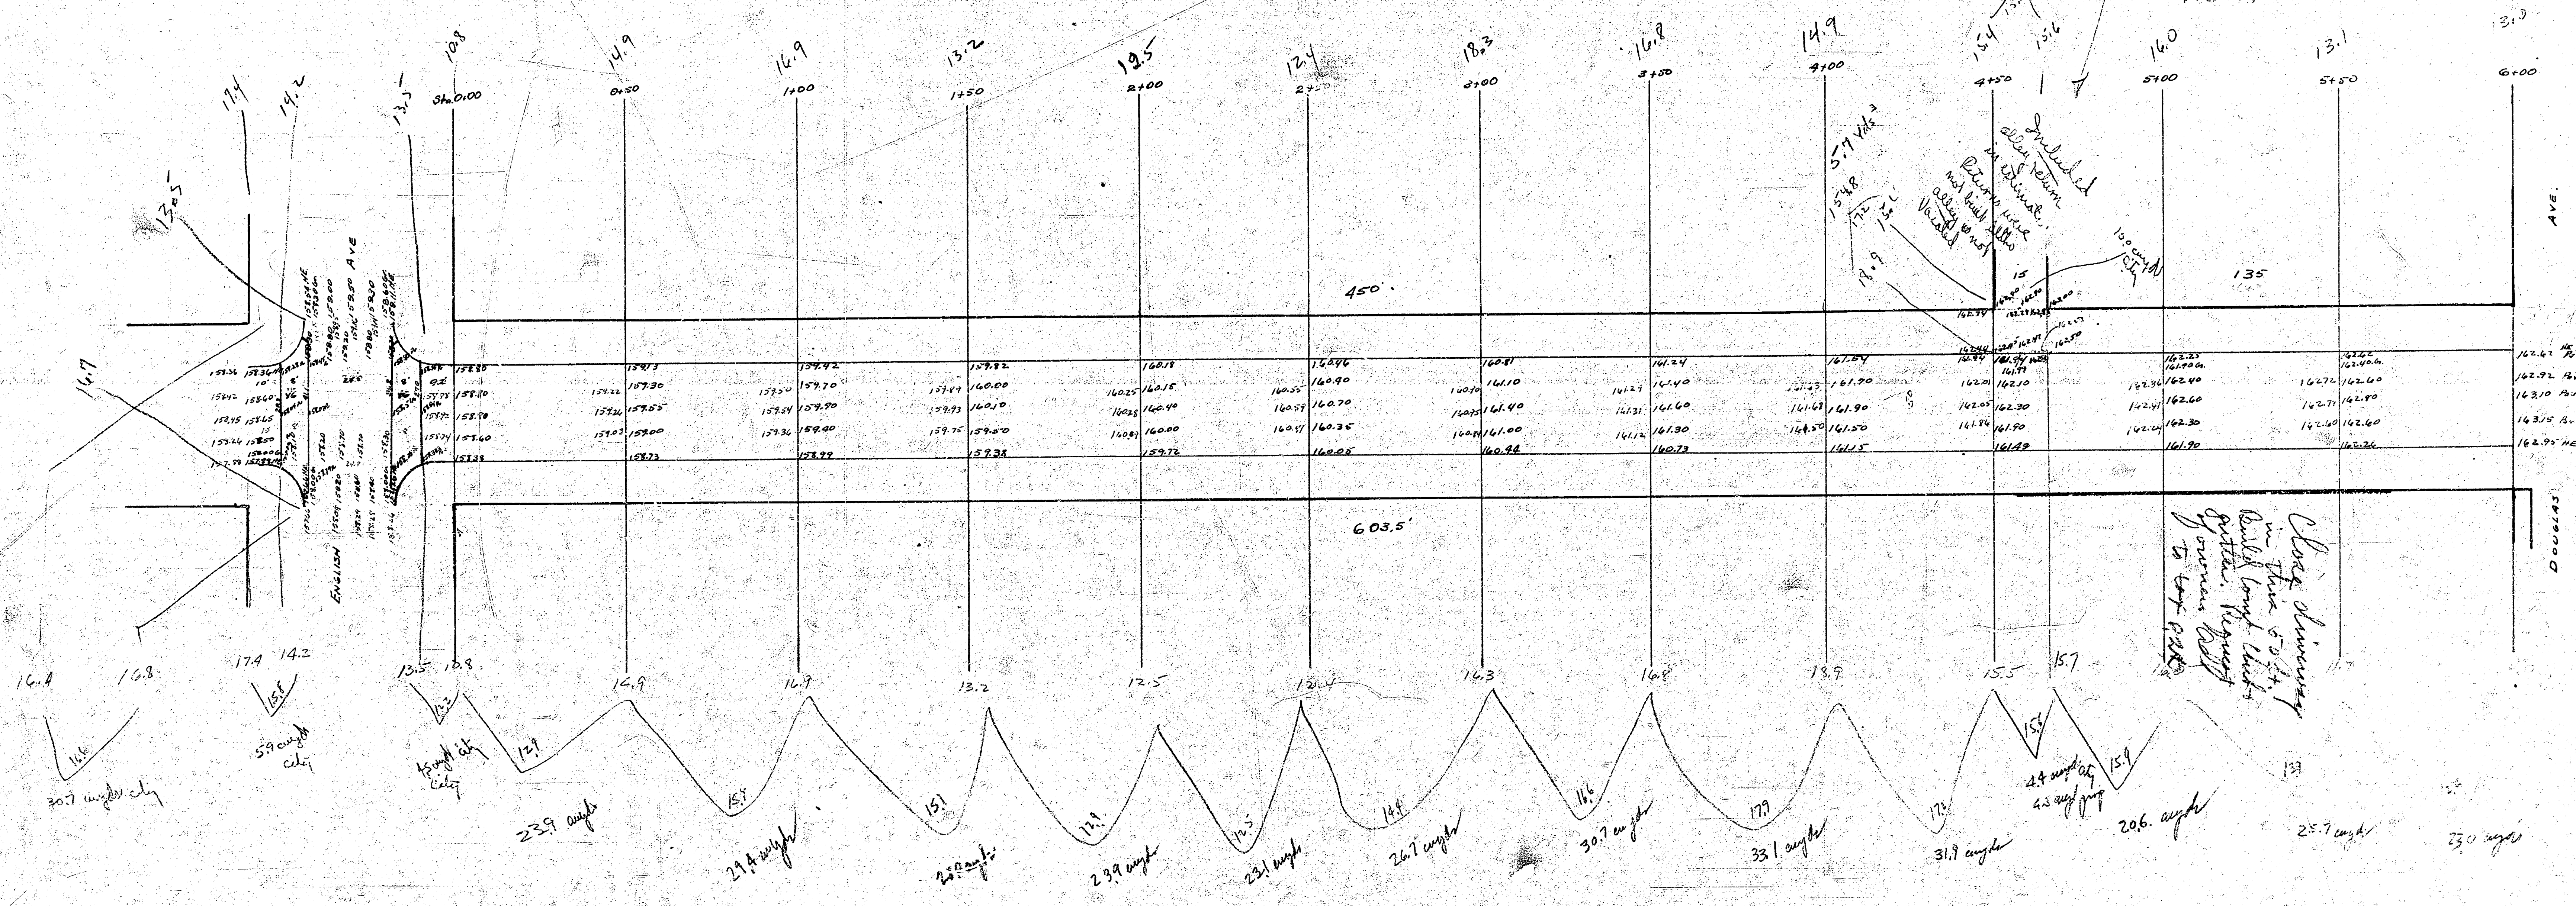

Prop 324.3 + 334 = 356.7
 City 55.5 + 55.5 = 61.1
 417.7

PAVING PLAN
 GLENDALE
 S.L. DOUGLAS
 S.L. ENGLISH
