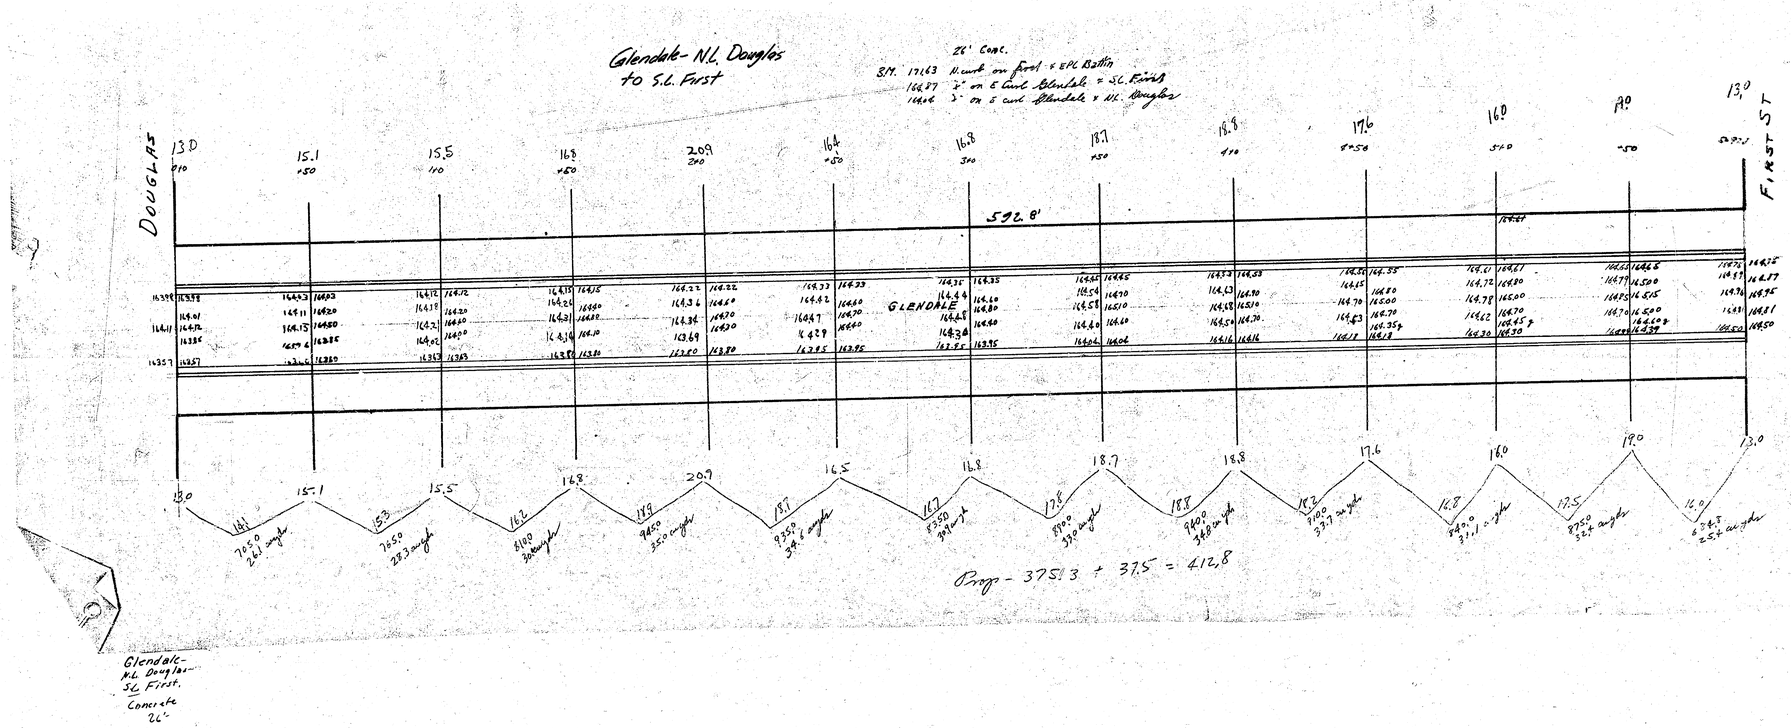

Glendale-
N.L. Douglas-
S.L. First.
Concrete
26'