


$\text{Luty } 88.0 \div 1.070 = 100.0 \text{ cu yd}$
 $\text{Comp } 178.5 \div 1.070 = 141.0 \text{ cu yd}$

Curb & Gutter on Glendale

B.M. Elev. 158.93 "North curb at Kellogg bet. Elroy & Glendale"

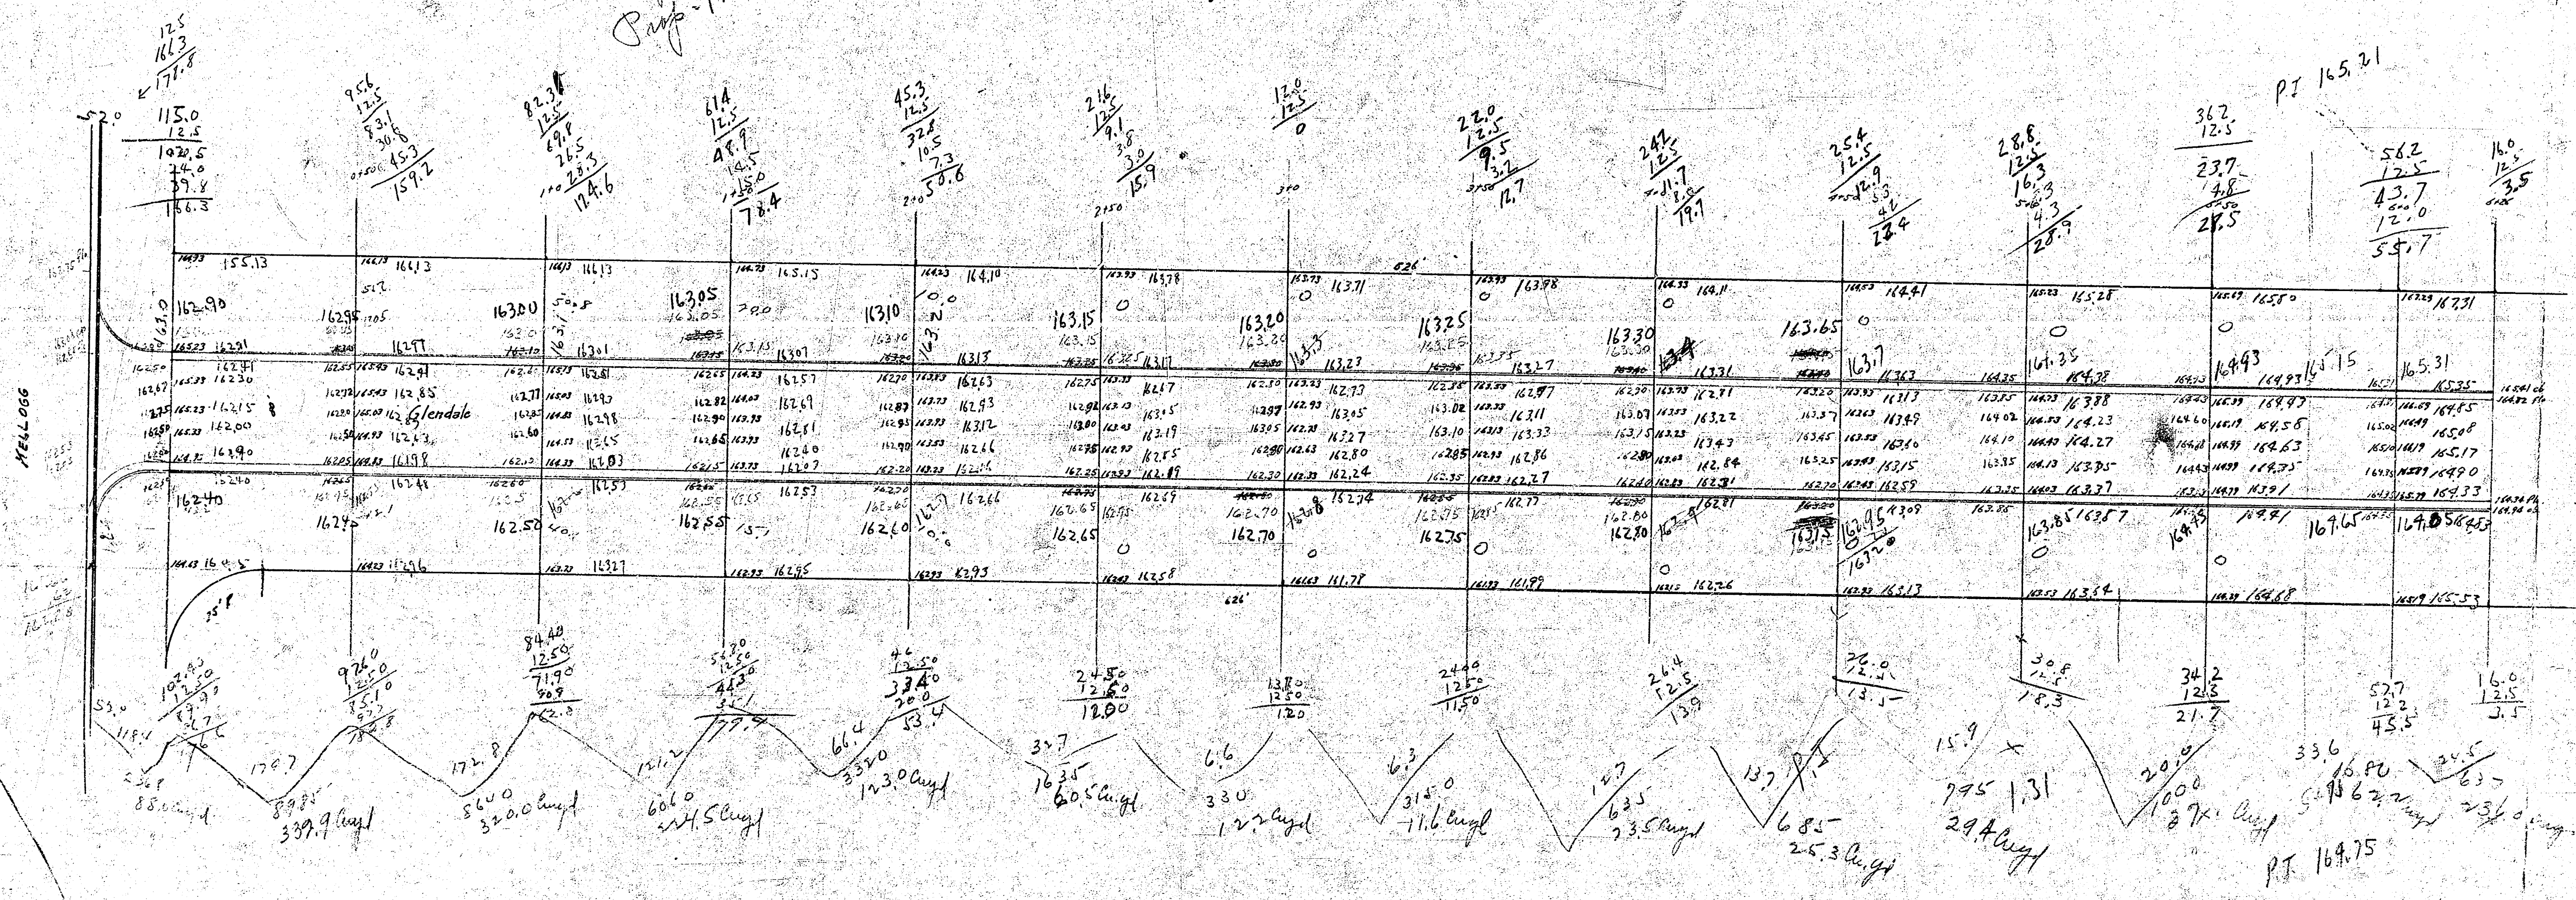

Plan View
 1937
 Glendale
 at Kellogg
 bet. Elroy & Glendale
 Section 14