


817.92.94 M in Mueller, Fire Hydrant, Glen Oaks & Cheyenne
 NOTE: CHAINING EAST ON SOUTH 12

Survey File 1501/BK 154
 Plan DEC
 Exc. DEC
 Drawing 117

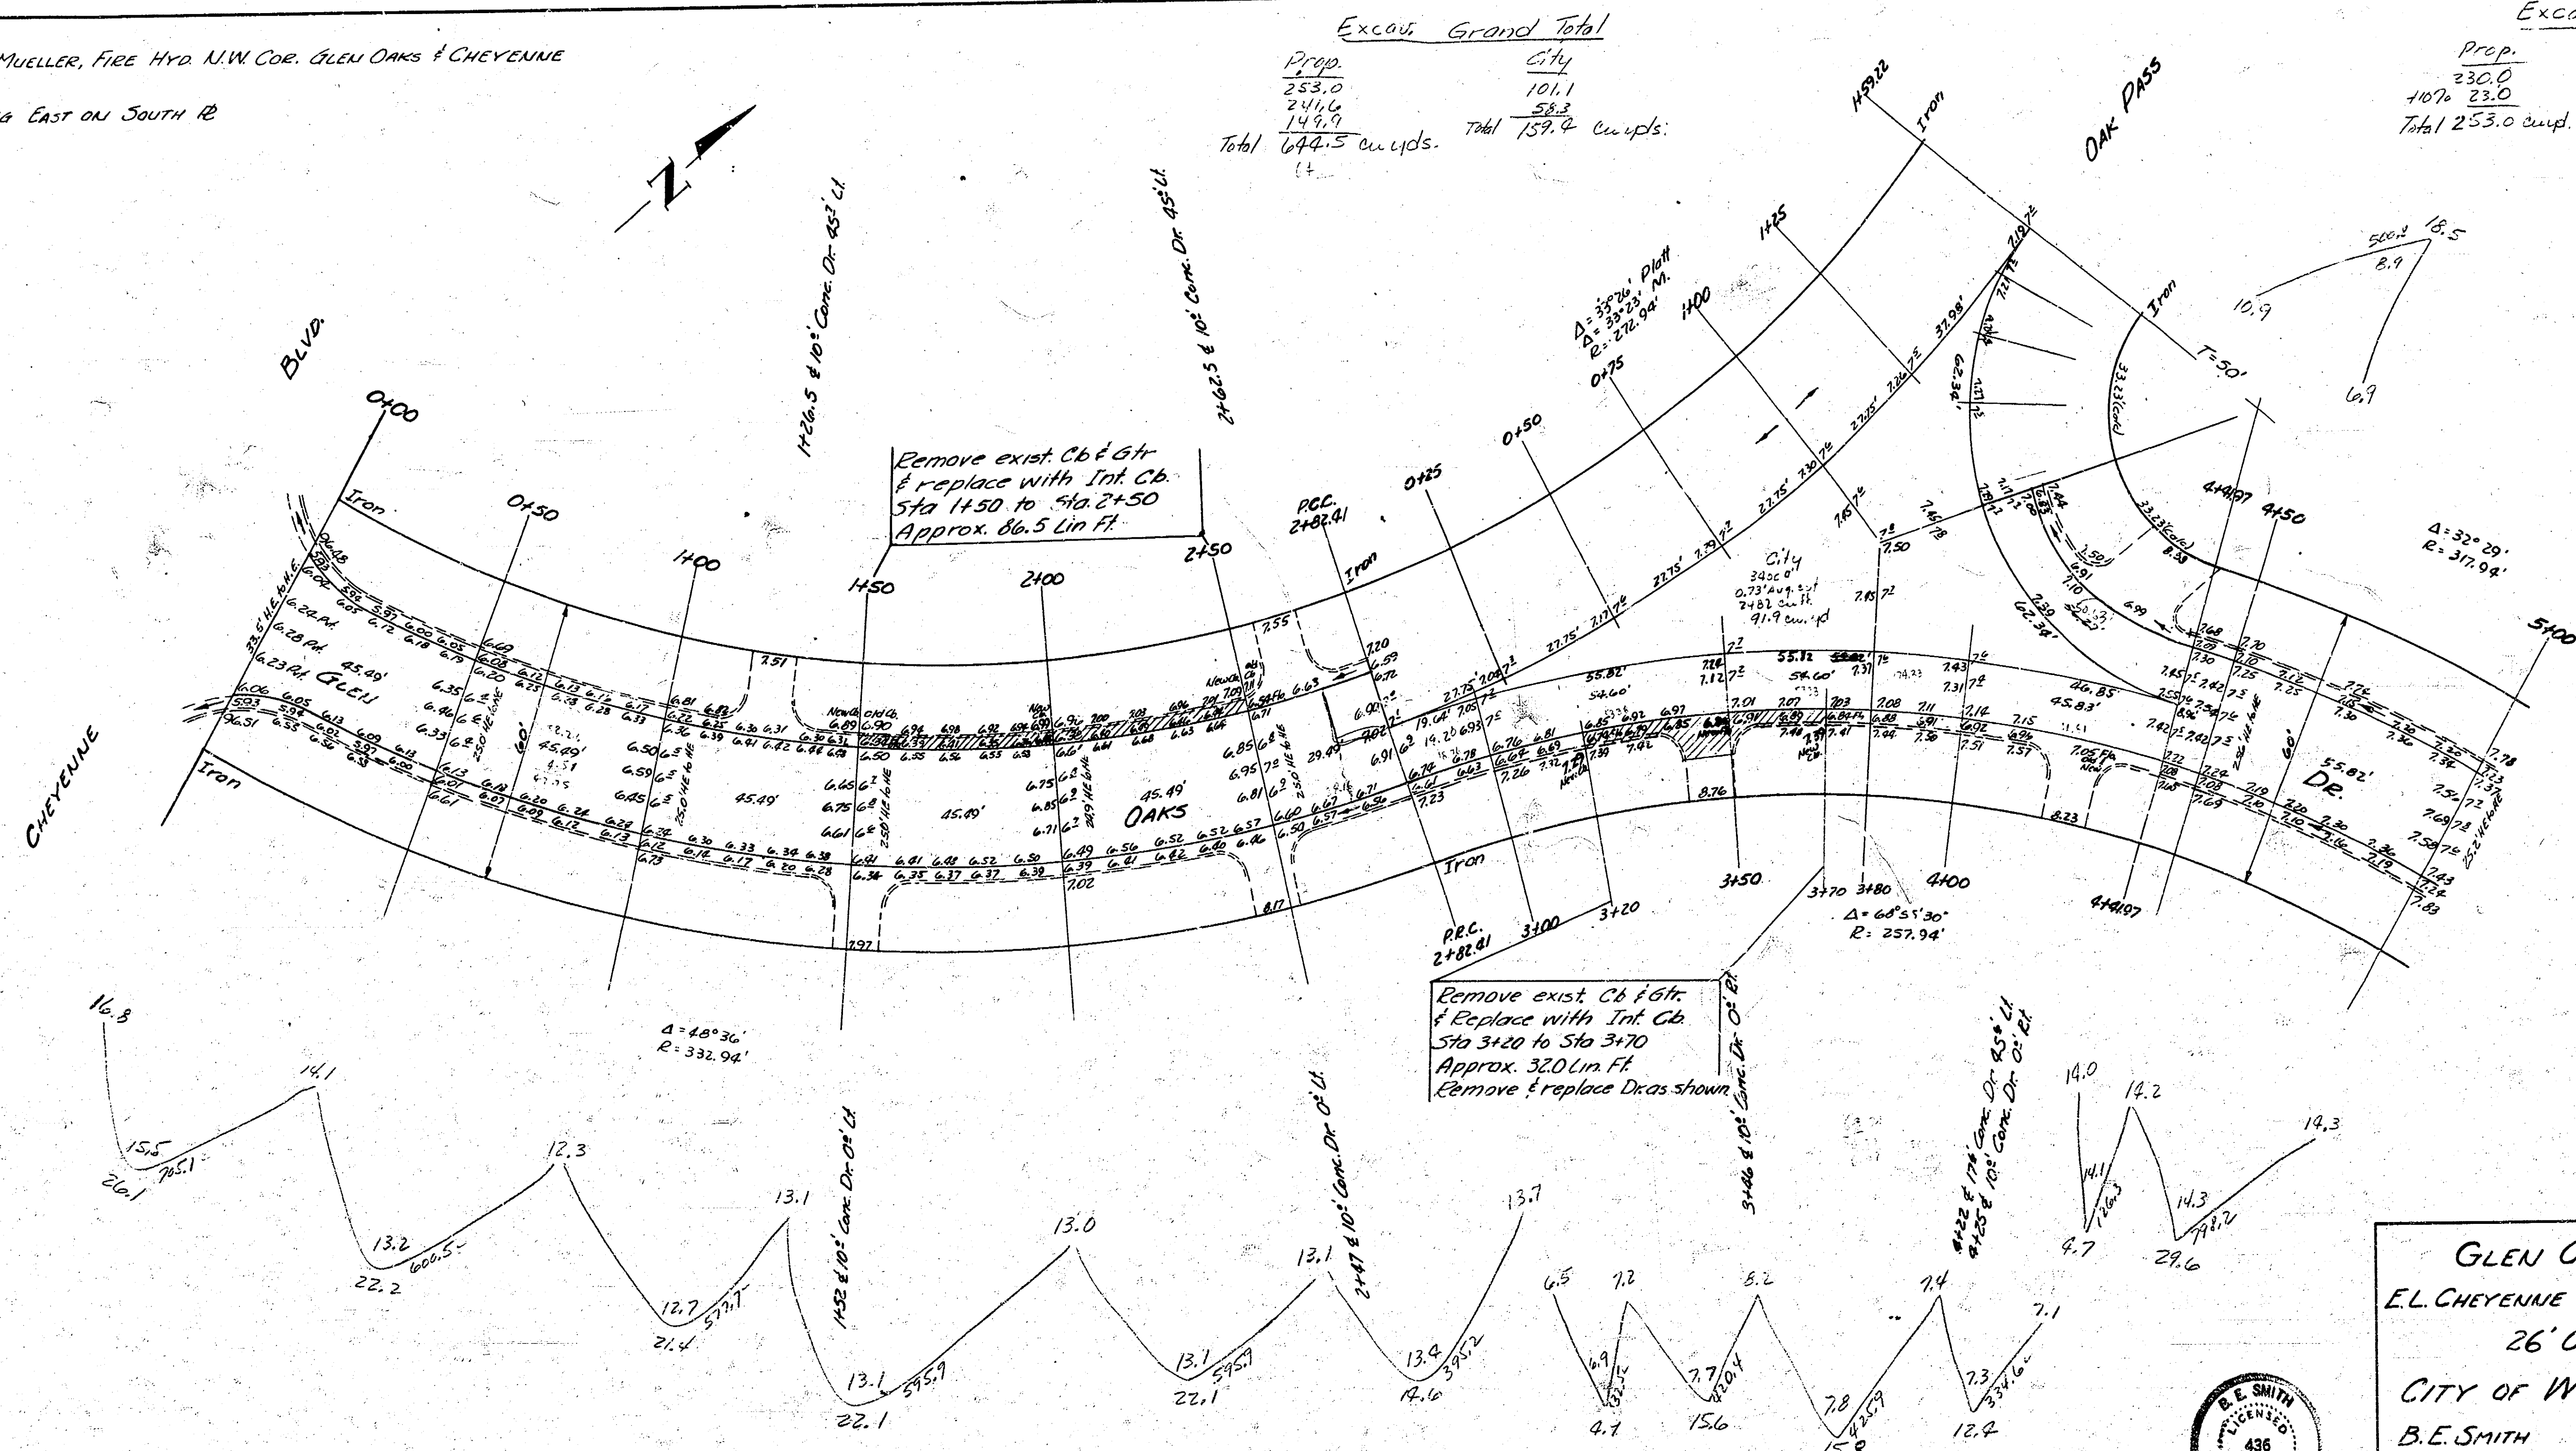

Excav. Grand Total
 Prop. City
 253.0 101.1
 149.9 58.2
 Total 644.5 cu yds. Total 159.2 cu yds.

Excav.
 Prop. City
 253.0 101.1
 Total 253.0 cu yds. Total 101.1 cu yds.

1
3

GLEN OAKS DR.
 E.L. CHEYENNE TO E.L. EL RANCHO
 26' CONC.
 CITY OF WICHITA, KANS.
 B.E. SMITH CITY ENGINEER
 MARCH 1934 PROJ. No. C13-214

