1942.

GOLD ST – N.L. KINKAID TO N.L. BROOKINGS ADD^N

2'6" CONC.

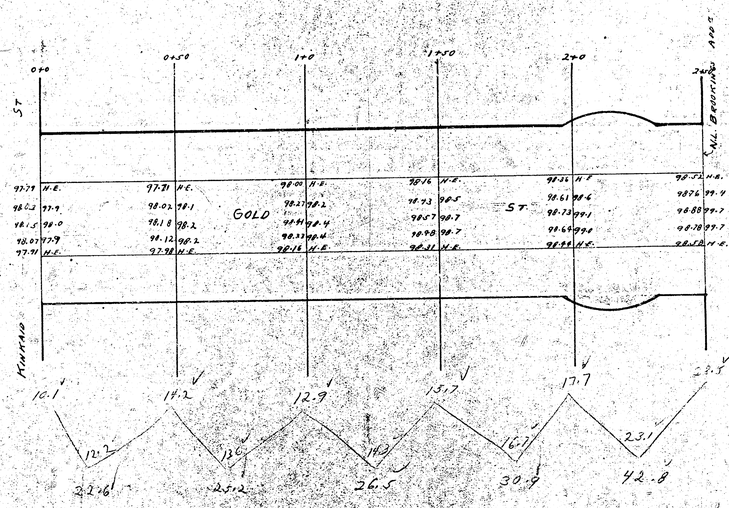


| | |
|---|---|
| | 22.6 |
| | 25.2 |
| | 26.5 |
| | 30.9 |
| | 42.8 |
| | 148.0 |
| 4 into | 14.8 |
| | 6 2.6 |