
1942.

GOLD ST – N.L. KINKAID TO N.L. BROOKINGS ADDN.

2-6 CONC.

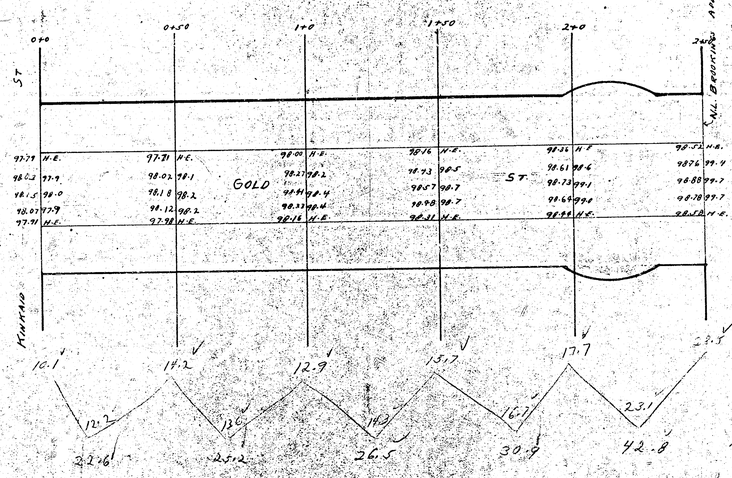

	22.6
	25.2
	26.5
	30.9
	42.8
	148.0
4 min	14.8
	6 2.5