



Sta On E
 BM. 99801 RR Spike S.S. H.L.P. N.S. 31ST ST. SO. -100' W. Of Gordon, So.
 1932 B.M. Settled. Reported by J. H. Clarke 11/9/56

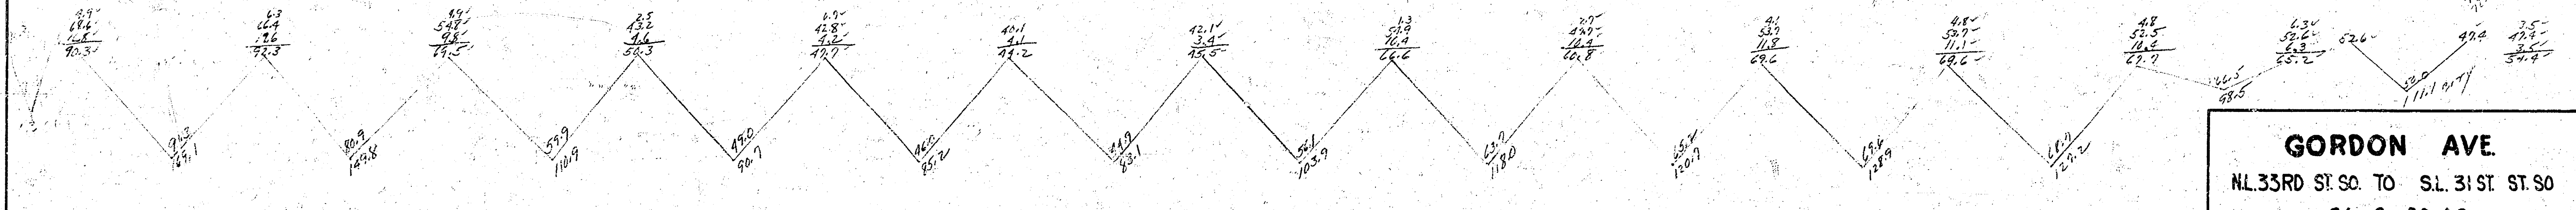

PROPERTY
 2420.8
 +10% 242.1
 2662.9 CUBIC CUT

CITY
 184.4
 +10% 18.4
 202.8 CUBIC CUT

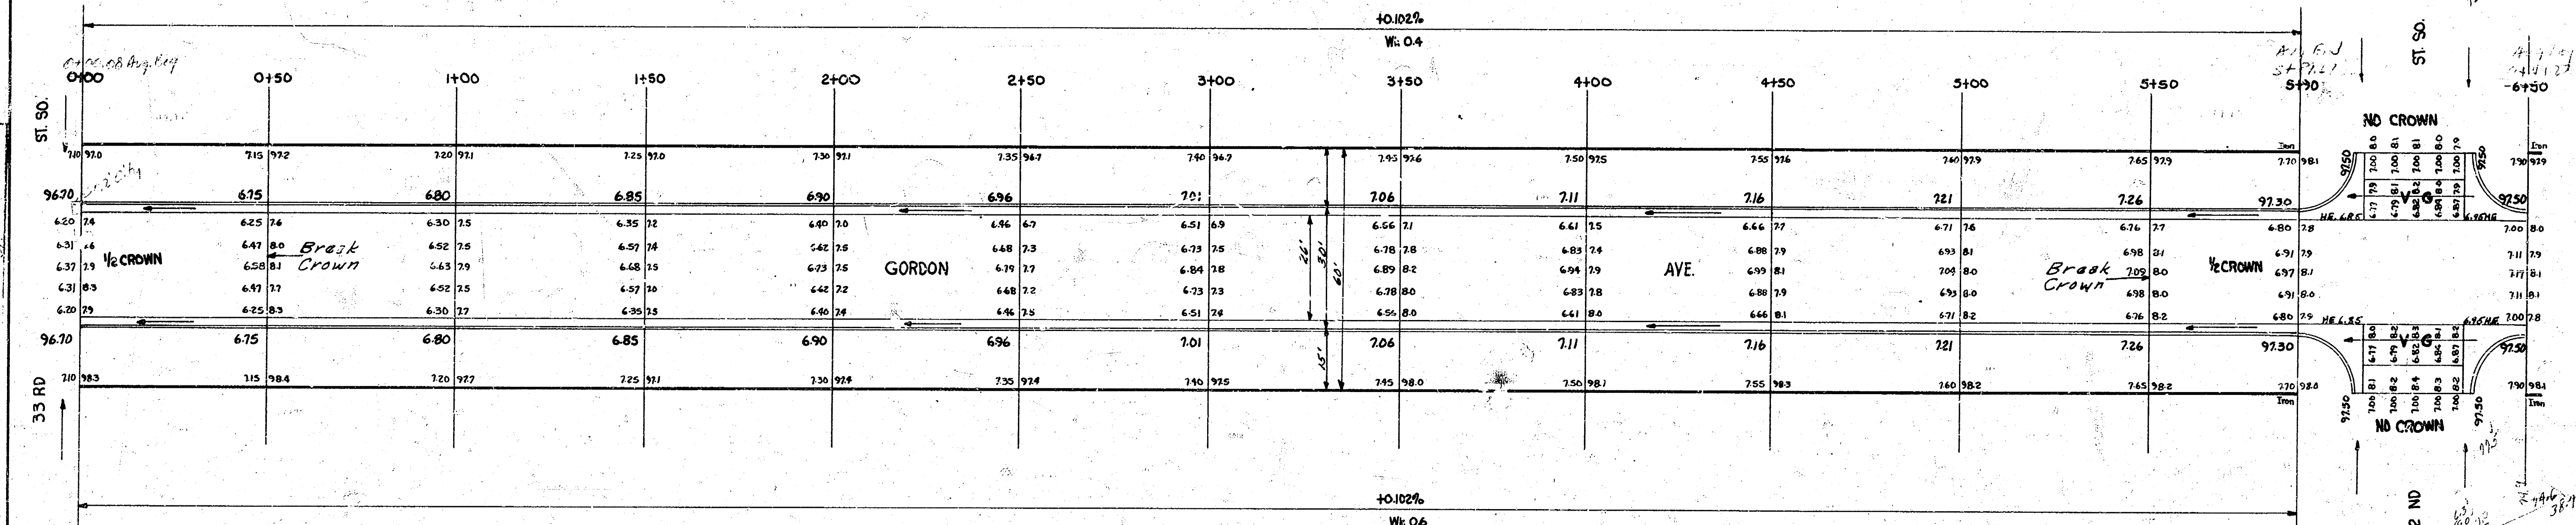

GORDON AVE.
 NL 33RD ST. SO. TO SL 31ST ST. SO.
 26-2-30 AC
 CITY OF WICHITA, KANSAS
 B.E. SMITH
 Oct. 1955
 CITY ENGINEER
 PROJ. NO. C 15-91

Survey Year 1957
 Plan Revision
 E.C. 10/1/57
 Checked by

