
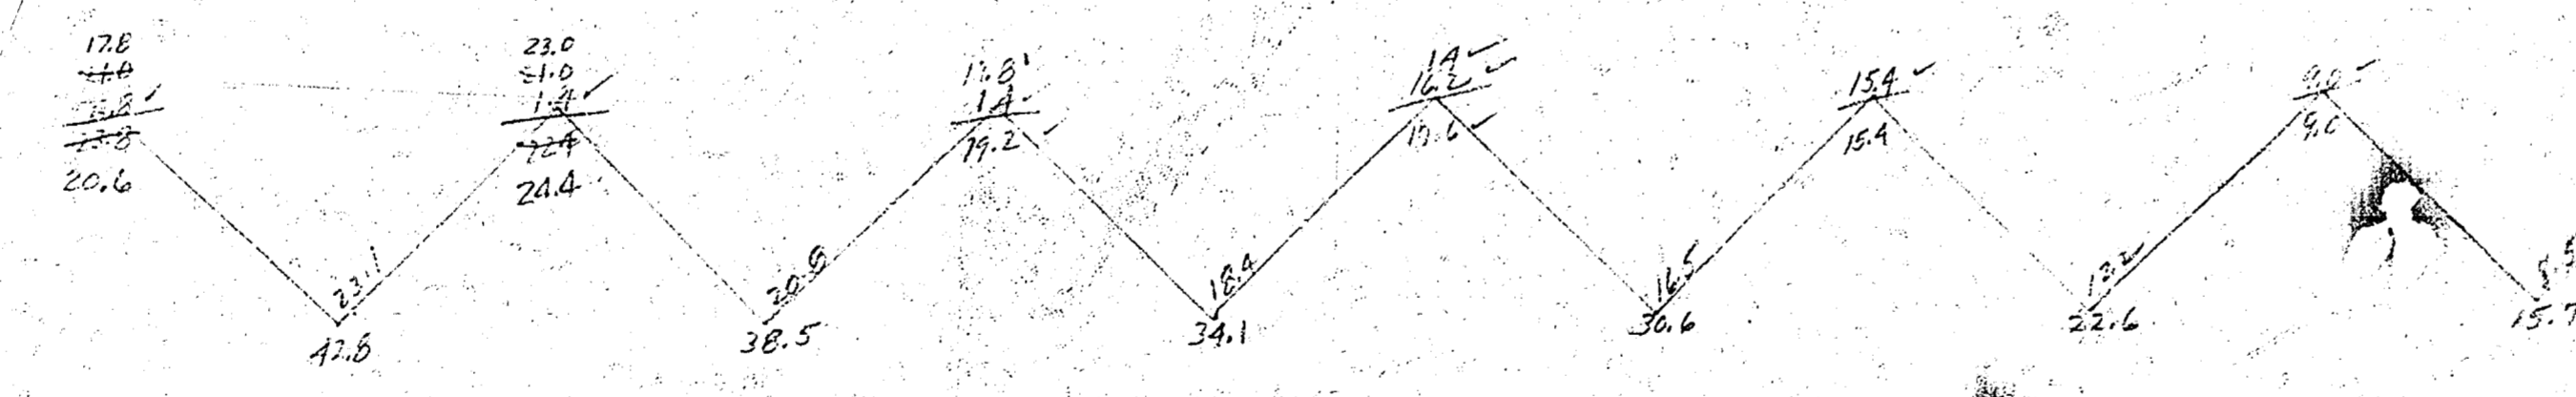


BM 12721 N.W. COR. CONC. PORCH HOUSE "2709 WEST 18"
 BM 12530 STEP BM SOUTH SIDE H.L.P. NE. COR 17th ST PAUL

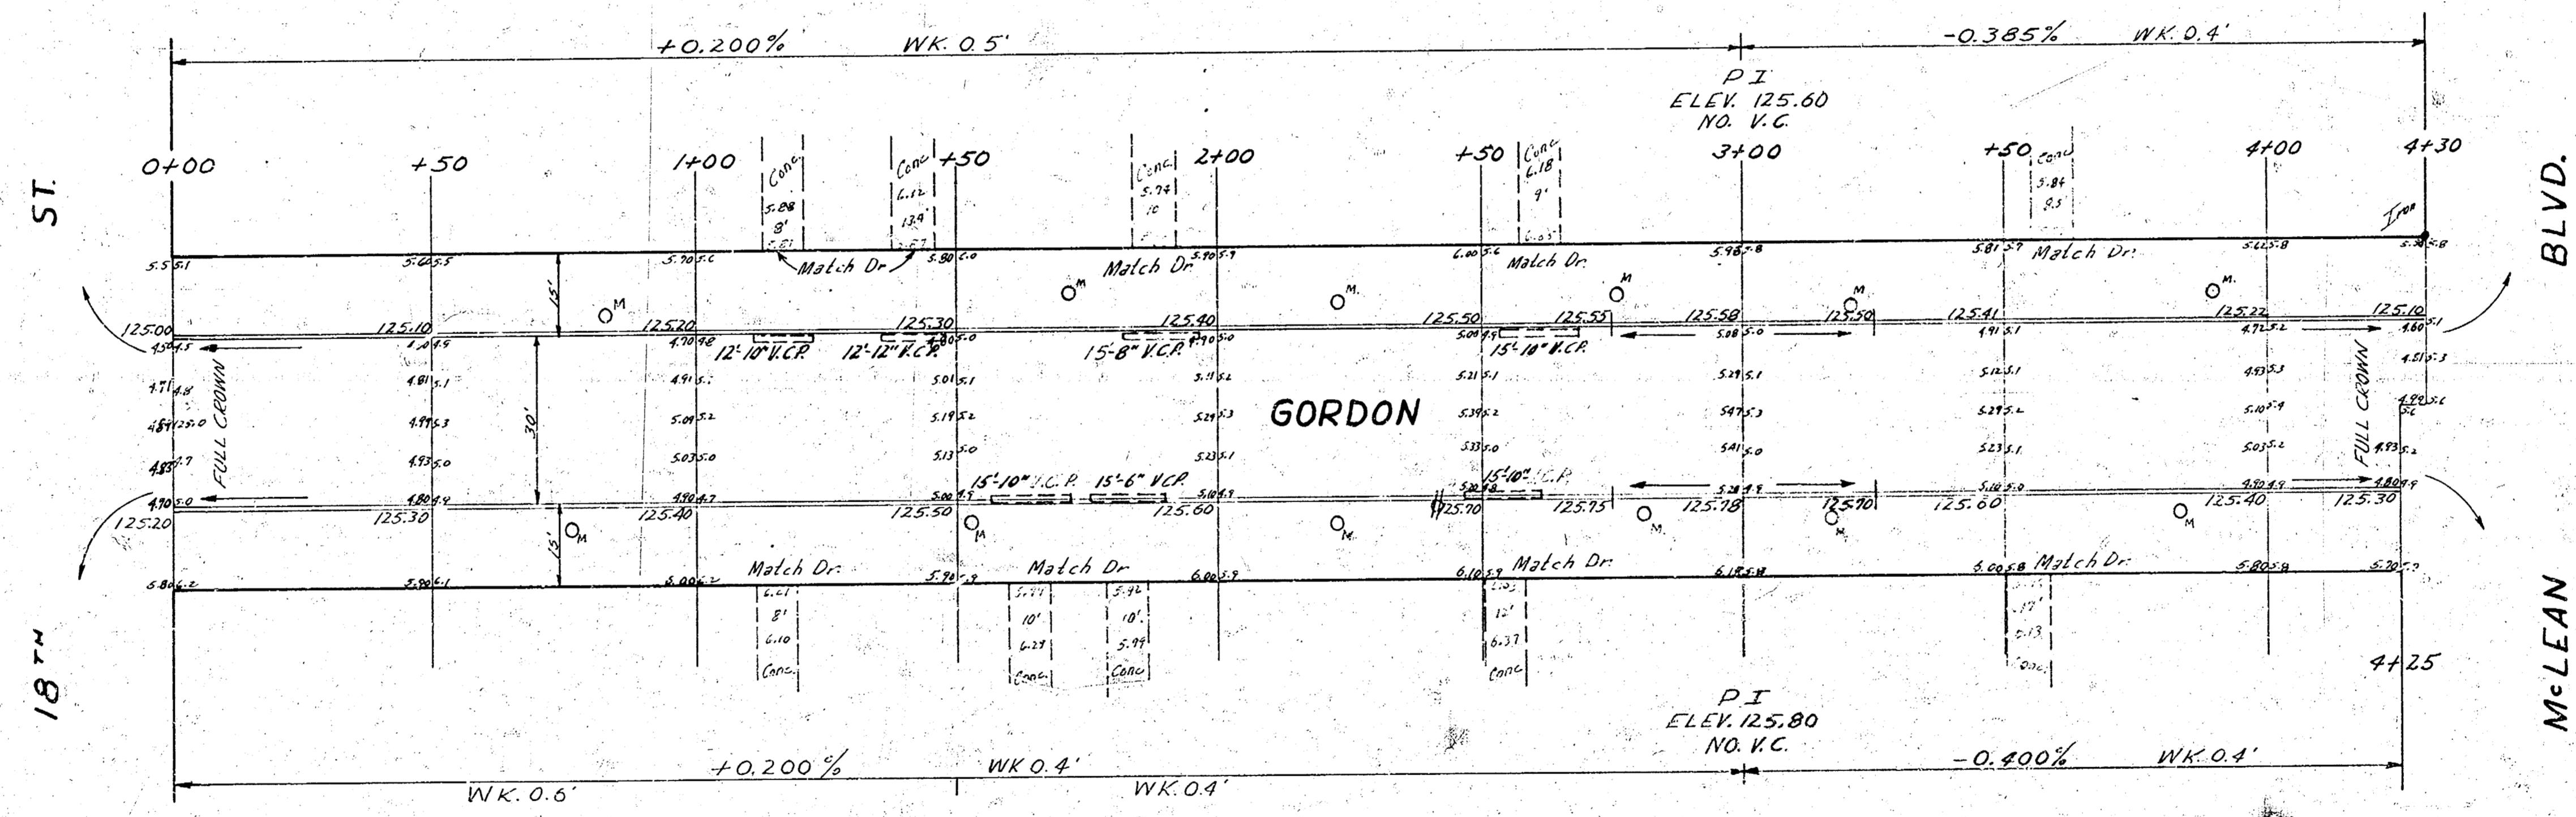

Harvey Young Br 1257
 Plan Station
 Checked

E 1231
 244.2
 +11.4
 297 D. C. 102 C.

GORDON
 N.L. 18th TO S.L. McLEAN BLVD.
 30' CONC. CB.
 CITY OF WICHITA KANS.
 BE SMITH CITY ENGINEER
 JUNE 1957 PROJ NO C16-121