



BK 52Y

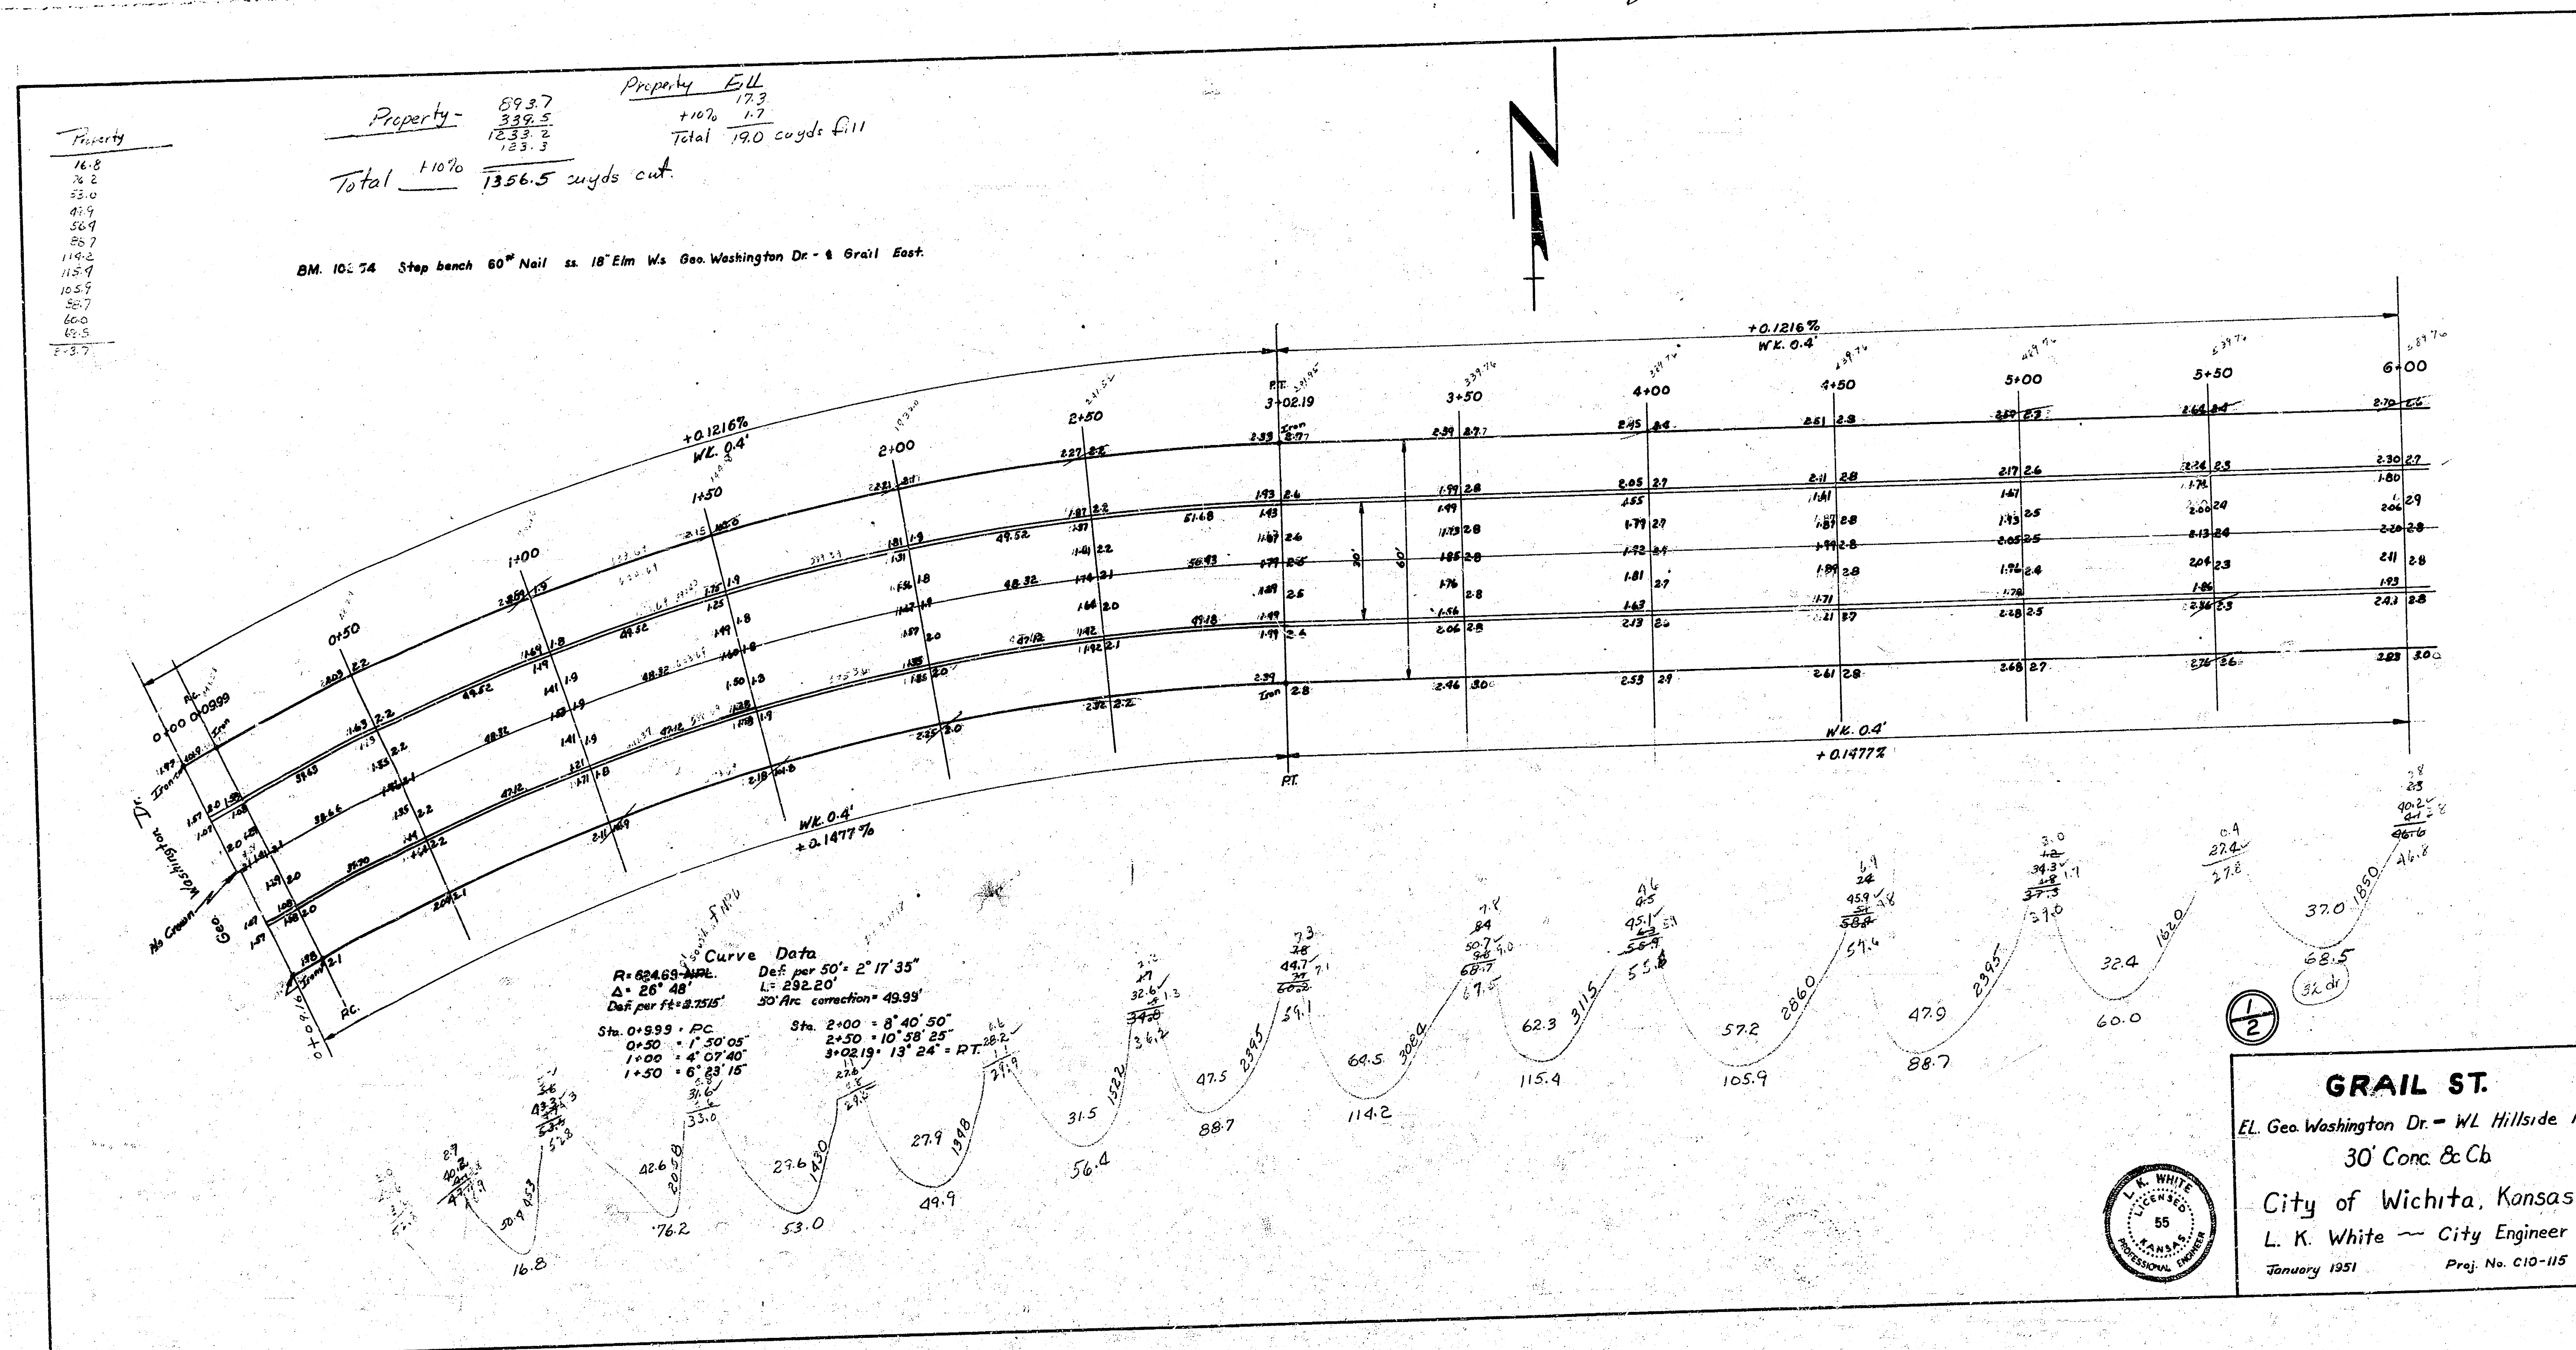


BK 52Y

Property

844
75.4
69.3
59.3
37.6
326.0
125
339.5

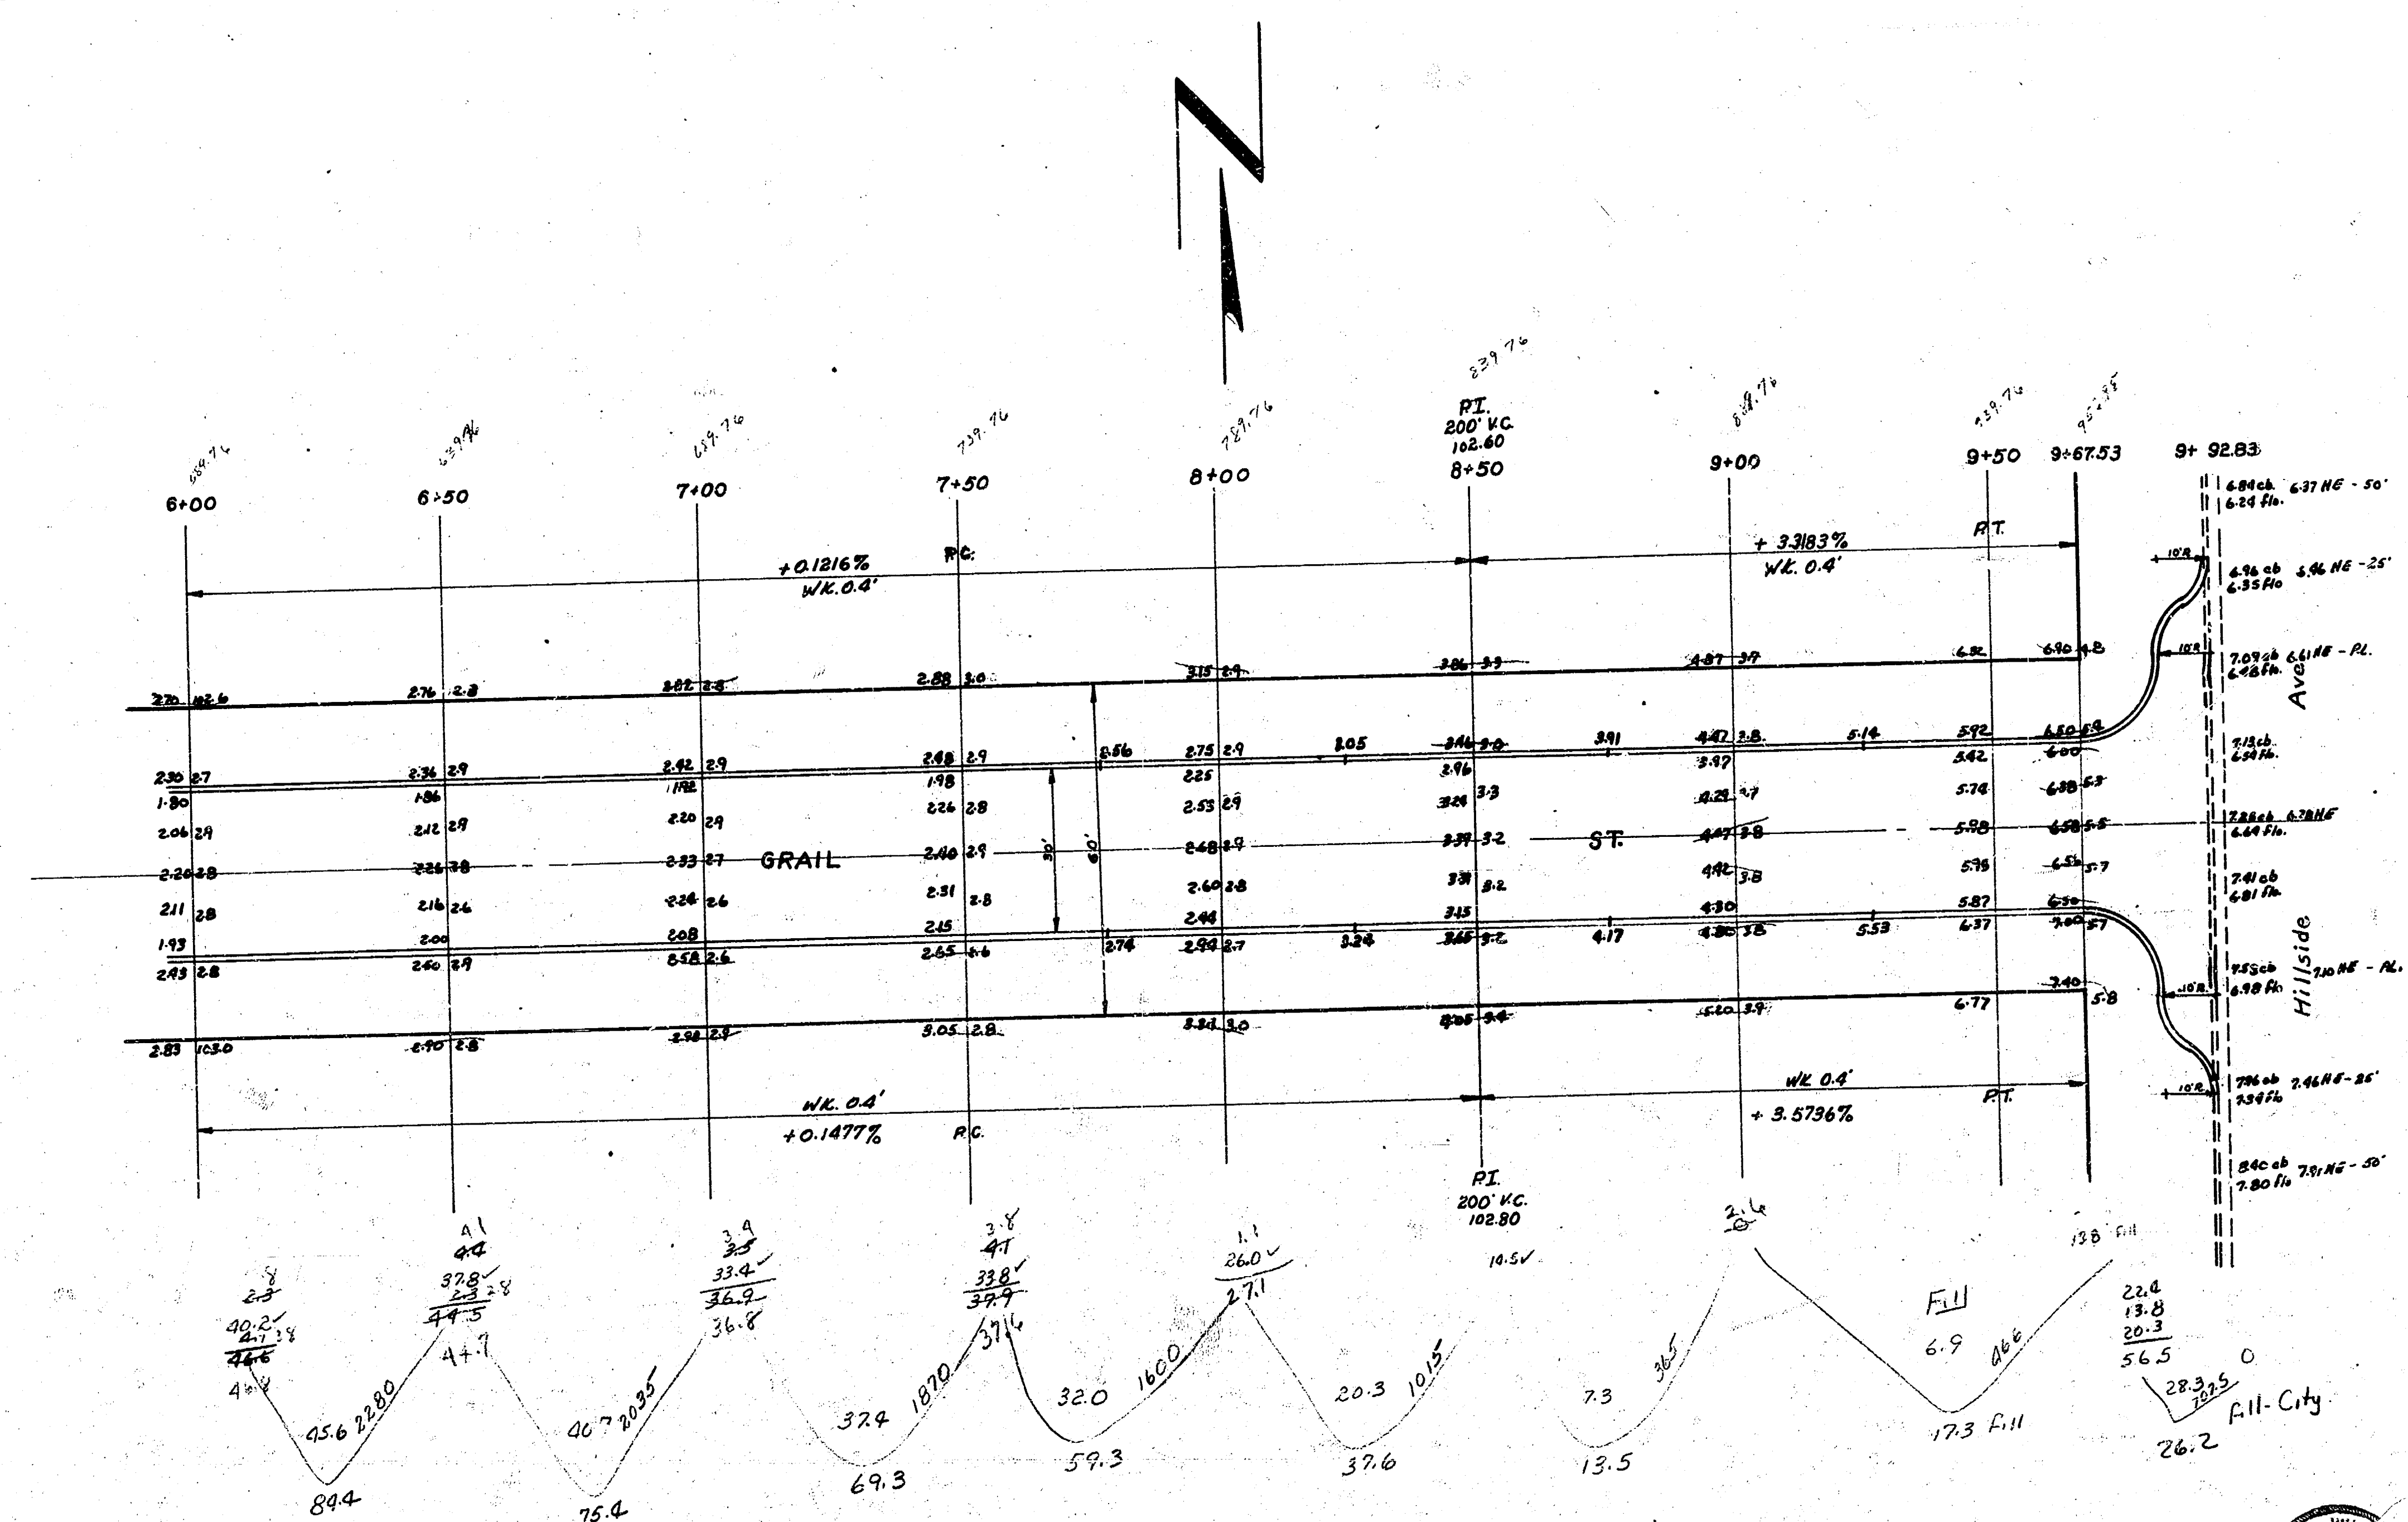

GRAIL ST.

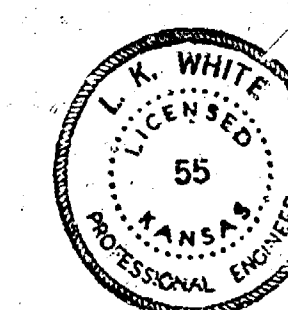

4 5 1 (50)