


B.M. 124.33 B in Burton App Wk. E. Co. Green N.S. 134.
 B.M. 126.48 Top S. Bolt Top Hyd. S.W. 14th & Green

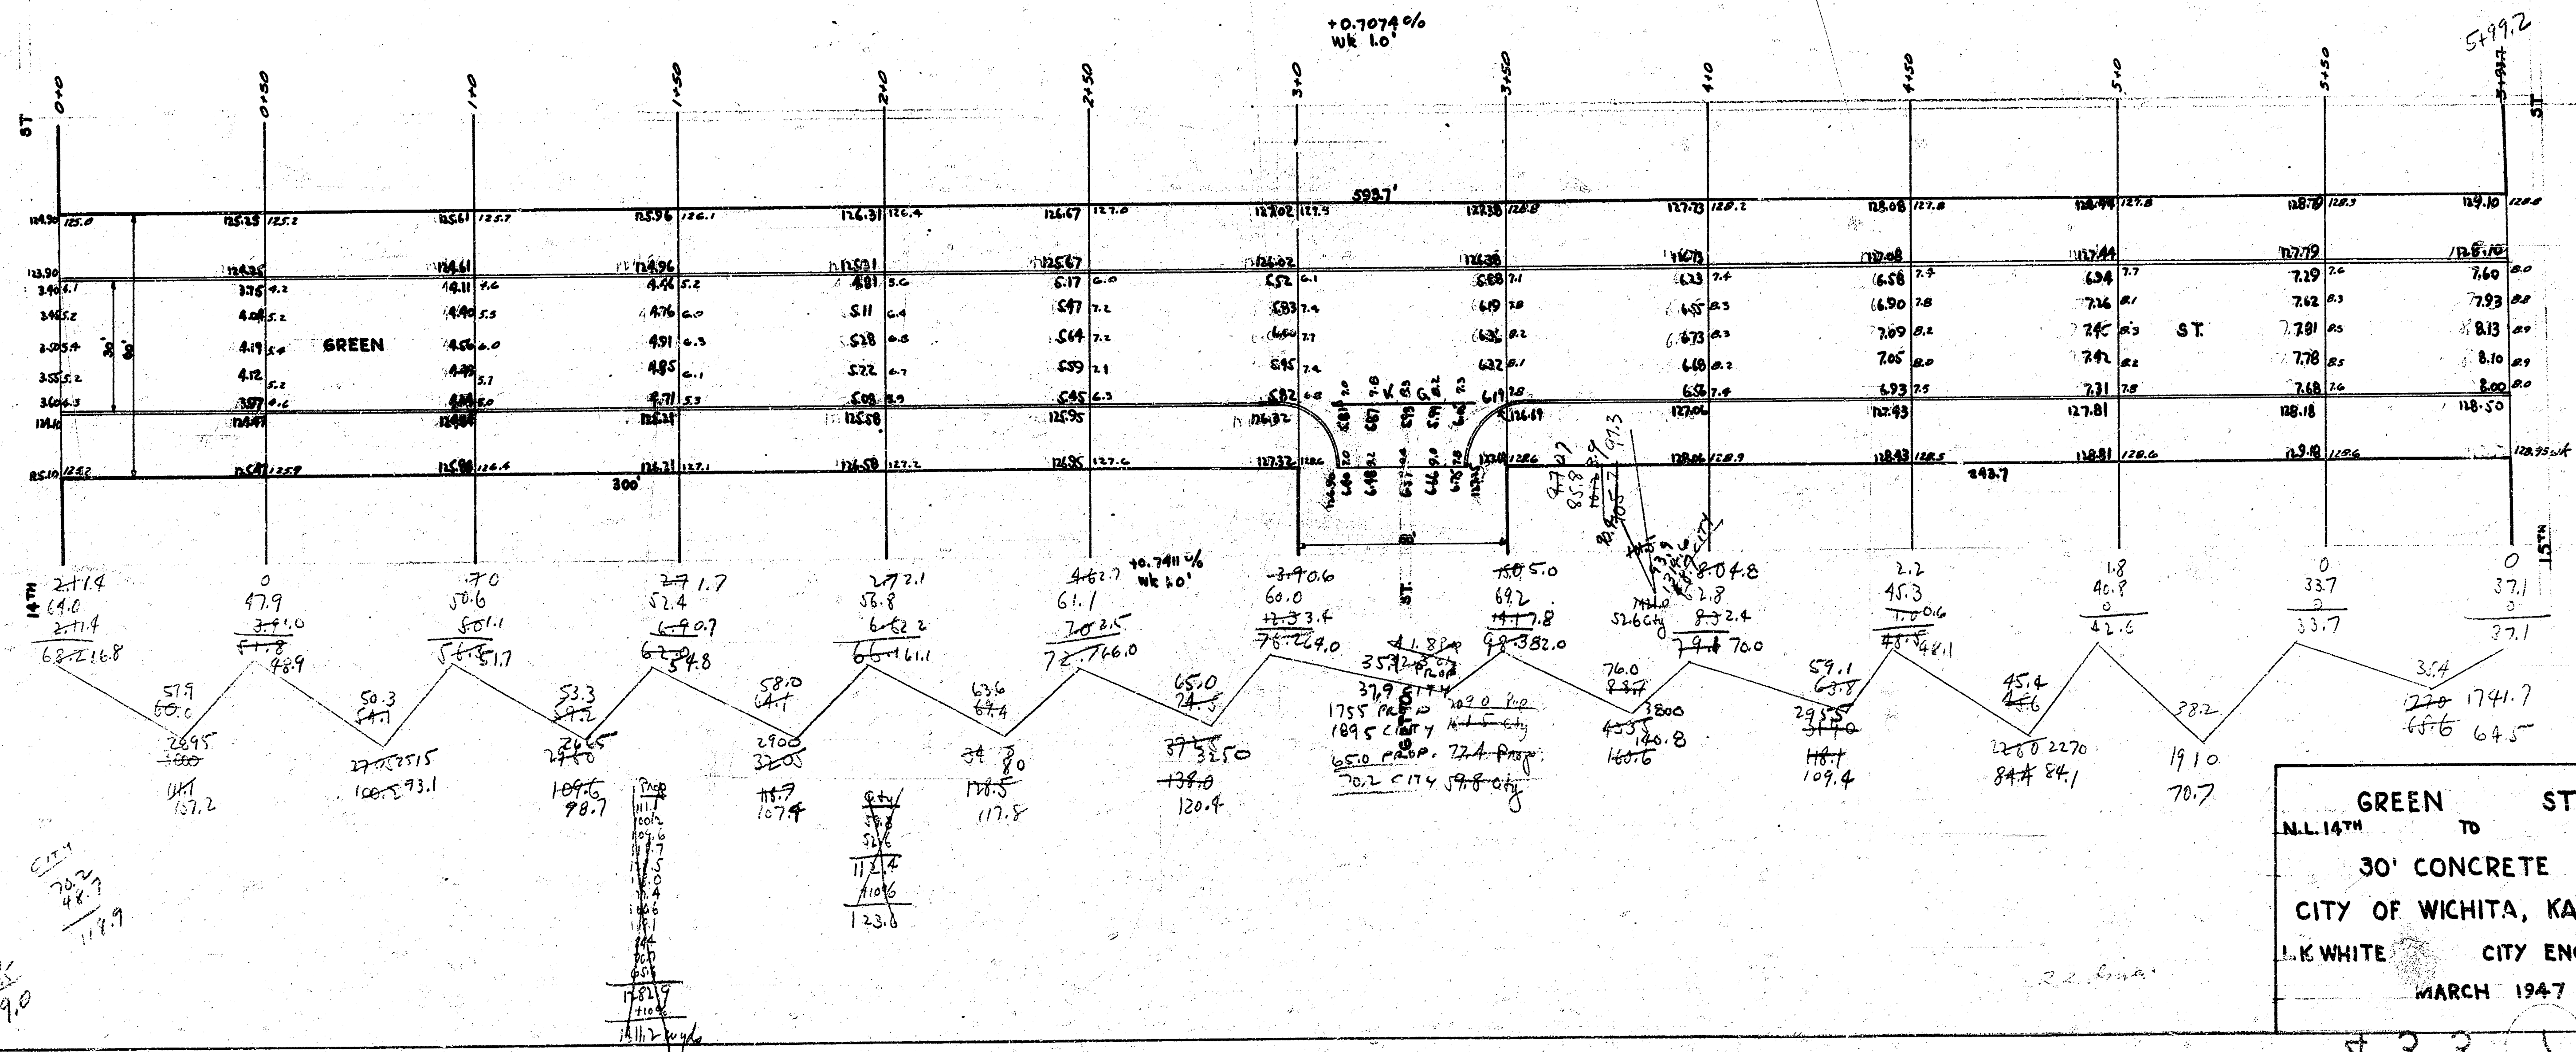

GREEN ST
 N.L. 14TH TO S.L. 15TH
 30' CONCRETE
 CITY OF WICHITA, KANSAS
 L.K. WHITE CITY ENGINEER
 MARCH 1947

433