



Sta On SR
B.M. 99667 Standard N.E. Cor Meridian & 27th St So.


Note
Install 2-15" RCP 50' Long.
Const. Dirt And Sand Hookup.

NEW 15" RCP
NEW 15" RCP
MERIDIAN AVE.
V-6

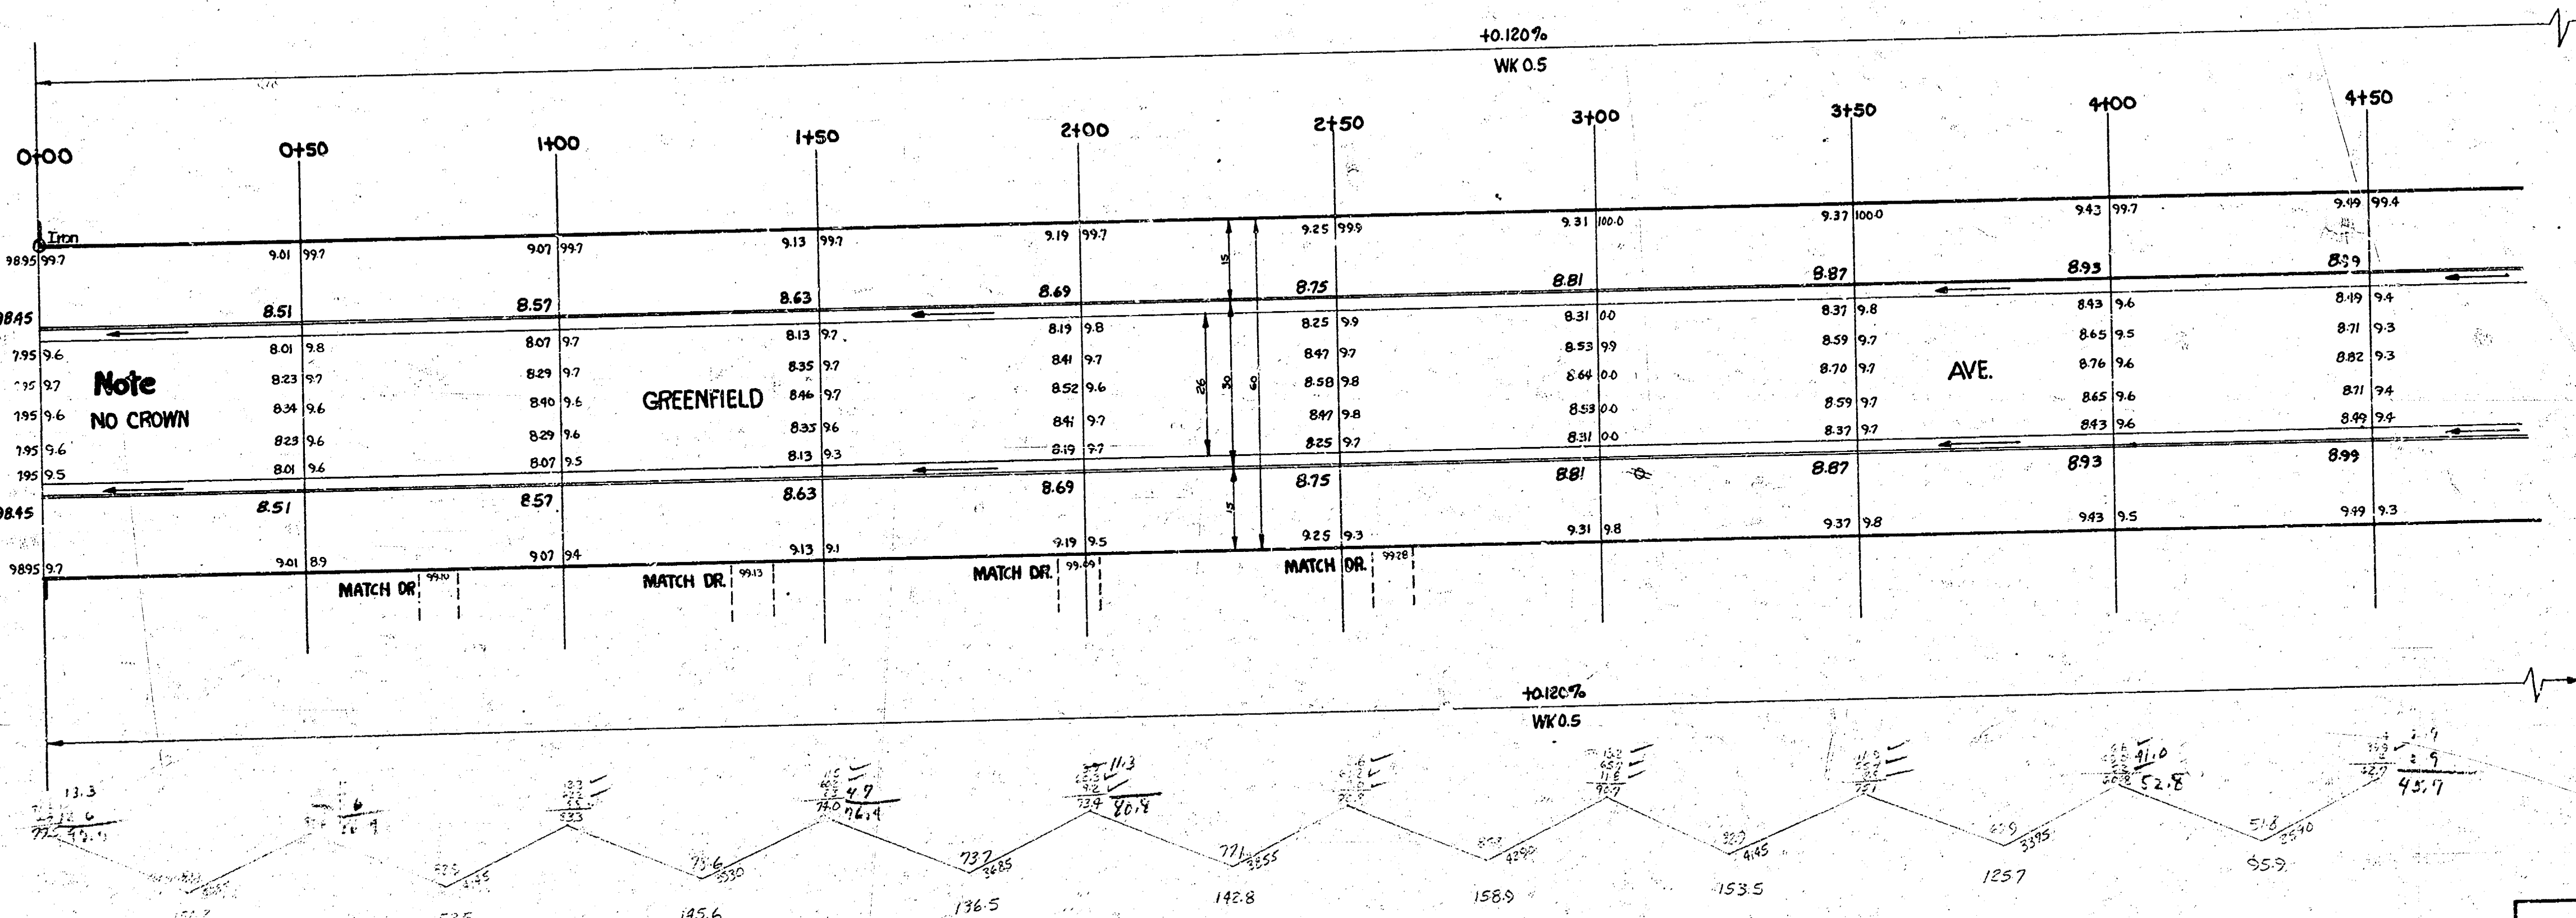

Greenfield Ave.
E.L. Meridian To W.L. Everett
26-2-30 A.C.
City Of Wichita, Kansas
B.E. Smith City Engineer
July 1955 Proj. No. C14-244

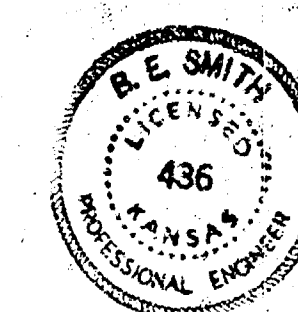

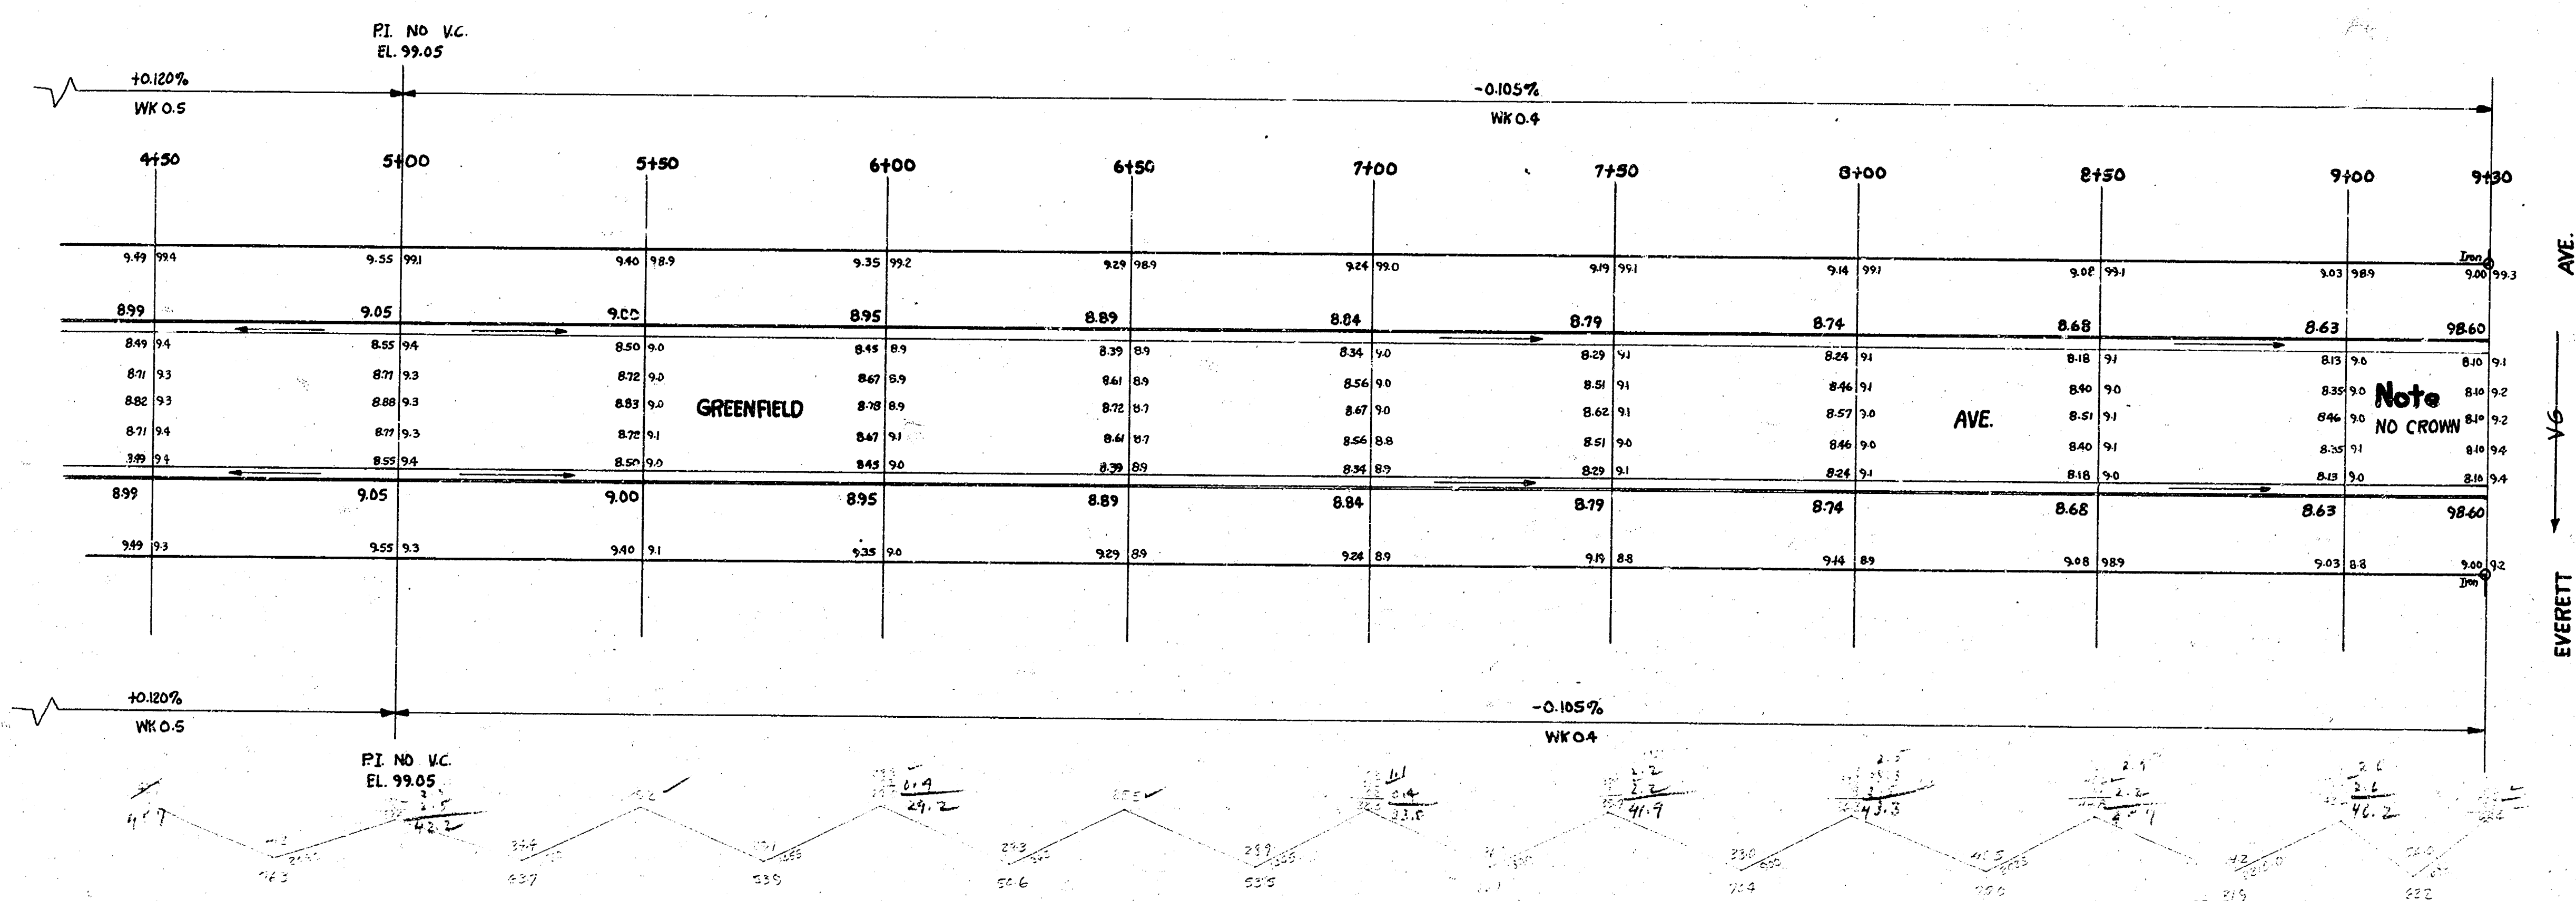

Greenfield Ave
Proj. No. C14-244

2/2