


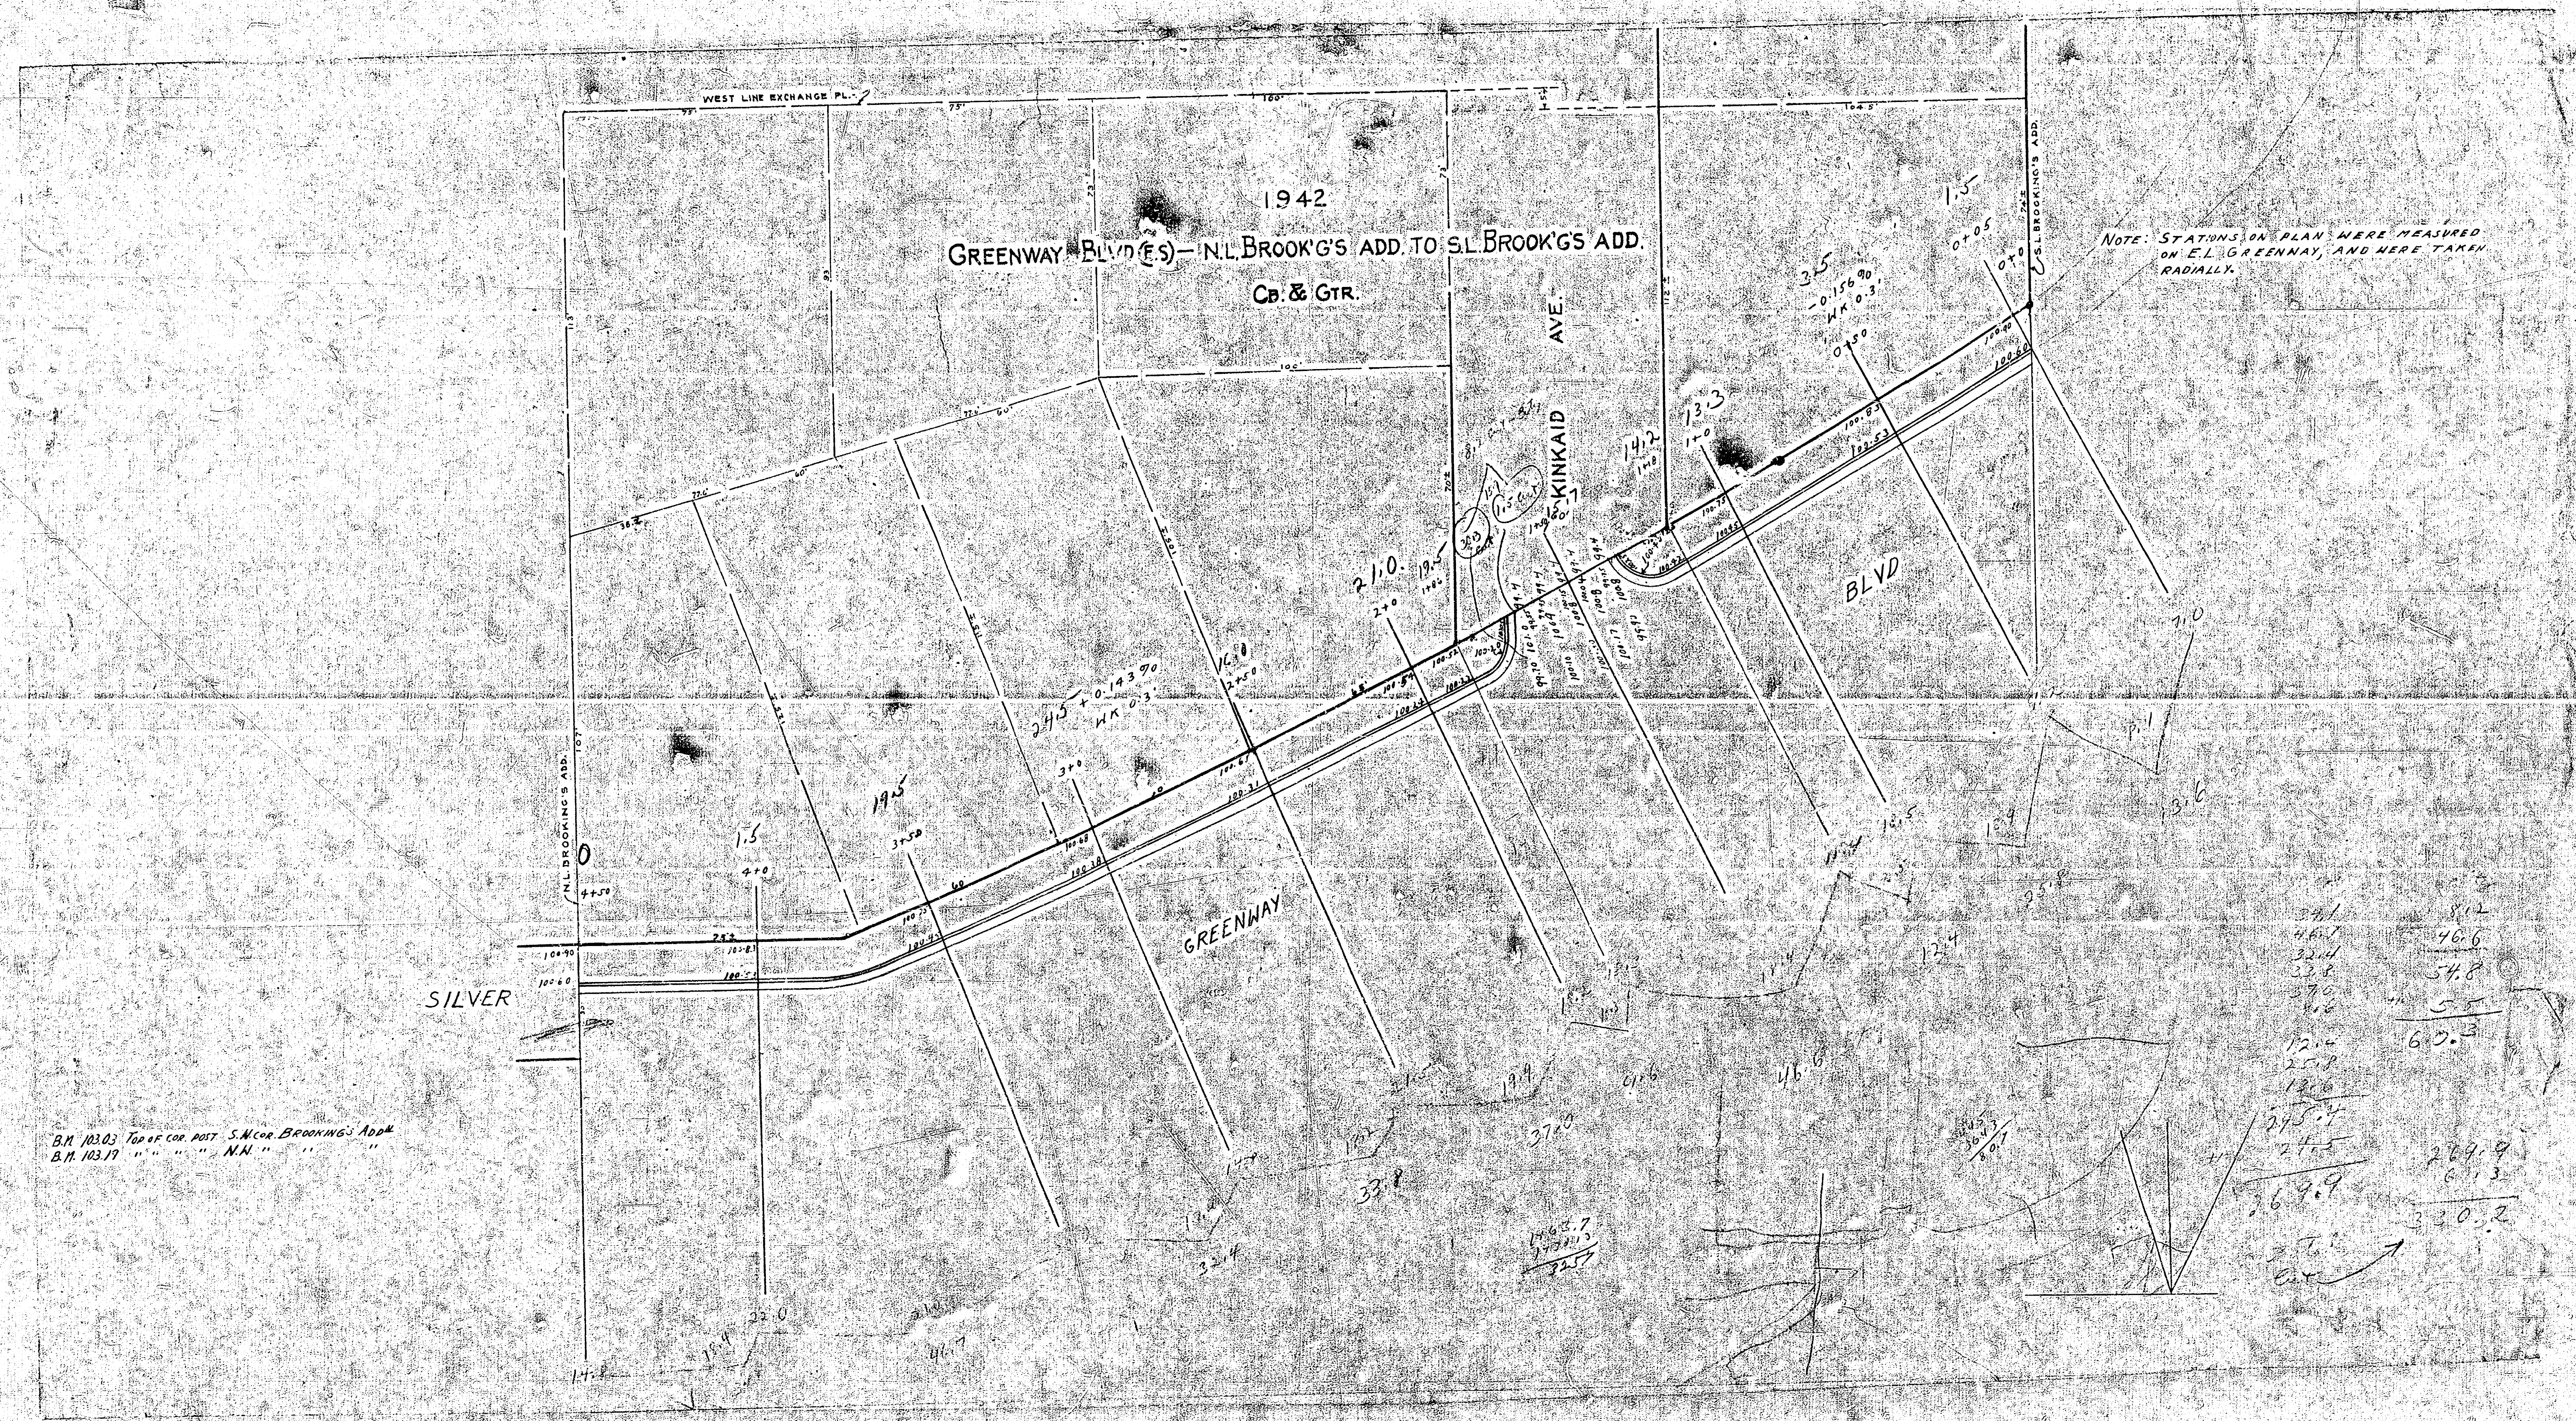

B.M. 10302 Top of cor. post S. L. Brookings' Add.
B.M. 10317 " " " " N.L. " " "

38.1	8.12
46.7	76.6
33.4	54.8
27.6	5.5
4.8	60.3
12.4	
55.8	
18.6	
248.5	229.9
24.5	6.3
6.9.9	340.2
27.1	
0.4	

1465.7
1471.0
225.7