



GREENWAY BLVD.
N.L. SILVER TO S.L. CLARK

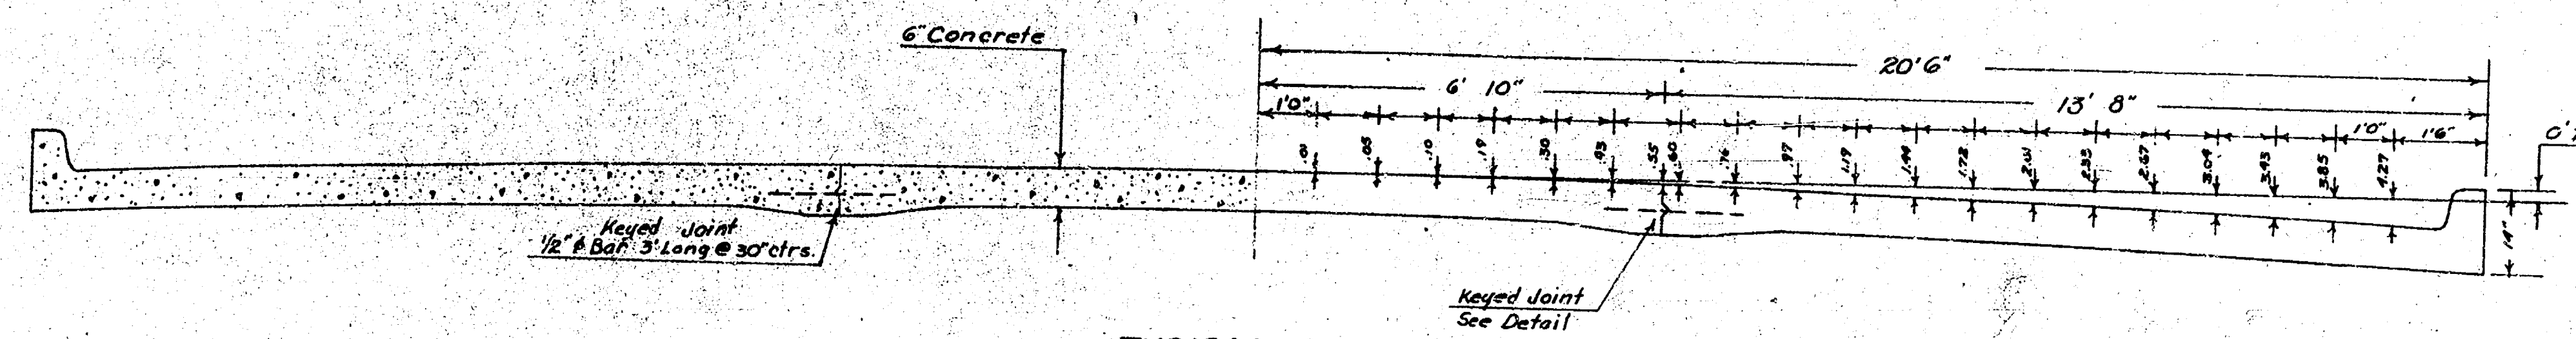


TYPICAL SECTION
No Scale

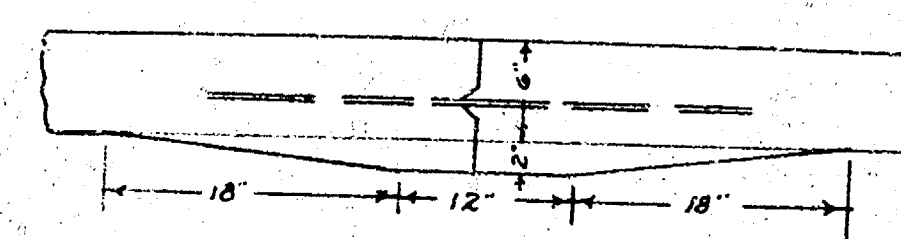


Detail of Keyed Joint

No Scale

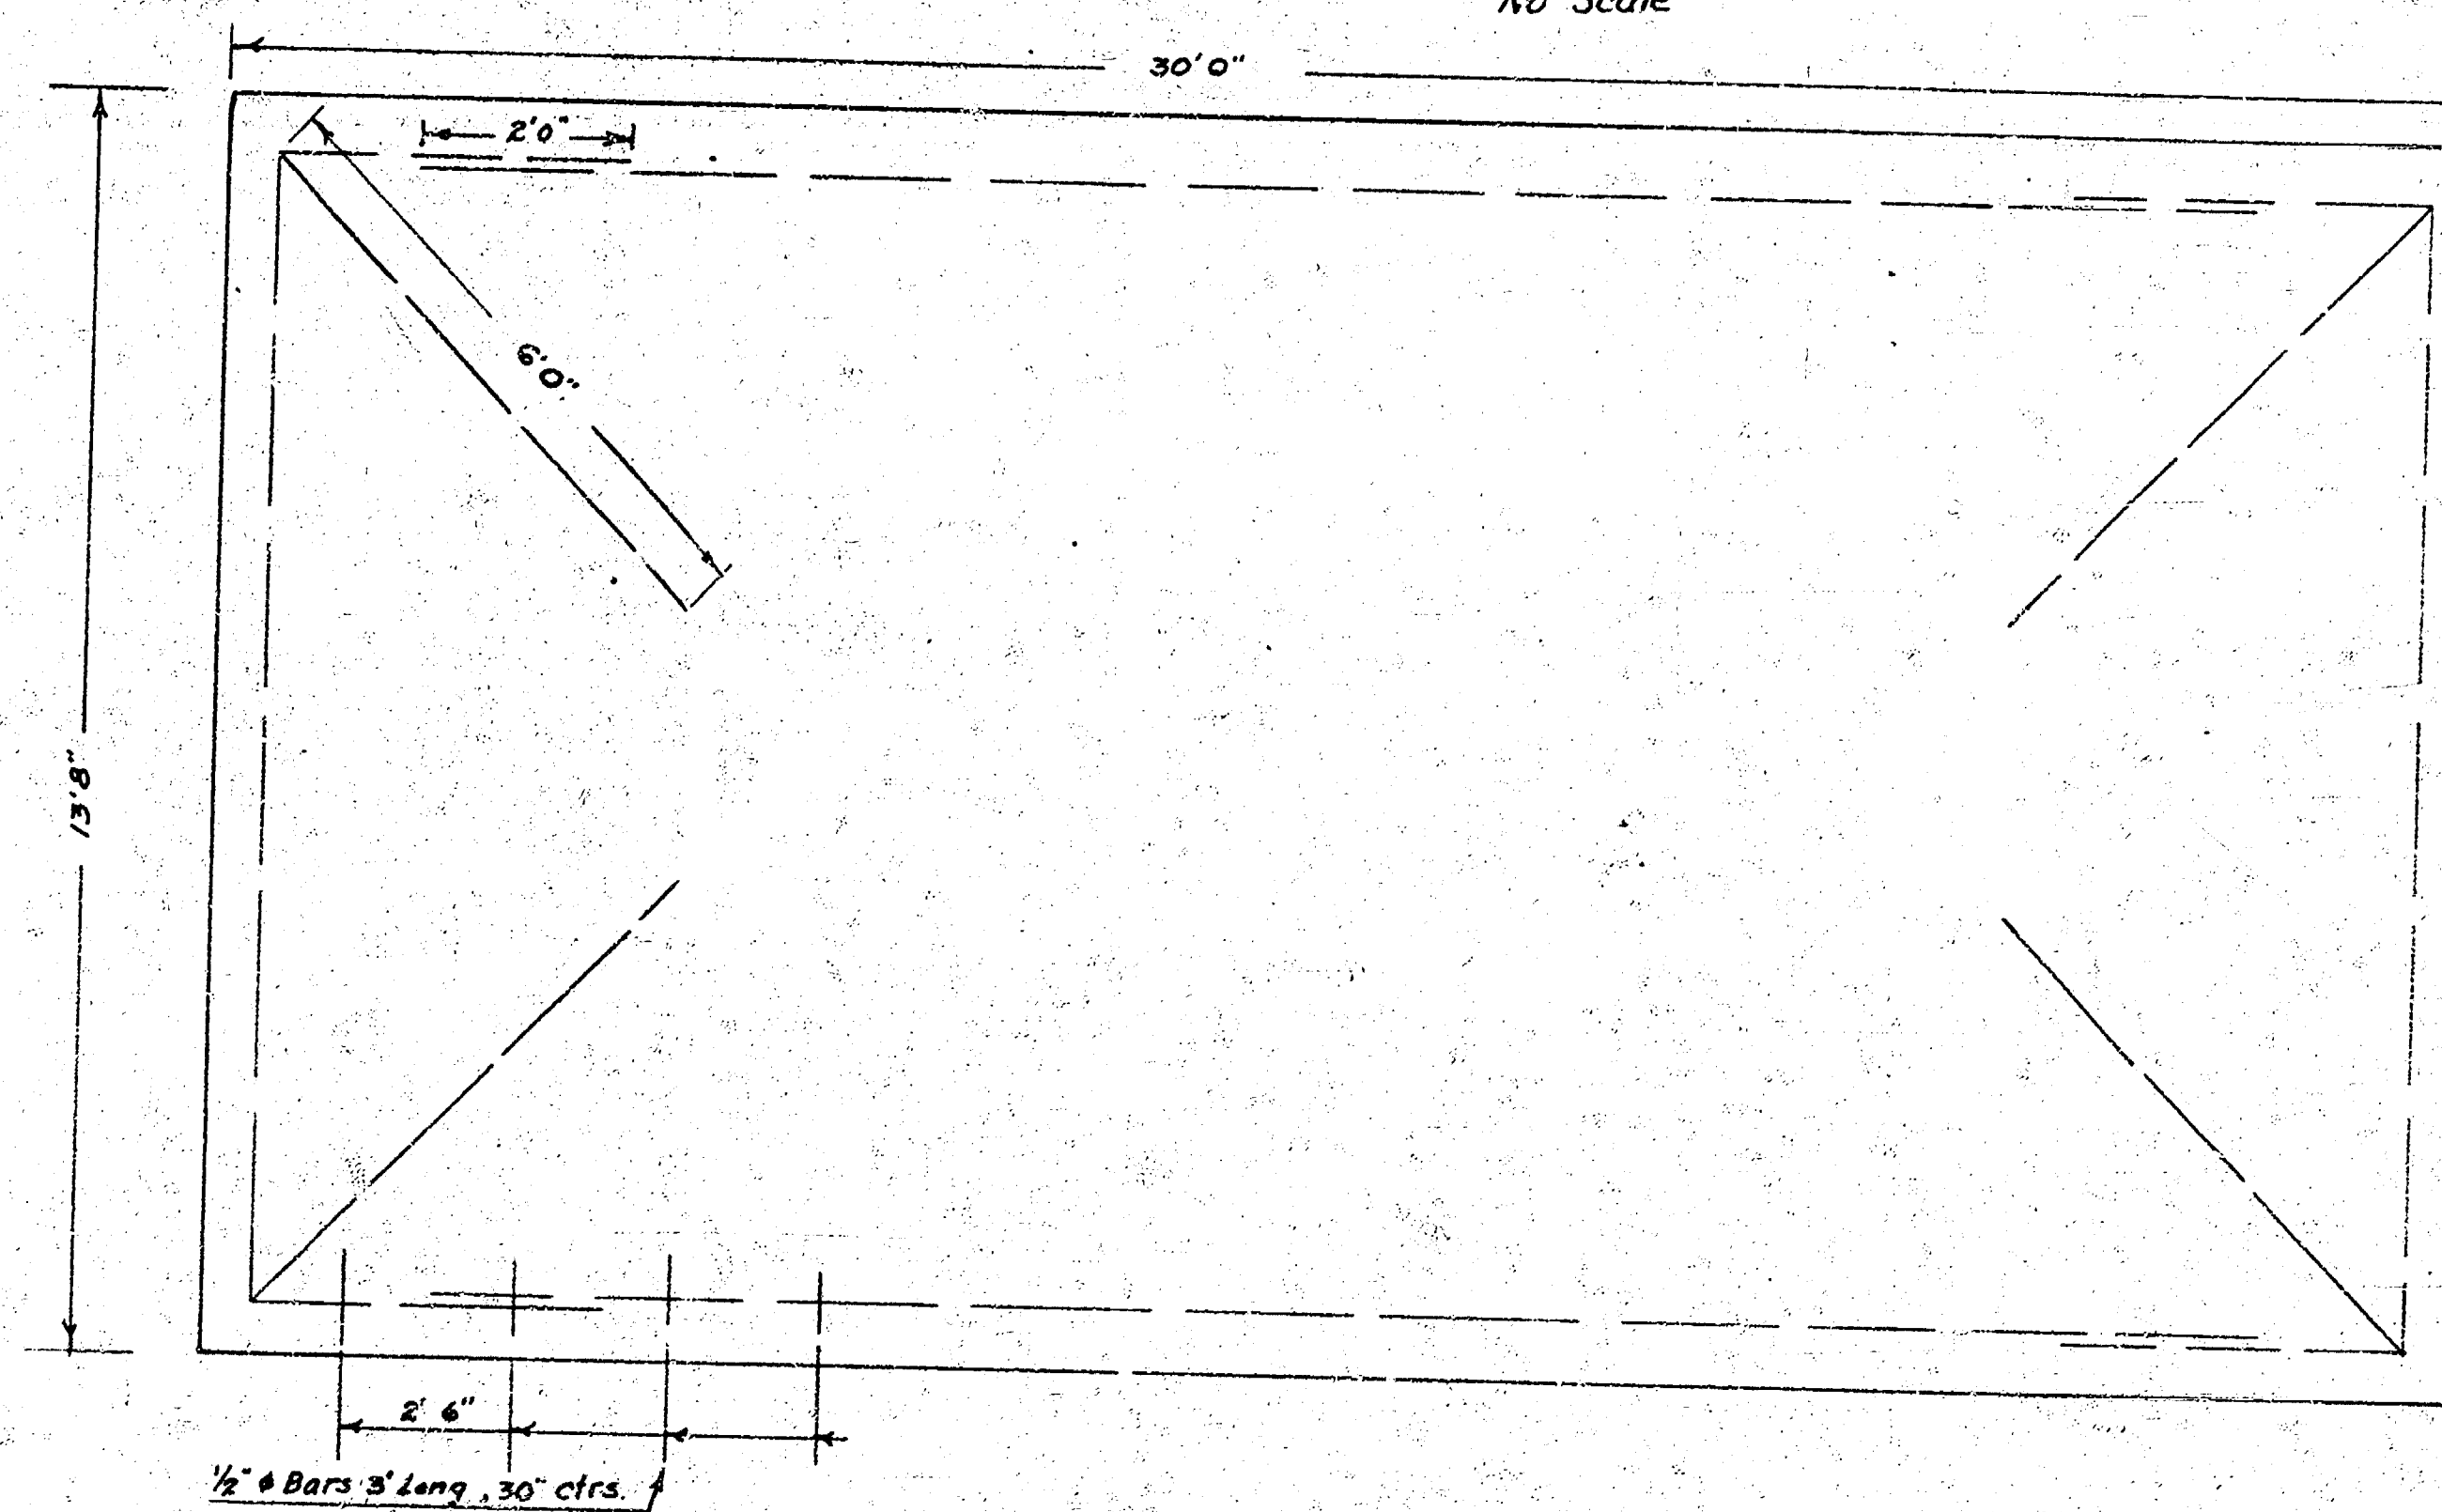

STEEL PATTERN
No Scale

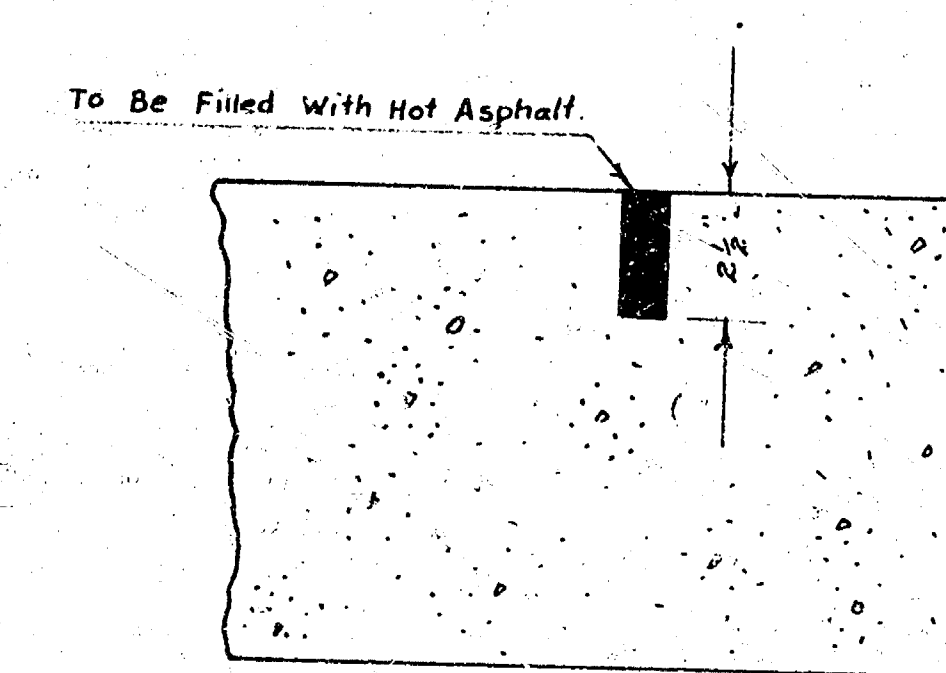

Detail of Contraction Joints
No Scale

Note To be poured in 3 sections
each 20' 6" wide which means
a keyed joint down center
3/14/54 JME
Also Traveled Center Line 8' wide
JH

