


Greenwood

PAVING PLAN - 22-2-30 CONC.

B.M. Elev. 104.06 - on S. end of curb at back of C. S.E. Cor. - Fanny & Orme.

N.L. - Indianapolis to L. Orme.

11.9% Grade Top
14.0% Bottom

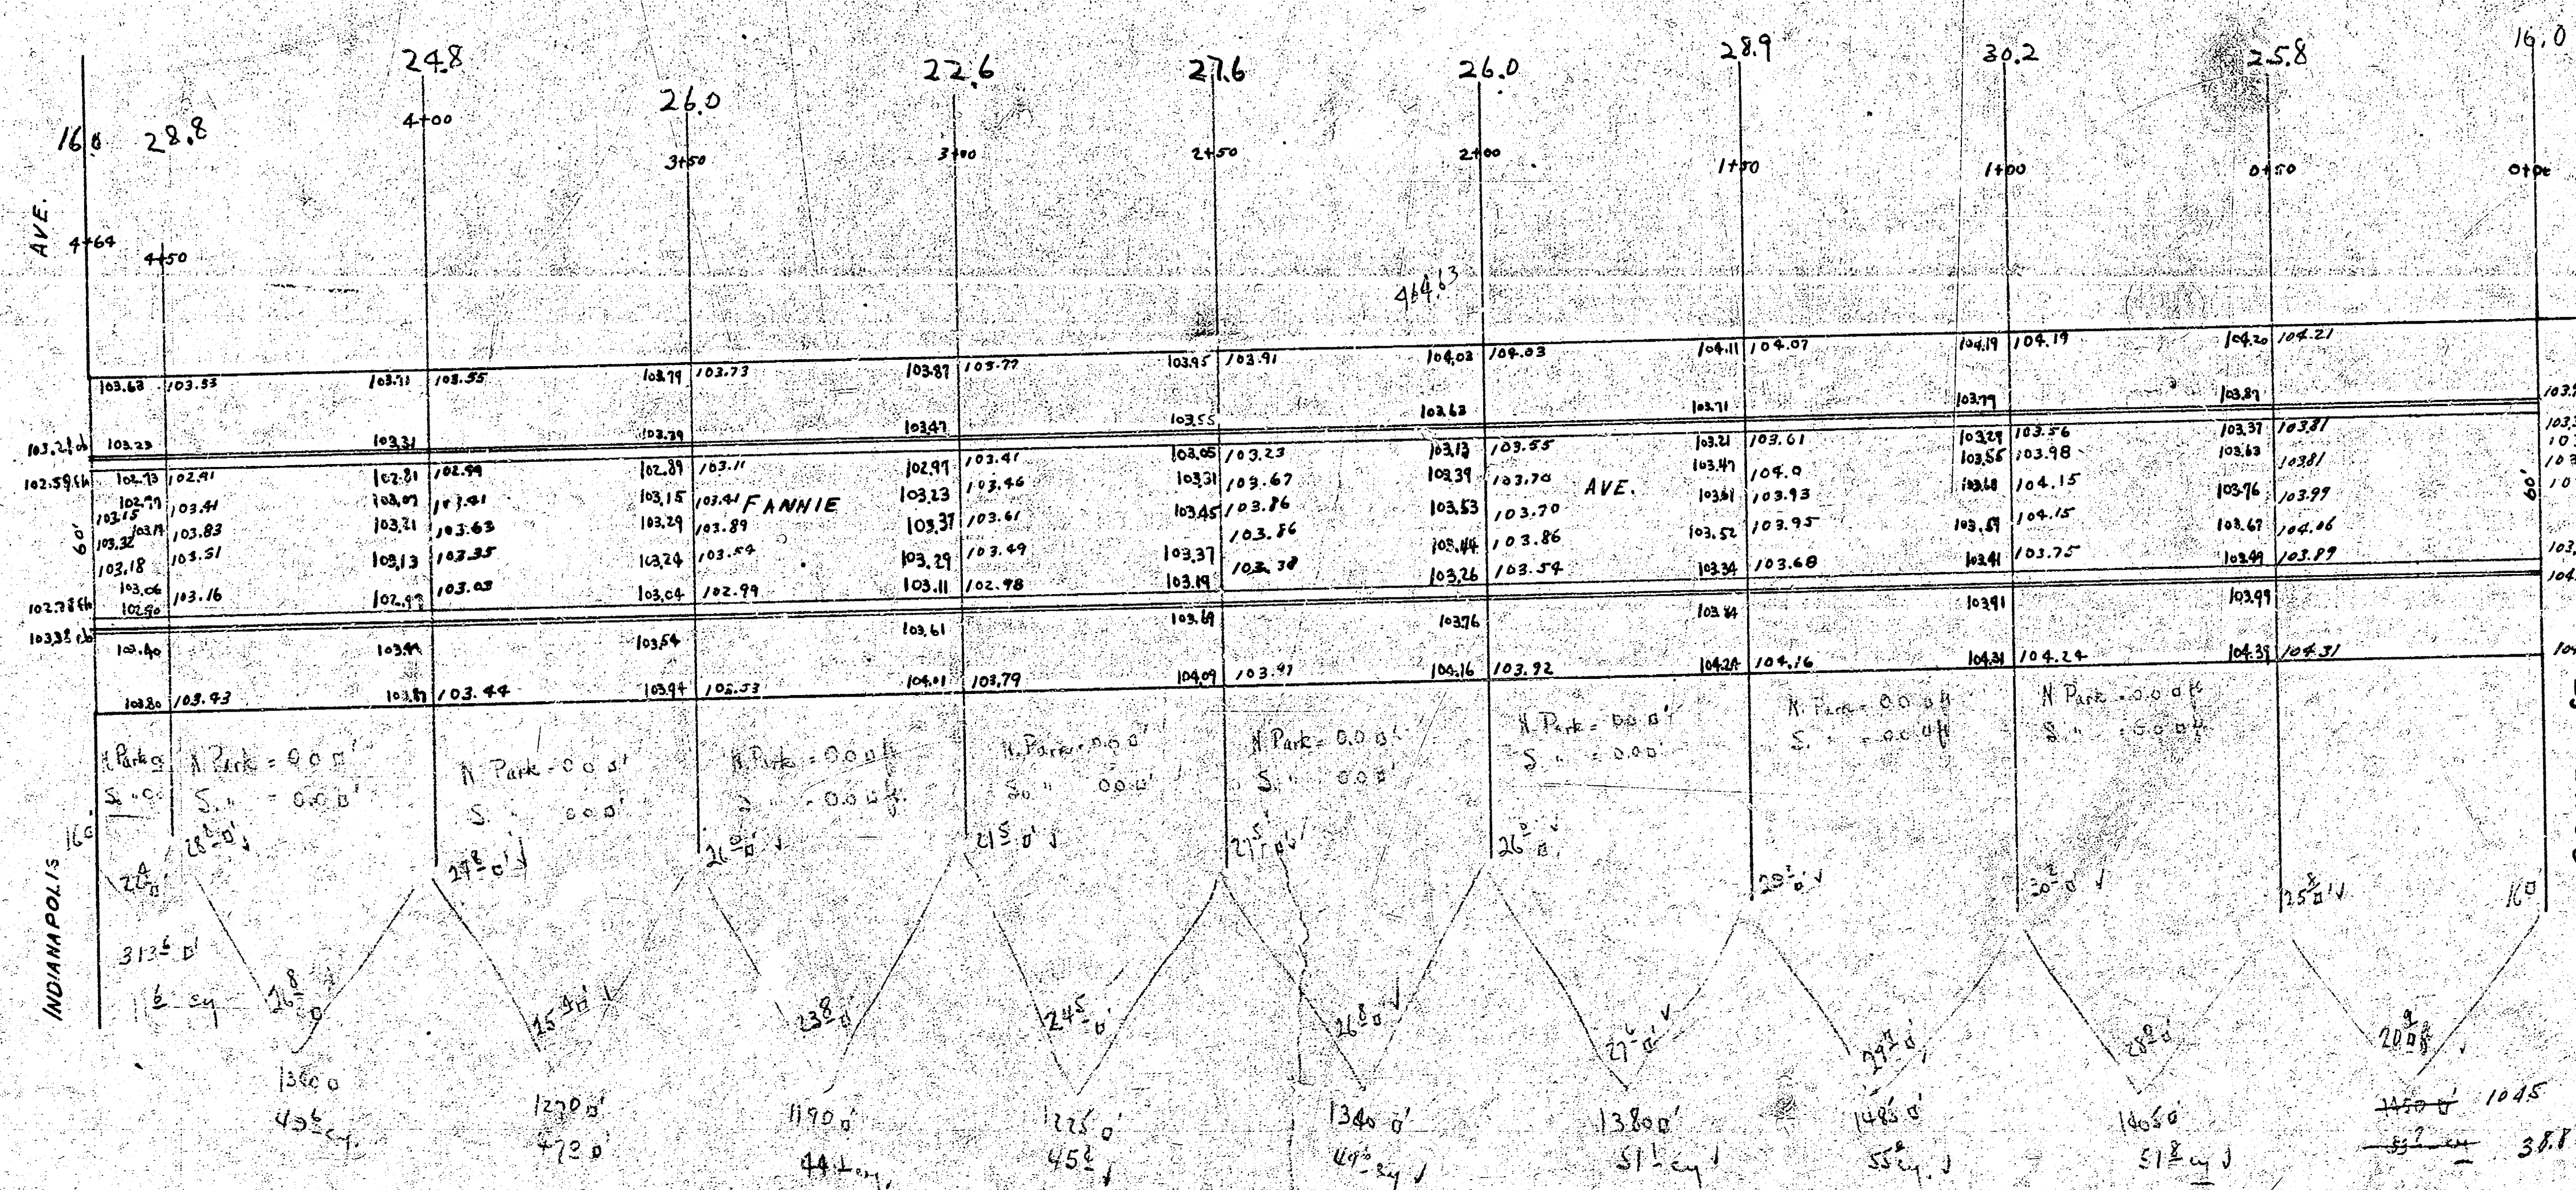

Prop 44 + 10% = 108.4