1941

GROVE ST - N.L. 9TH ST TO S.L. 12TH ST

26-2-30 5" CONC. BASE WITH 2" ASPHALTIC CONC. SURFACE

Rebuild cross walk to let water go South around NW. cor. 9th & Grove.

VG. east ½ intersection
Full Crown west ½ intersection

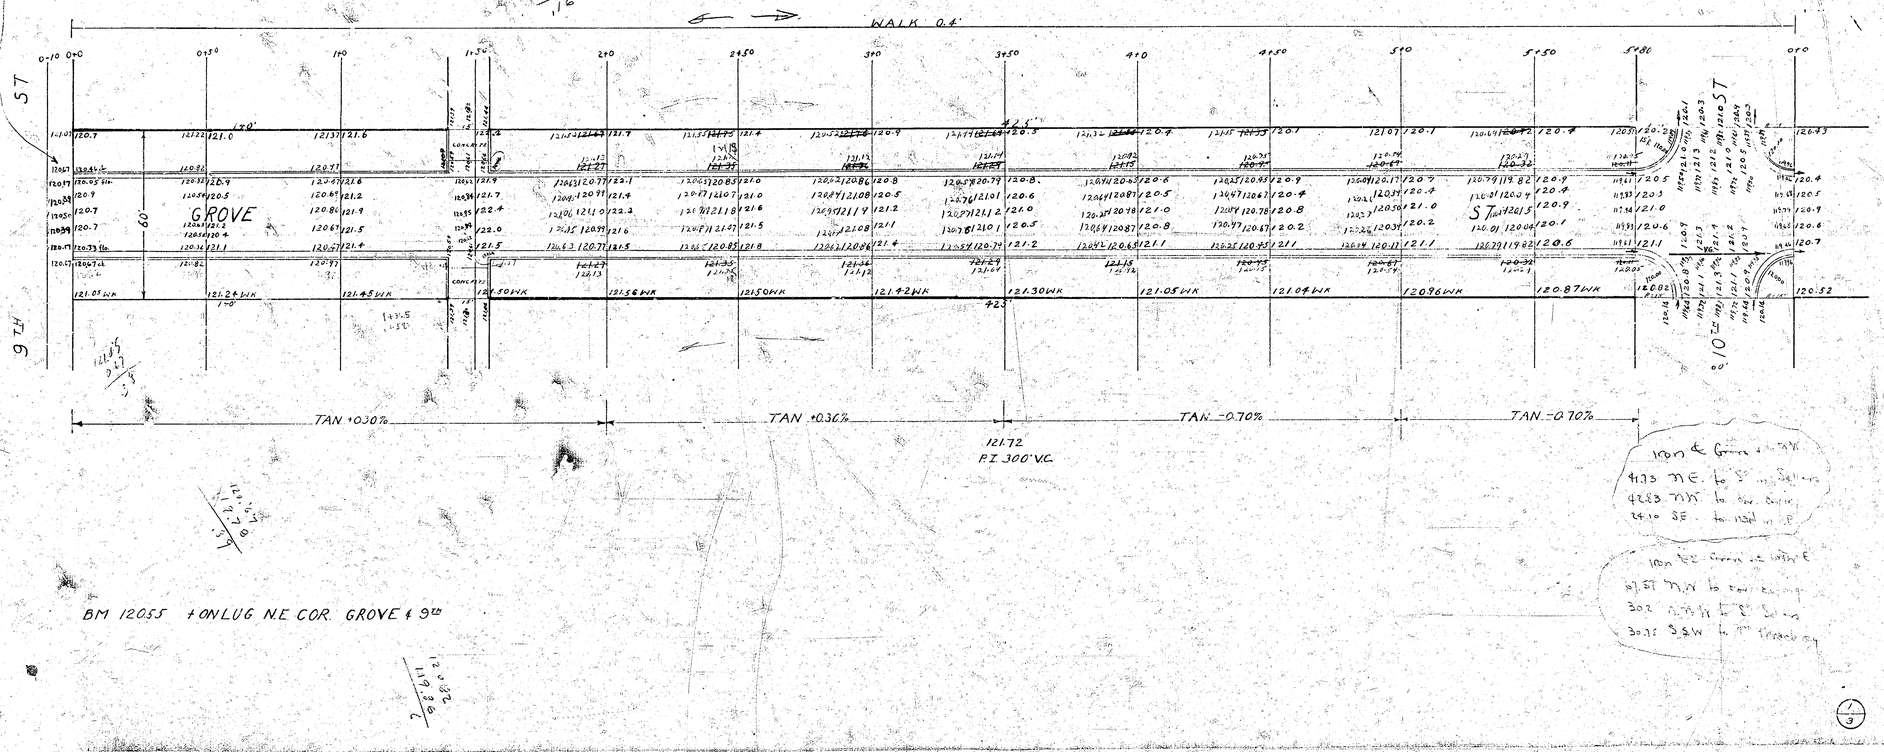

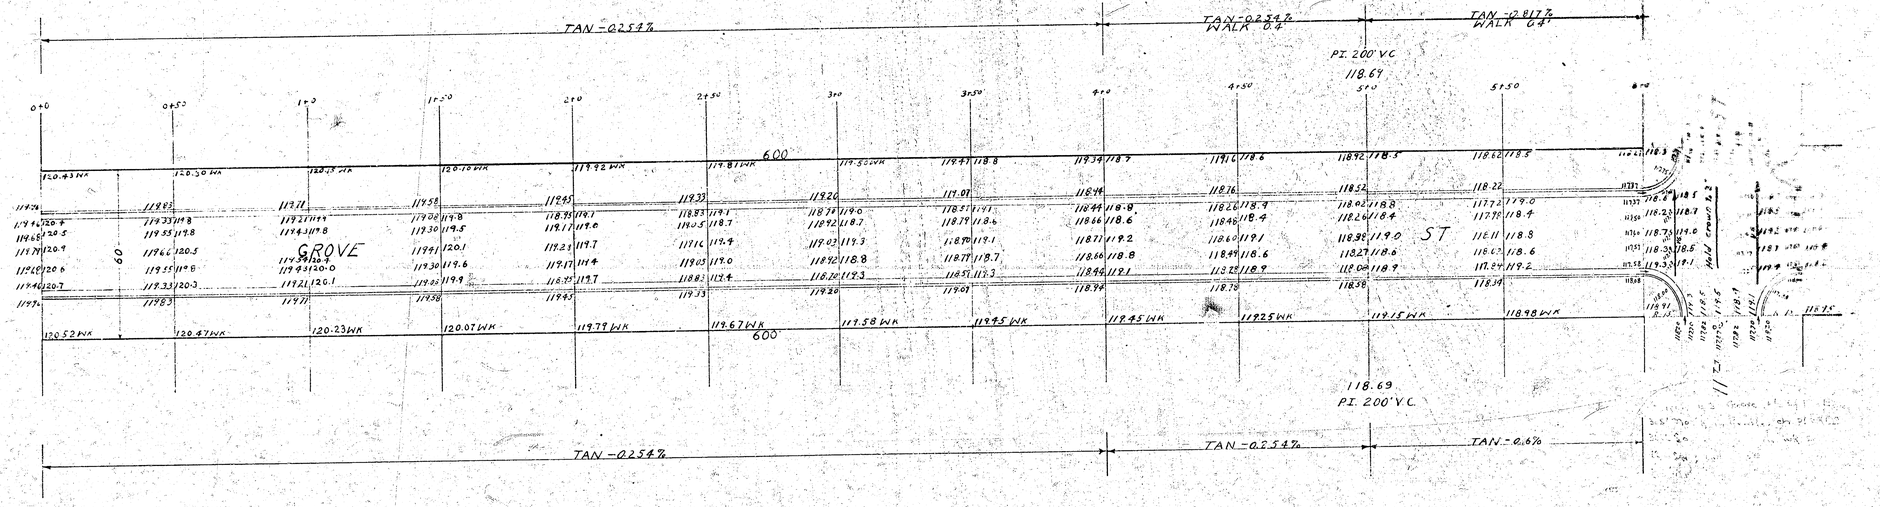

Hold crown on Grove Hat enough to meet BC's on U.S. Start 40 S & 40 N of Intersection

Grove and 11 th.

old iron on ℄ sec. in Grove and center line 11th st. W.

(1) 30' S.W. to ctr of fire hydrant
(2) 24.7' S.E. to ctr of light pole
(3) 41.3' N.E. to ctr of 4" elm tree.

Grove and 12th.

Slip iron.
On the east side of Grove and the center of 12th St. east

(1) 63.2' S.E. to N.E. cor of Bay Window # 1226
(2) 70.3' S.E. to S.W. cor of house # 1226
(3) 34.0' St. south to small elm tree.

Grove and 12th

Slip iron
on ℄ sec. line in Grove st and center line 12th W.

1. 44.4' N.E. to K in Kensler str wk. No.
2. 36.0' S. E. to K in Kensler str wk. So.

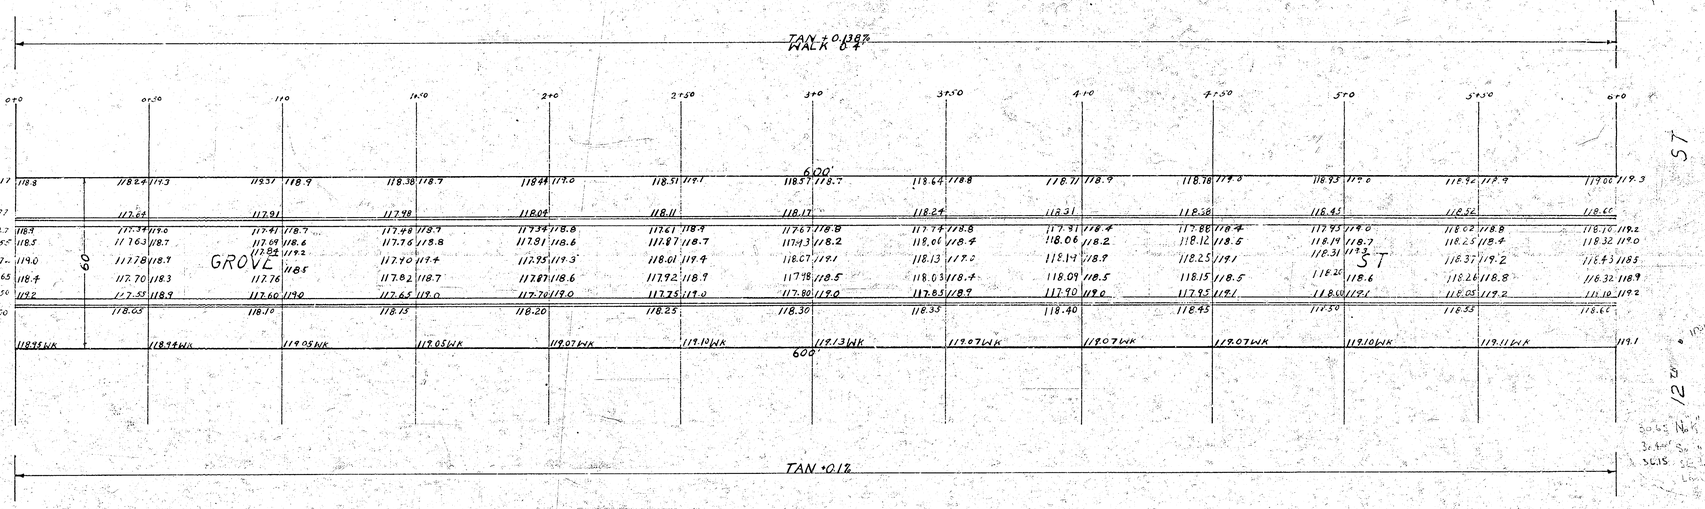

BM 119.10 K.IN KLNSLER SL.12% SE COR.