1941

GROVE ST - N.L. 9TH ST TO S.L. 12TH ST

26-2-30 5" CONC. BASE WITH 2" ASPHALTIC CONC. SURFACE

Rebuild cor enough south to let water go south around N.W. cor. 9th & Grove.

V.G. east ½ intersection
Full Grown west ½ intersection

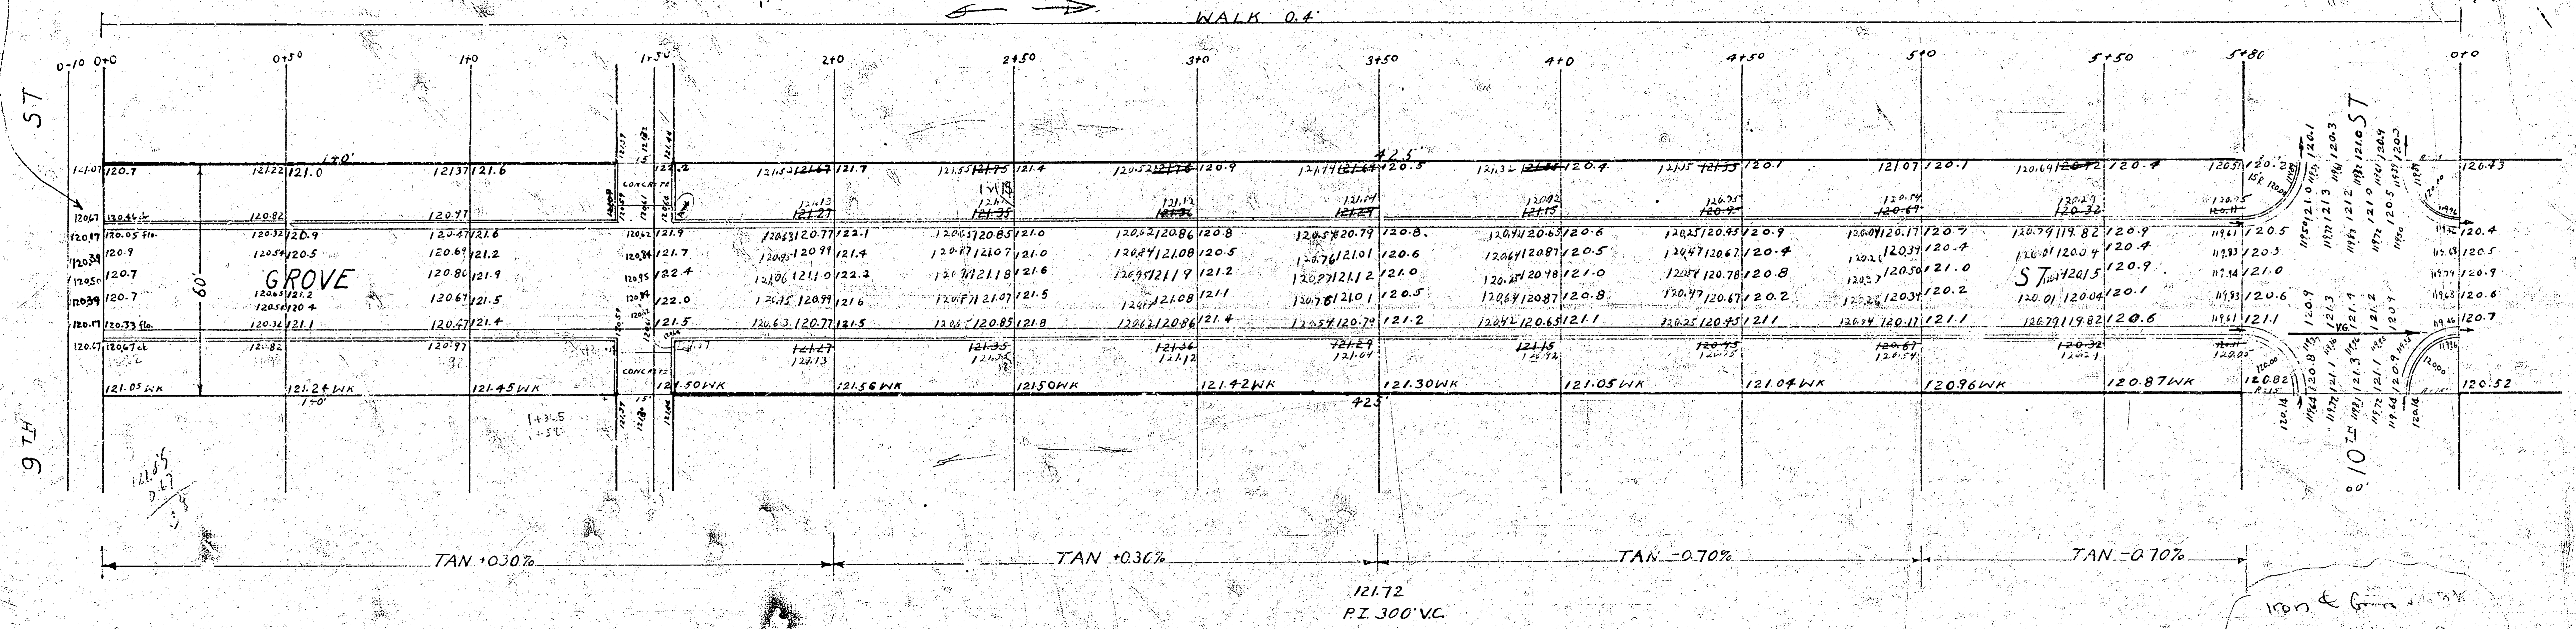

WALK 0.4'
0-10
0+0
0+50
1+0
1+50
2+0
2+50
3+0
3+50
4+0
4+50
5+0
5+50
5+80
0+0
9TH ST
GROVE ST
10TH ST
60'
10'
42.5'
42.5'
121.50 WK
121.56 WK
121.50 WK
121.42 WK
121.30 WK
121.05 WK
121.04 WK
120.96 WK
120.87 WK
120.52
120.43
CONC.
TAN +0.30%
TAN +0.30%
TAN -0.70%
TAN -0.70%
121.72
P.I. 300' V.C.

Iron & Grove ...
41.33 N.E. to S... Sellers
42.83 N.W. to ... ...
24.10 S.E. to nail in ...

Iron ... Grove ...
67.57 N.W. to ...
30.2 N.N.W. to S. Sellers
30.75 S.S.W. to ...

BM 12055 + ON LUG N.E. COR. GROVE & 9th

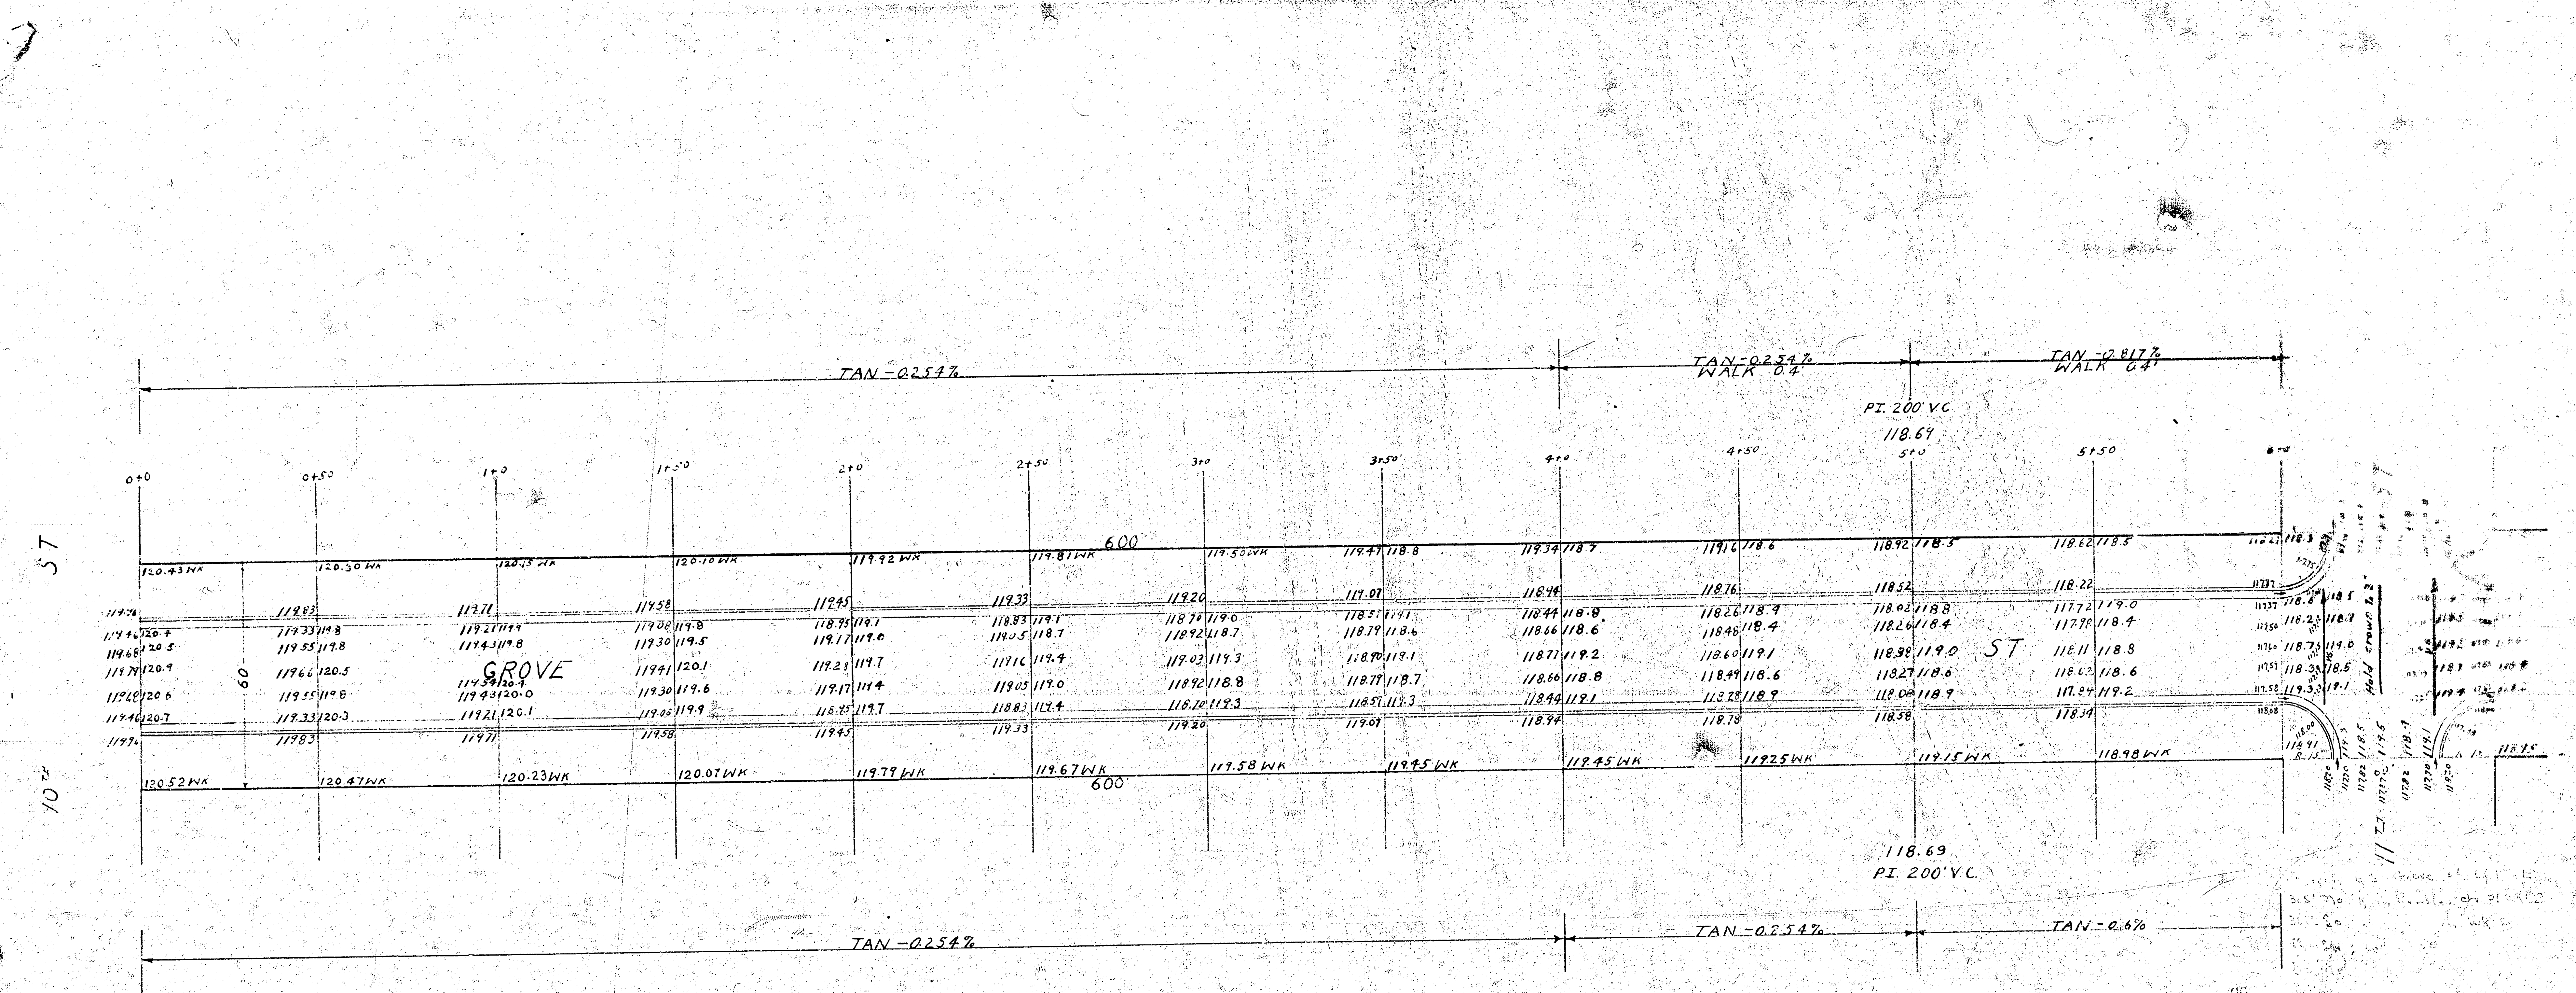
TAN -0.254%
TAN -0.234% WALK 0.4'
TAN -0.817% WALK 6.4'
P.I. 200' V.C.
118.69
0+0
0+50
1+0
1+50
2+0
2+50
3+0
3+50
4+0
4+50
5+0
5+50
6+0
600
120.43WK
120.30WK
120.15WK
120.10WK
119.92WK
119.81WK
119.50WK
GROVE
ST
60'
120.52WK
120.47WK
120.23WK
120.07WK
119.79WK
119.67WK
119.58WK
119.45WK
119.45WK
119.25WK
119.15WK
118.98WK
118.69
P.I. 200' V.C.
TAN -0.254%
TAN -0.254%
TAN -0.6%
ST
10th

Held crown on Grove flat
enough to meet VC's on 11th
Start 40 S & 40 N of Intersection.

Grove and 11 th.

old iron on ½ sec. in Grove and center line 11th st. W.

(1) 30' S.W. to ctr of fire hydrant
(2) 24.7' S.E. to ctr of light pole
(3) 41.3' N.E. to ctr of 4" elm tree.

Grove and 12th.

Slip Mon.
On the east side of Grove and the center of 12th St. east

(1) 63.2' S.E. to N.E. cor of Bay Window # 1258
(2) 70.3' S.E. to S.W. cor of house # 1258
(3) 34.0' St. south to small elm tree.

Grove and 12th

Slip iron
on ½ sec. line in Grove st and center line 12th W.

1. 44.4' N.E. to K in Kensler ctr wk. No.
2. 38.0 S. E. to K in Kensler str wk. So.

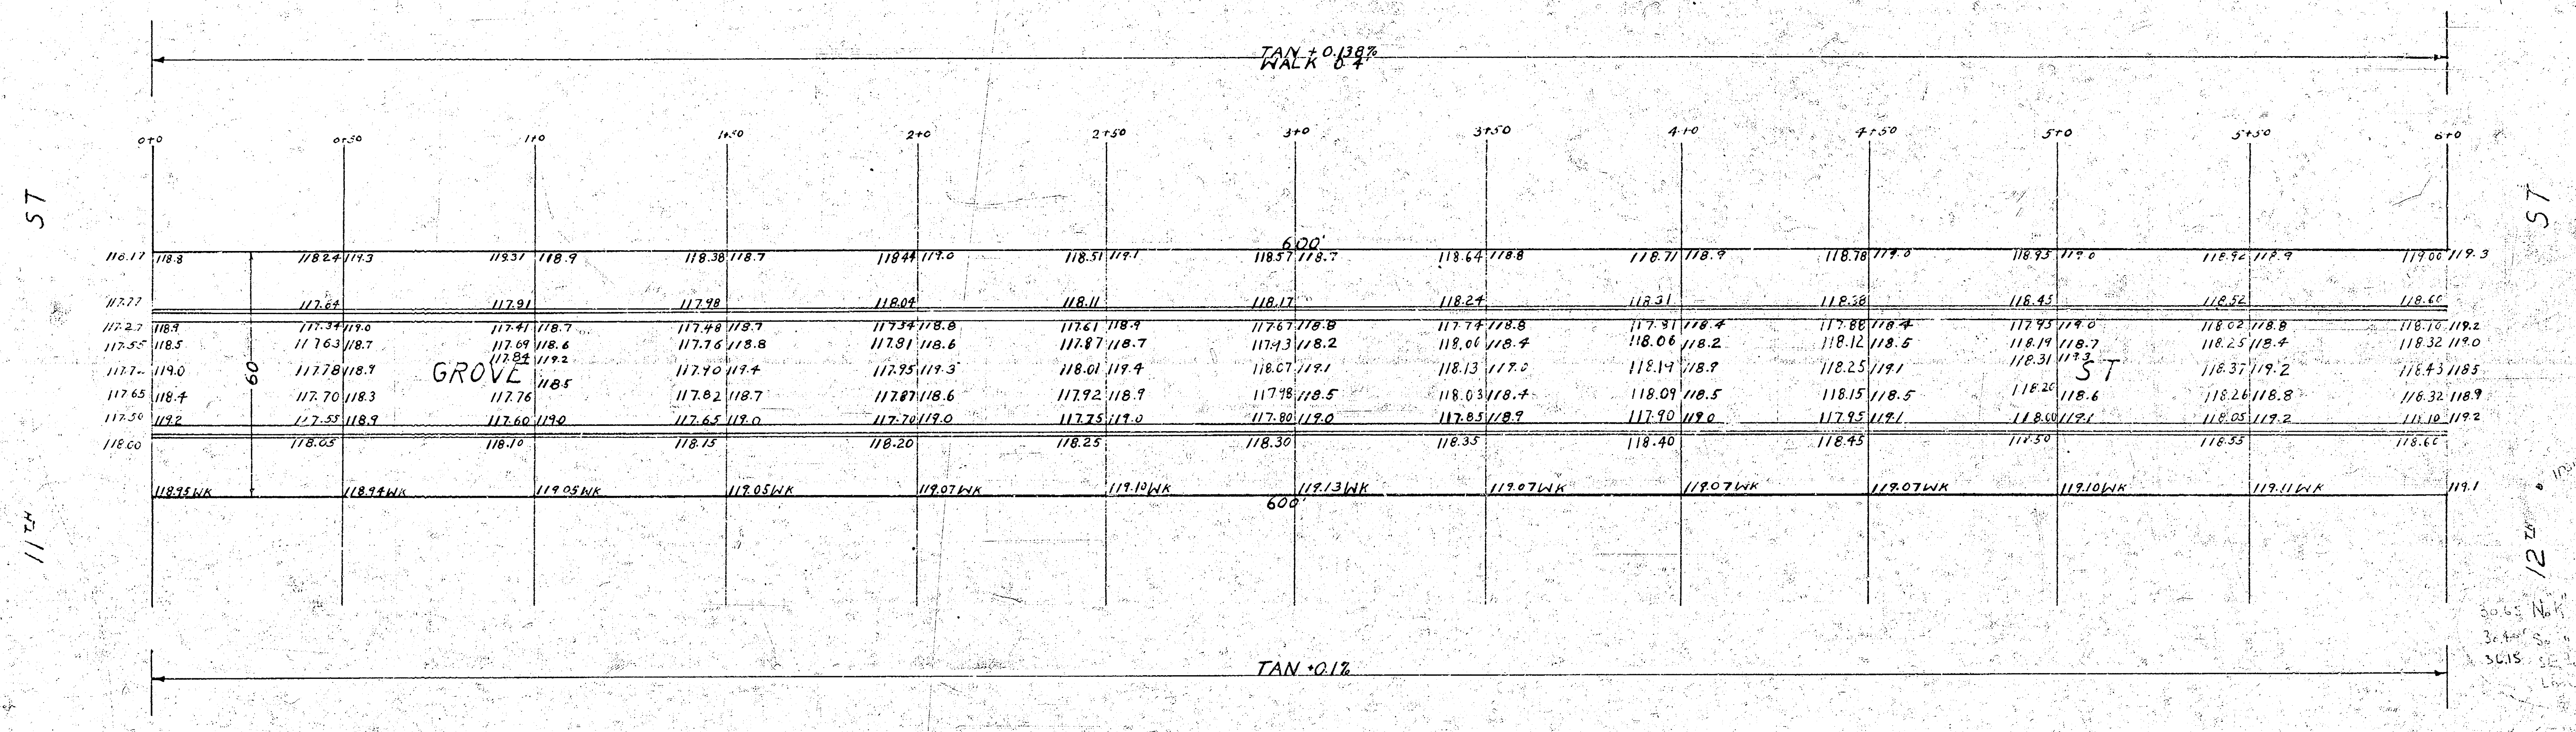
TAN +0.138%
WALK 0.4'
0+0 0+50 1+0 1+50 2+0 2+50 3+0 3+50 4+0 4+50 5+0 5+50 6+0
600'
116.17 118.8 118.24 119.3 119.31 118.9 118.38 118.7 118.44 119.0 118.51 119.1 118.57 118.7 118.64 118.8 118.71 118.9 118.78 119.0 118.95 119.0 118.92 118.9 119.00 119.3
117.77 117.64 117.91 117.98 118.04 118.11 118.17 118.24 118.31 118.38 118.45 118.52 118.60
117.27 118.9 117.34 119.0 117.41 118.7 117.48 118.7 117.34 118.8 117.61 118.9 117.67 118.8 117.74 118.8 117.81 118.4 117.88 118.4 117.95 119.0 118.02 118.8 118.10 119.2
117.55 118.5 117.63 118.7 117.69 118.6 117.76 118.8 117.81 118.6 117.87 118.7 117.93 118.2 118.06 118.4 118.06 118.2 118.12 118.5 118.19 118.7 118.25 118.4 118.32 119.0
117.7 119.0 117.78 118.9 117.84 119.2 117.90 119.4 117.95 119.3 118.01 119.4 118.07 119.1 118.13 119.0 118.19 118.9 118.25 119.1 118.31 119.3 118.37 119.2 118.43 118.5
117.65 118.4 117.70 118.3 117.76 118.5 117.82 118.7 117.87 118.6 117.92 118.9 117.98 118.5 118.03 118.4 118.09 118.5 118.15 118.5 118.20 118.6 118.26 118.8 118.32 118.9
117.50 119.2 117.55 118.9 117.60 119.0 117.65 119.0 117.70 119.0 117.75 119.0 117.80 119.0 117.85 118.9 117.90 119.0 117.95 119.1 118.00 119.1 118.05 119.2 118.10 119.2
118.00 118.05 118.10 118.15 118.20 118.25 118.30 118.35 118.40 118.45 118.50 118.55 118.60
118.95WK 118.94WK 119.05WK 119.05WK 119.07WK 119.10WK 119.13WK 119.07WK 119.07WK 119.07WK 119.10WK 119.11WK 119.1
60
GROVE ST
600'
11TH ST
12TH ST
TAN 0.1%

30.65 No K [illegible]
30.45 So [illegible]
36.15 SE to NE cor of [illegible]
[illegible]

BM 119.10 K. IN KINSLER SL. 12TH SE COR.