


Survey 1961
 E.C.
 Checked 10/10/61

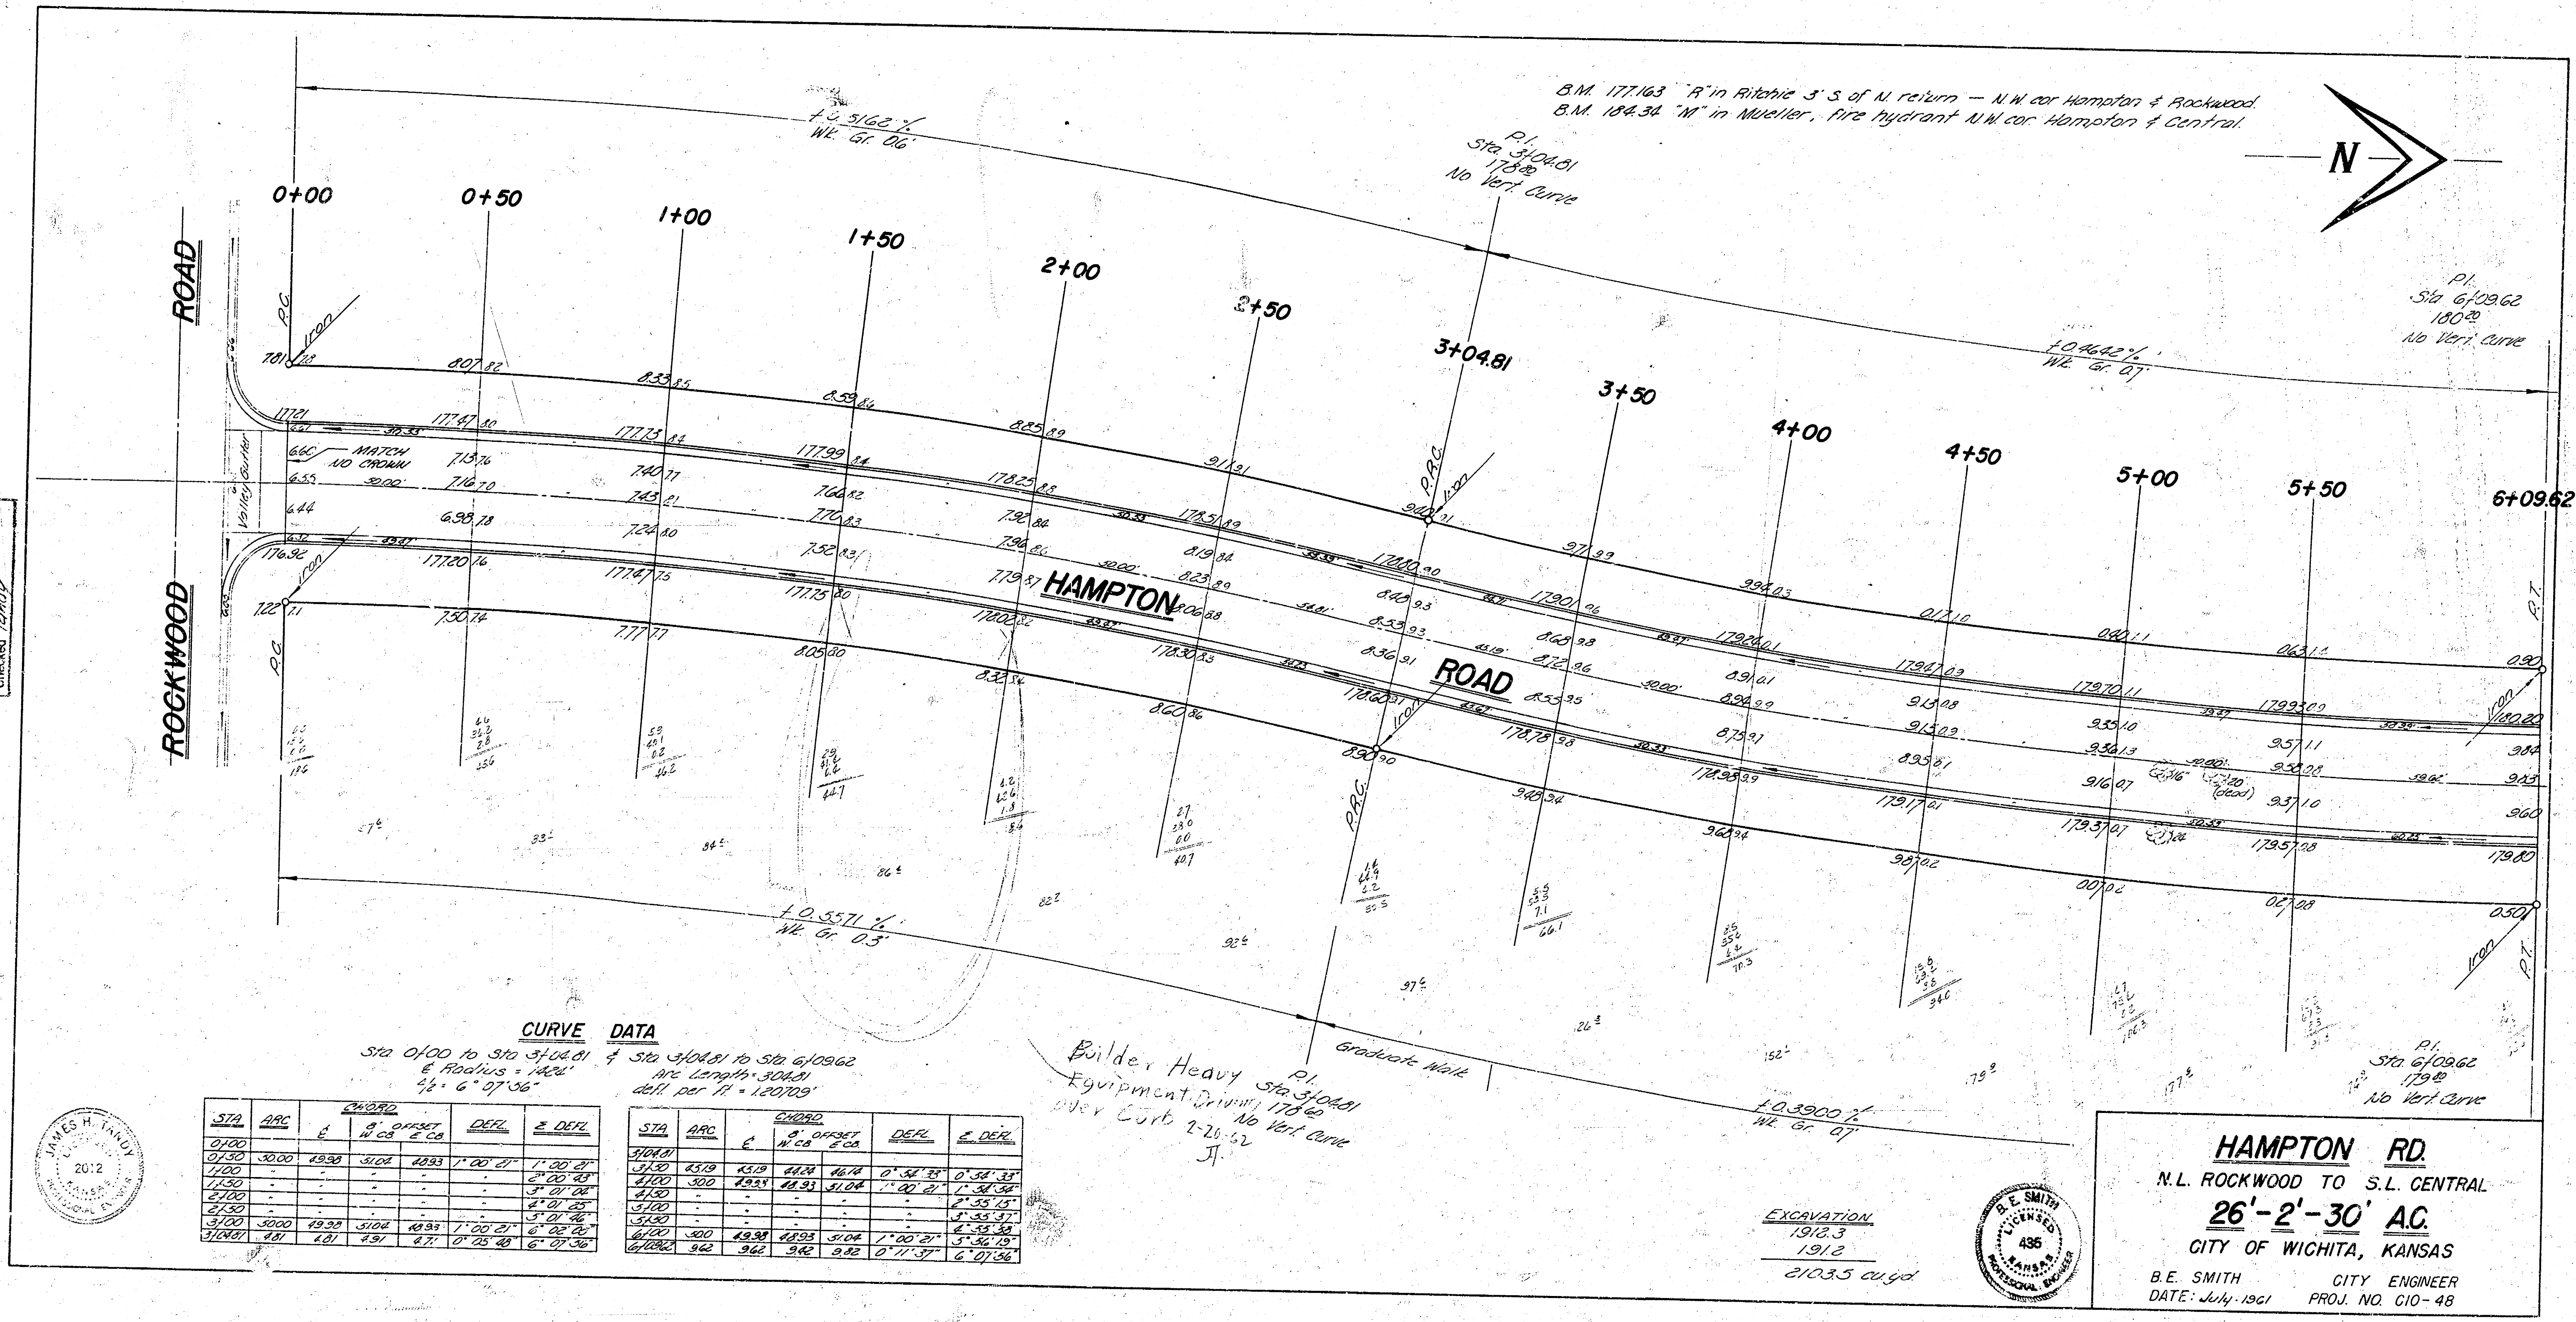


CURVE DATA
 Sta 0+00 to Sta 3+04.81
 Δ = 6° 07' 36"

STA	ARC	E	CHORD	DELTA	E DELTA


 Station 3+04.81
 No Vert Curve
 J.I.

EXCAVATION

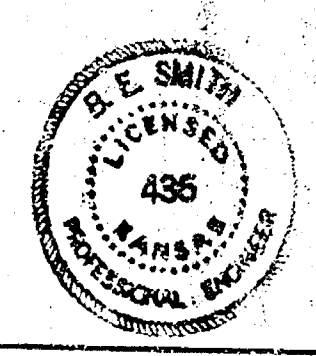

HAMPTON RD.
 N.L. ROCKWOOD TO S.L. CENTRAL
26'-2'-30' AC.
 CITY OF WICHITA, KANSAS
 B.E. SMITH CITY ENGINEER
 DATE: July, 1961 PROJ. NO. C10-48

