



PAVING PLAN 1943
HARDING - SL PINE to NL ELM STREETS
26' CONCRETE

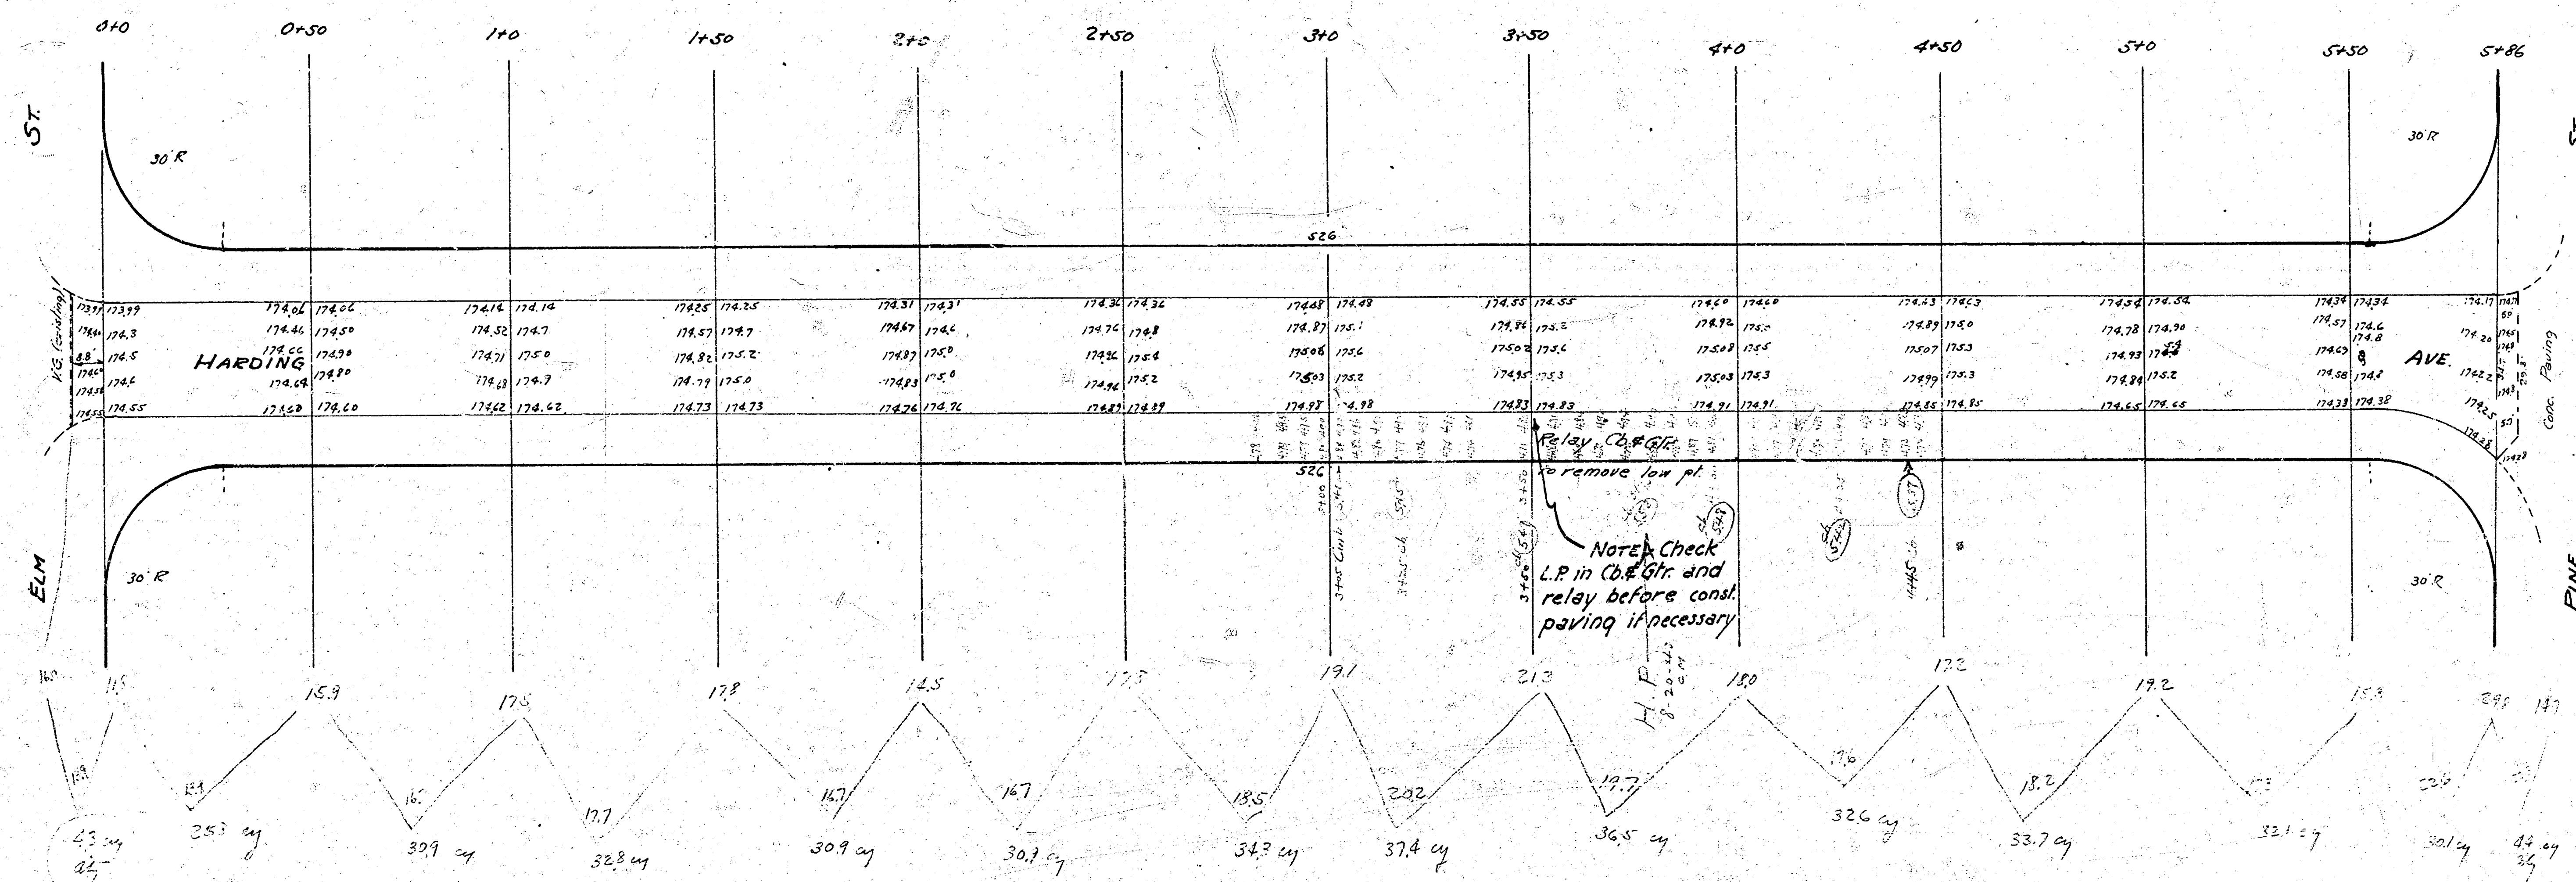

B.M. Elev. 174.04 - W in H.P.A. N. of Elm S.W. of NL Harding

Proposed 302.0 sq ft
Total 426.8 sq ft
Total 57.2 sq ft

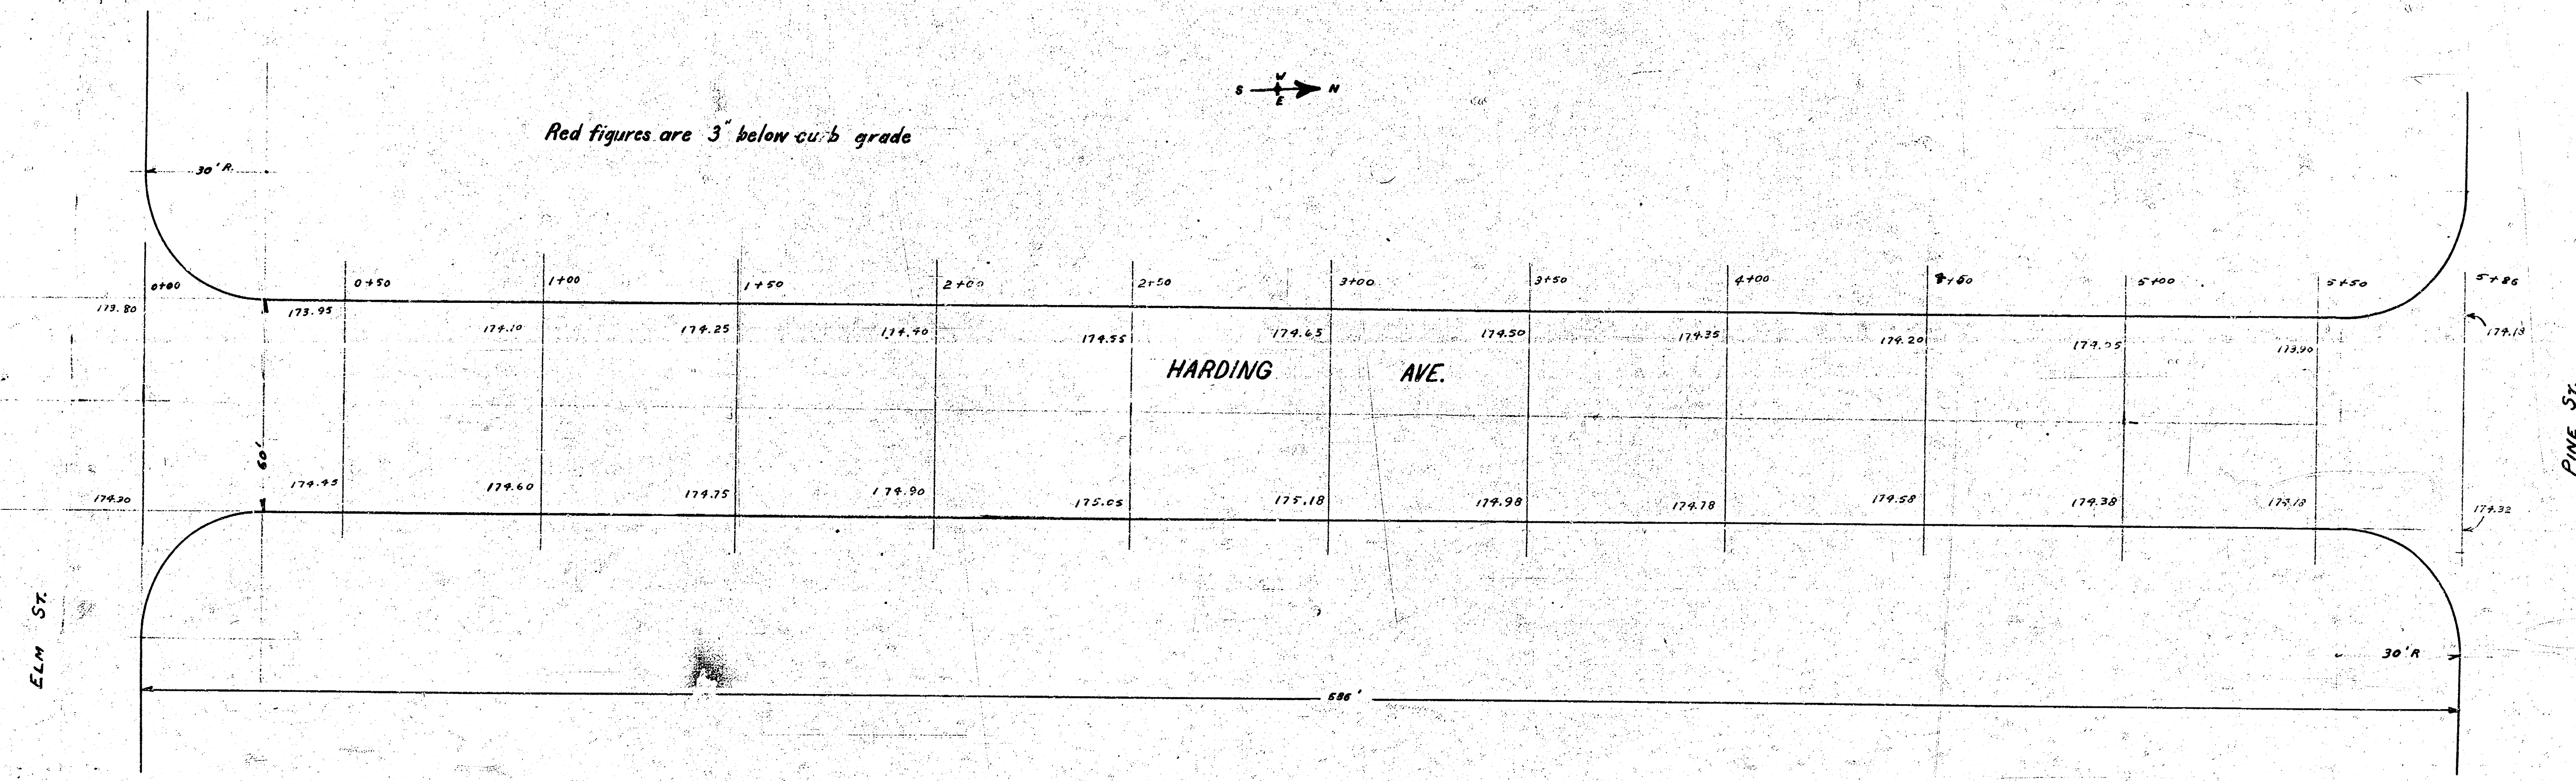

Curb & Gutter only

Returns + V.G. included in Econ St. estimates

