


B.M. 17299 SW Cor Stone Slab on Brick Monument, N.E. Hampton & 10' S. of S.L. Cresthill Manor Addition
Baseline & Stationing on West Property Line.

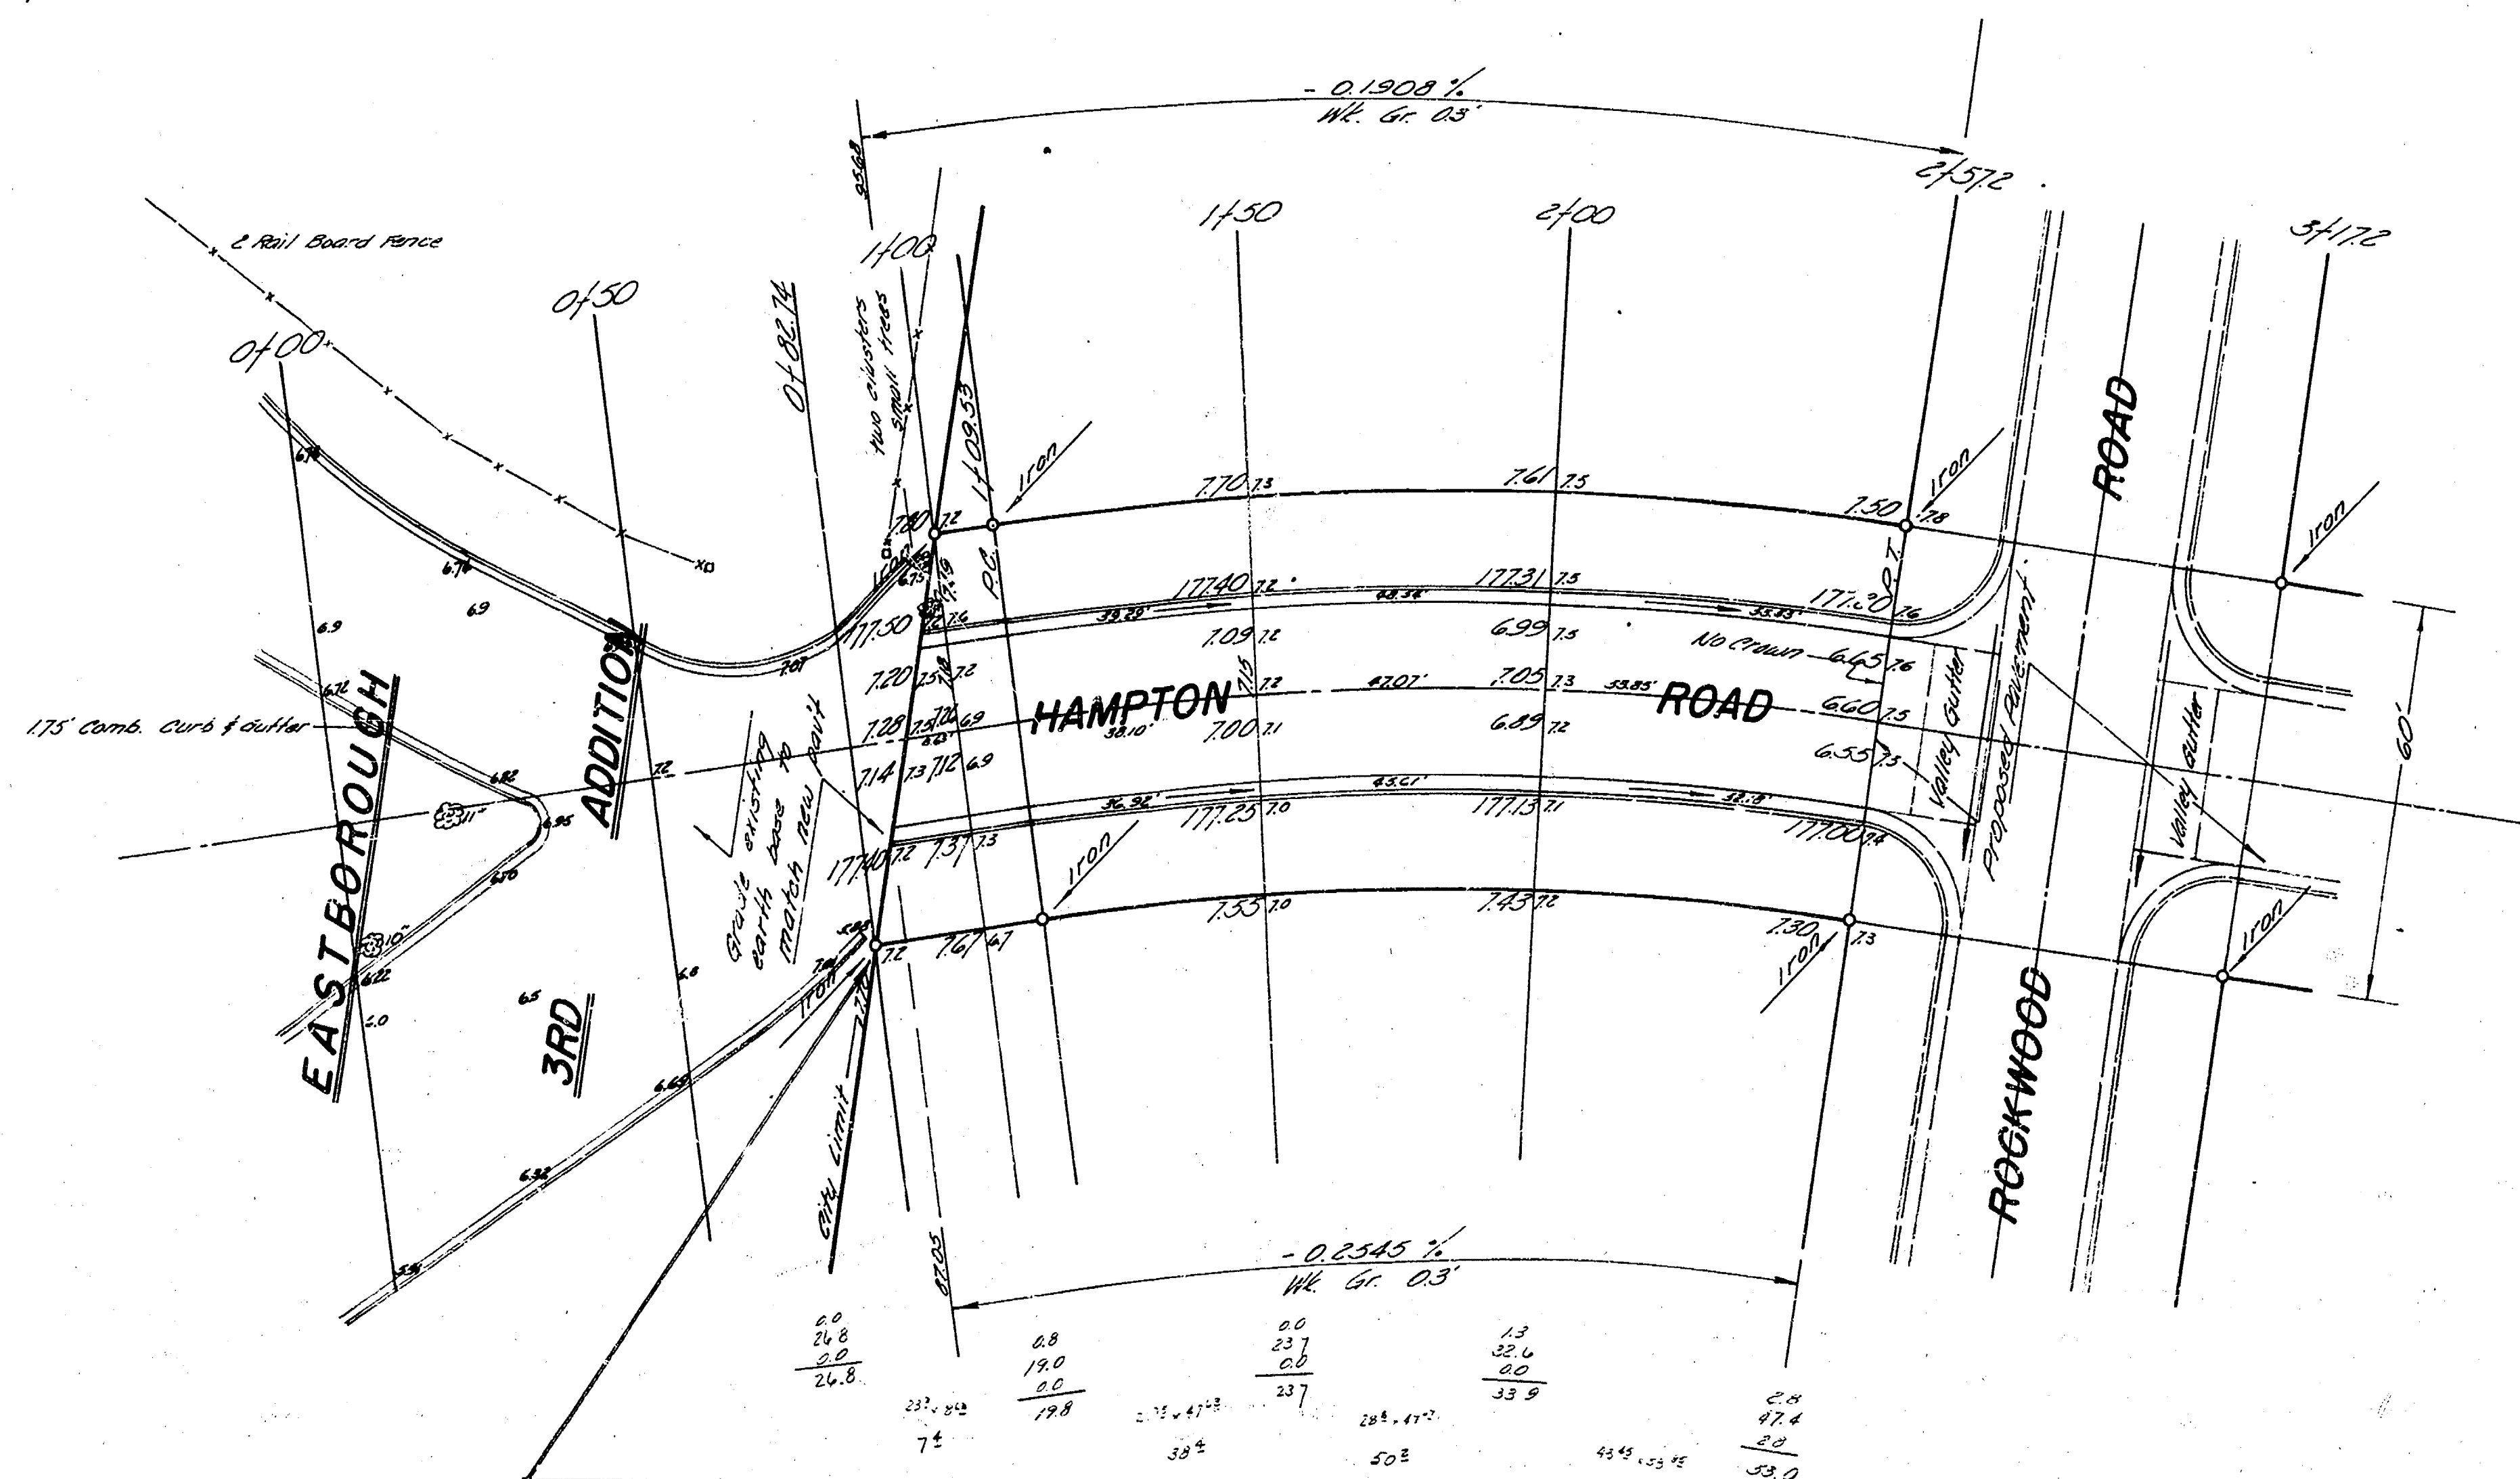



Curve Data on N. & S.

Δ = 16° 32' 00" R = 138.78' Δ = 32° 00' R = 53.5007

Sta	Atc	Chord	Chord	Deflection	Point	Den

Note to Field Engineer
This plan is incorrectly located
& shall not be used when setting
stakes for the project. If you desire
to re-locate iron, see Bl. 17299.33, page 53
& the original plat of Cresthill Manor.

Excavation
18.3
2010 cu yd.

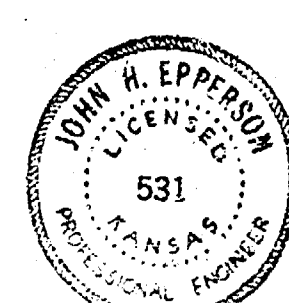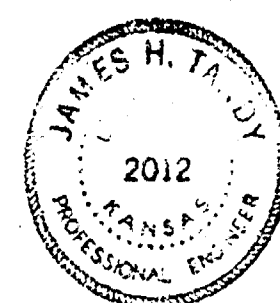

HAMPTON RD.
S.L. LOT 1, BLK. 6, CRESTHILL MANOR
ADDN. TO S.L. ROCKWOOD
26'-2'-30' A.C.
CITY OF WICHITA, KANSAS
B.E. SMITH CITY ENGINEER
DATE: JULY 1920, PROJ. NO. CIO-49