
1

PAVING PLAN 1943
HARDING AVE. – S.L. MURDOCK to N.L. PINE ST.
26' CONC.

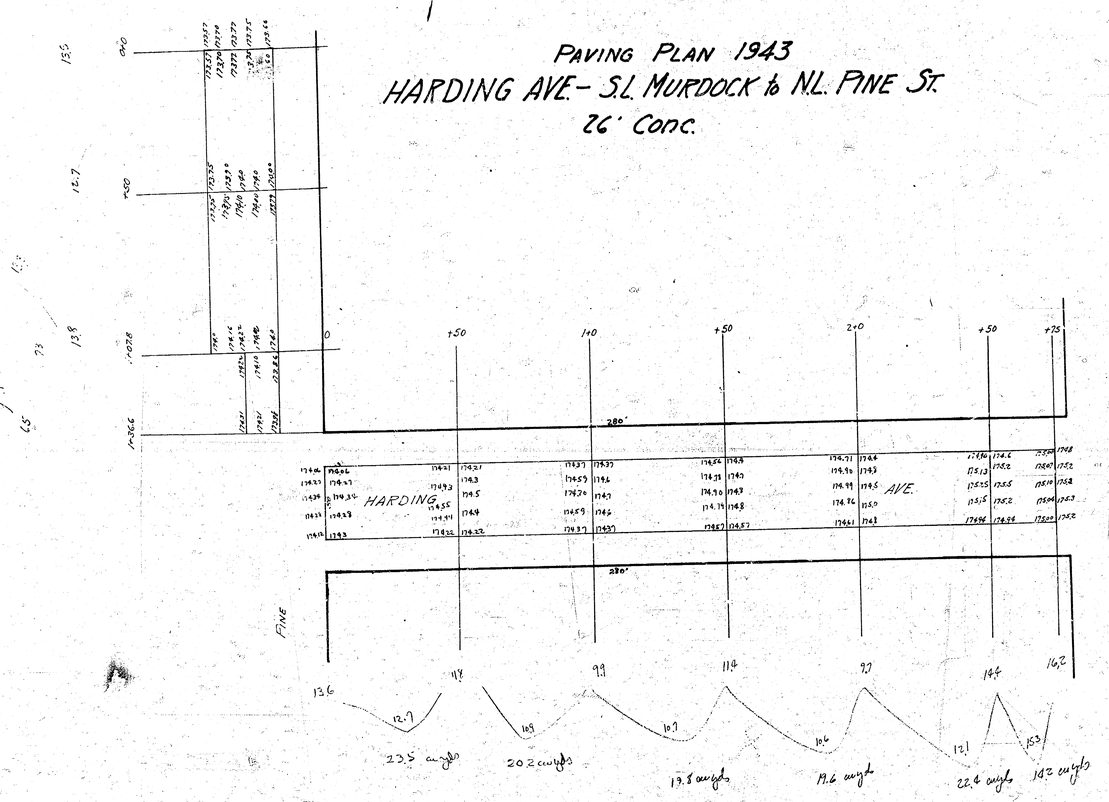

Pavement = 112.7 sq yds
+12" = 11.9
Total = 131.6 sq yds

Sidewalk = 56.3 sq yds
+10" = 5.6
Total = 61.9 sq yds