
Survey Hanson Bk 7A136
Plan Greene
Field Check
Checked JF

BM:- 109.23 Standard SW cor. Sheridan & Harry
Chaining E on ℄ Harry.
Sta. 2+00 - ℄ Main Line R.R. - Starting point of survey.

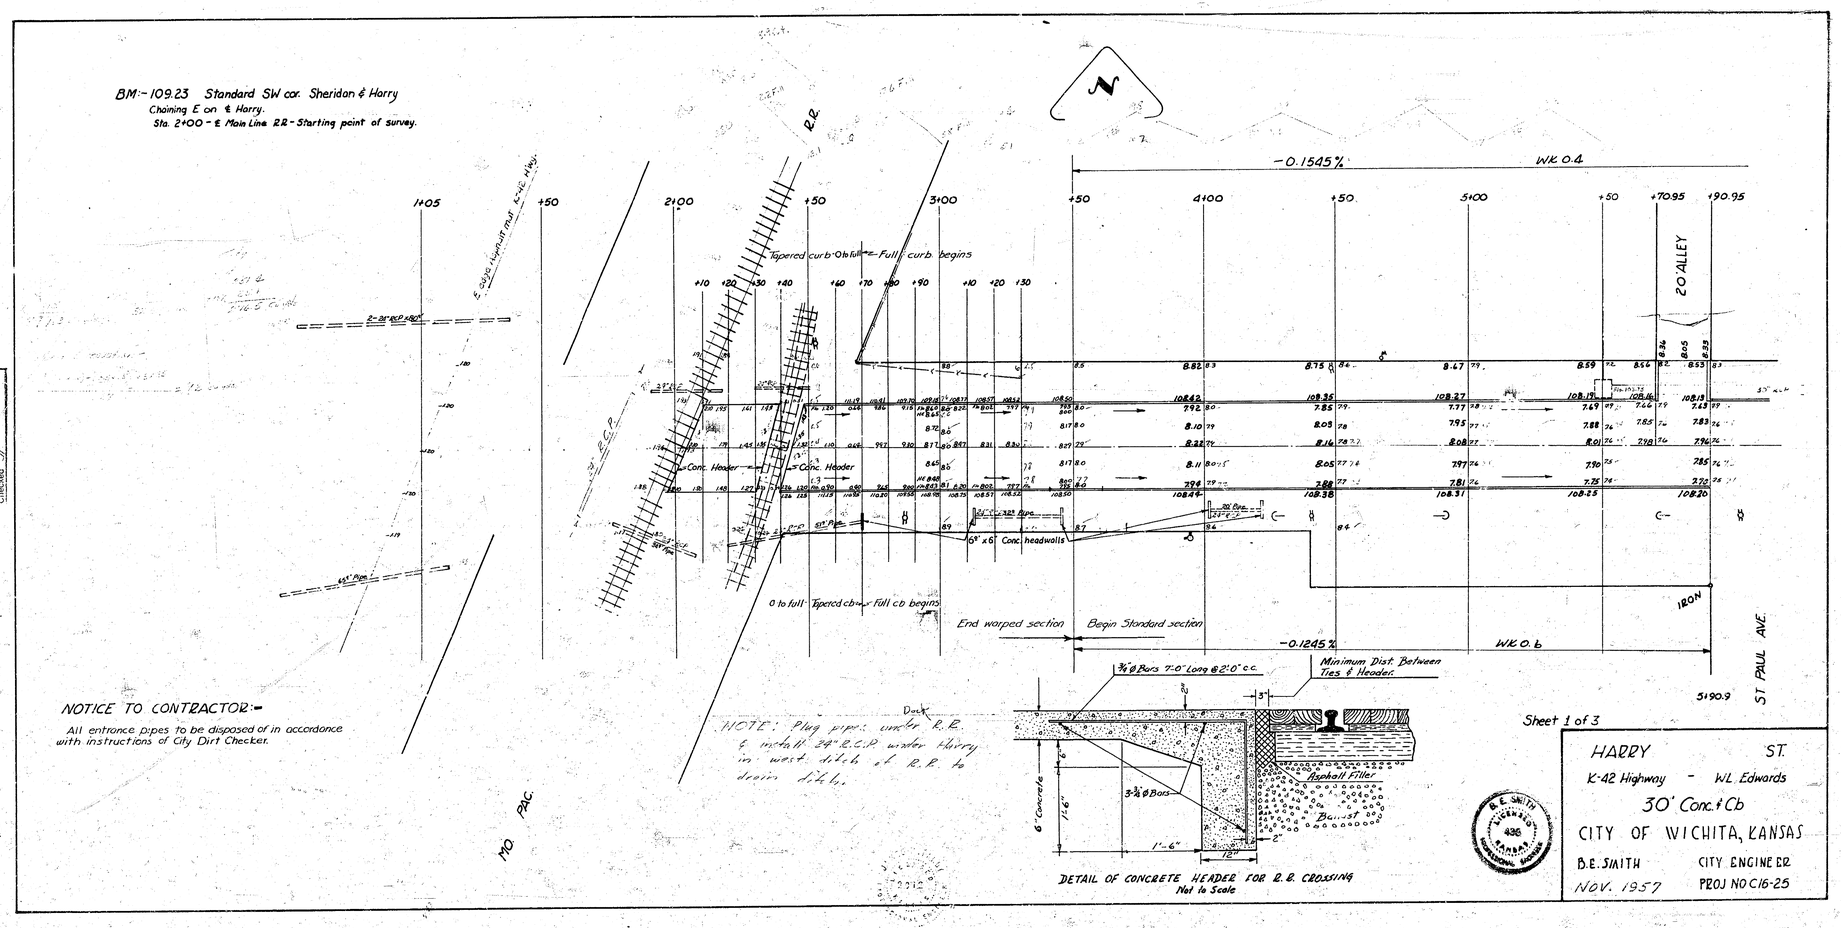


Sheet 1 of 3

HARRY ST.
K-42 Highway - W.L. Edwards
30' Conc. ℄ Cb
CITY OF WICHITA, KANSAS
B.E. SMITH CITY ENGINEER
NOV. 1957 PROJ NO C16-25

B.E. SMITH LICENSED KANSAS PROFESSIONAL ENGINEER 436

(12)


BM: 107.96 □ on SW cor conc. Catch Basin NE cor Edwards & Wheeler (Horry)

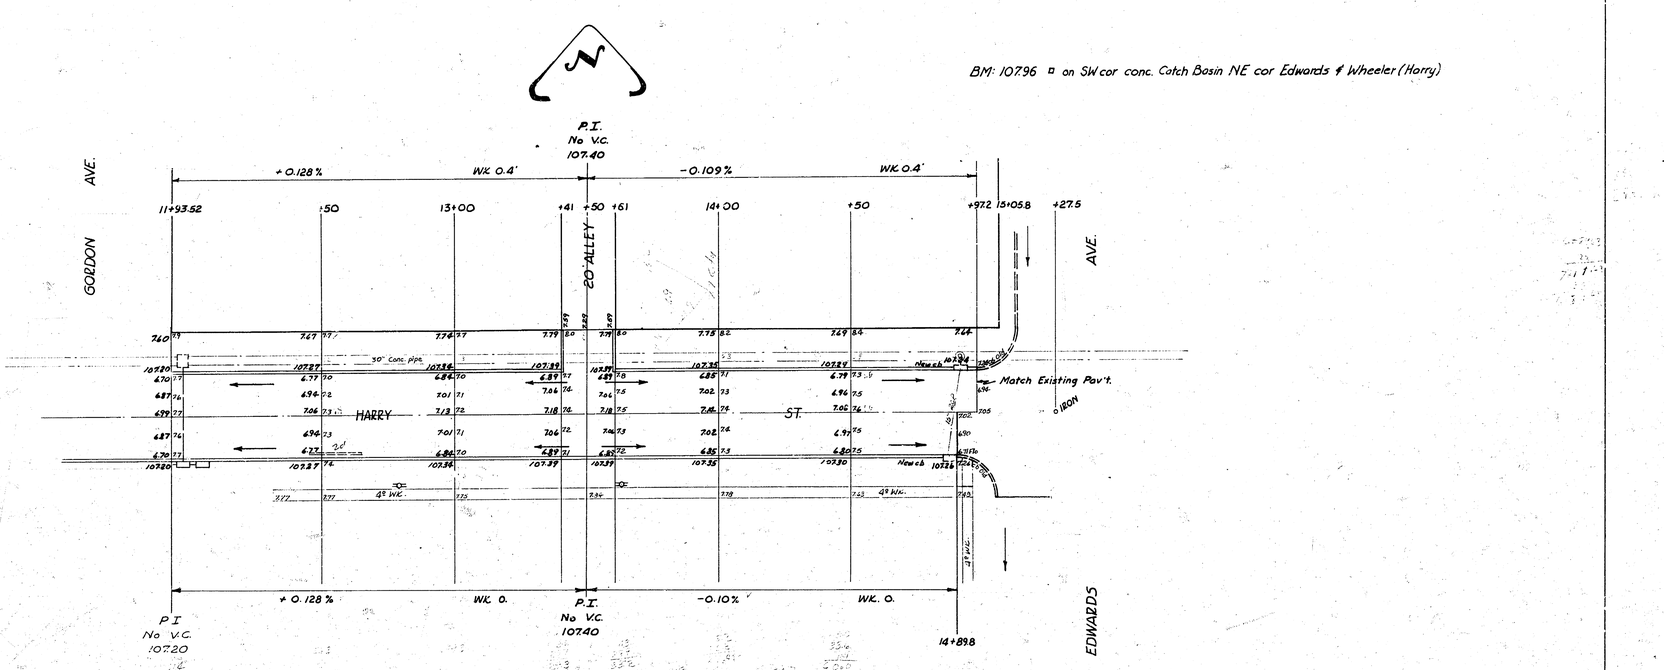

HARRY ST. C 16-25
Sheet 3 of 3

NOTICE TO FIELD ENGINEER:-
Take necessary ties to ℄ irons to replace after street is paved.

NOTICE TO FIELD ENGINEER & CONTRACTOR:-
Extreme caution must be exercised at all intersections on the North side of the street. Existing 30" RCP Storm Sewer is very shallow Check carefully on clearance before crossing.

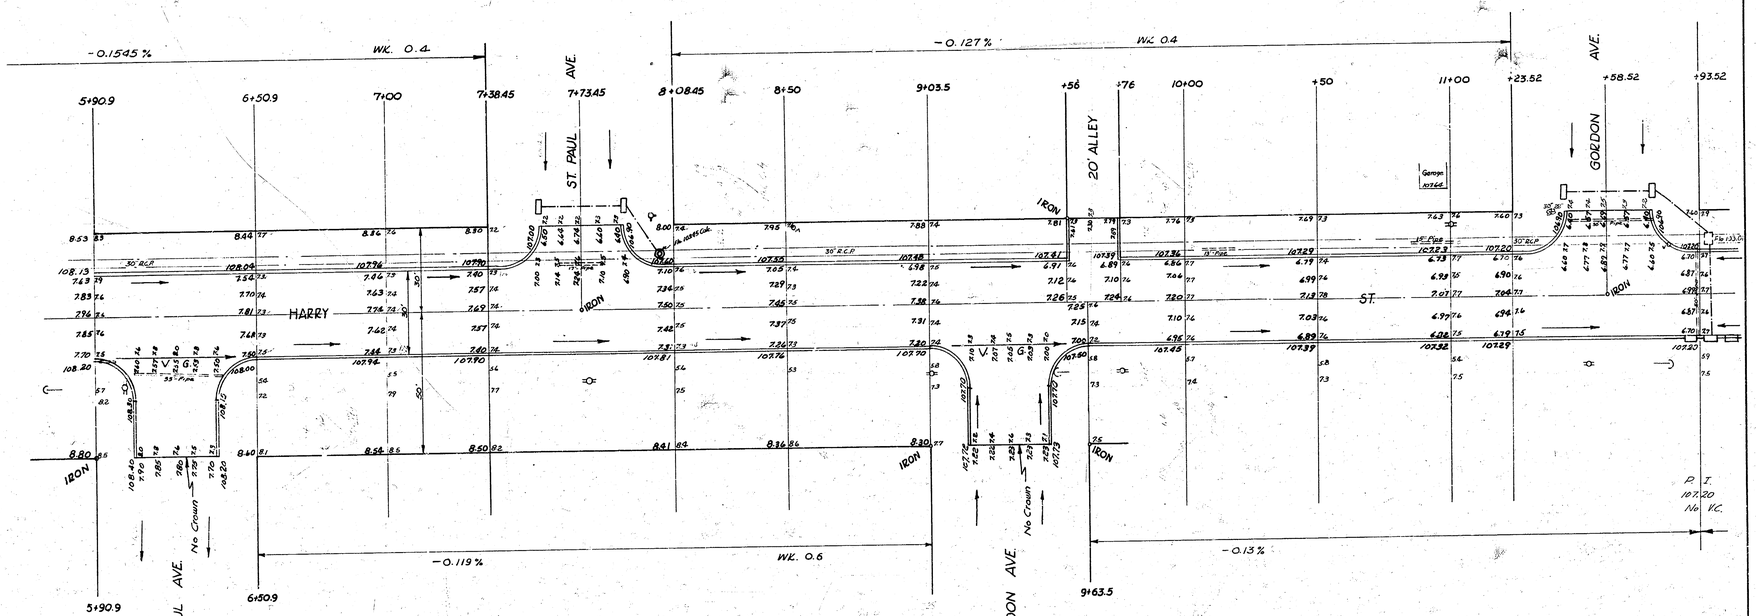

HARRY ST. C16-25
Sheet 2 of 3