



FINAL PLAN

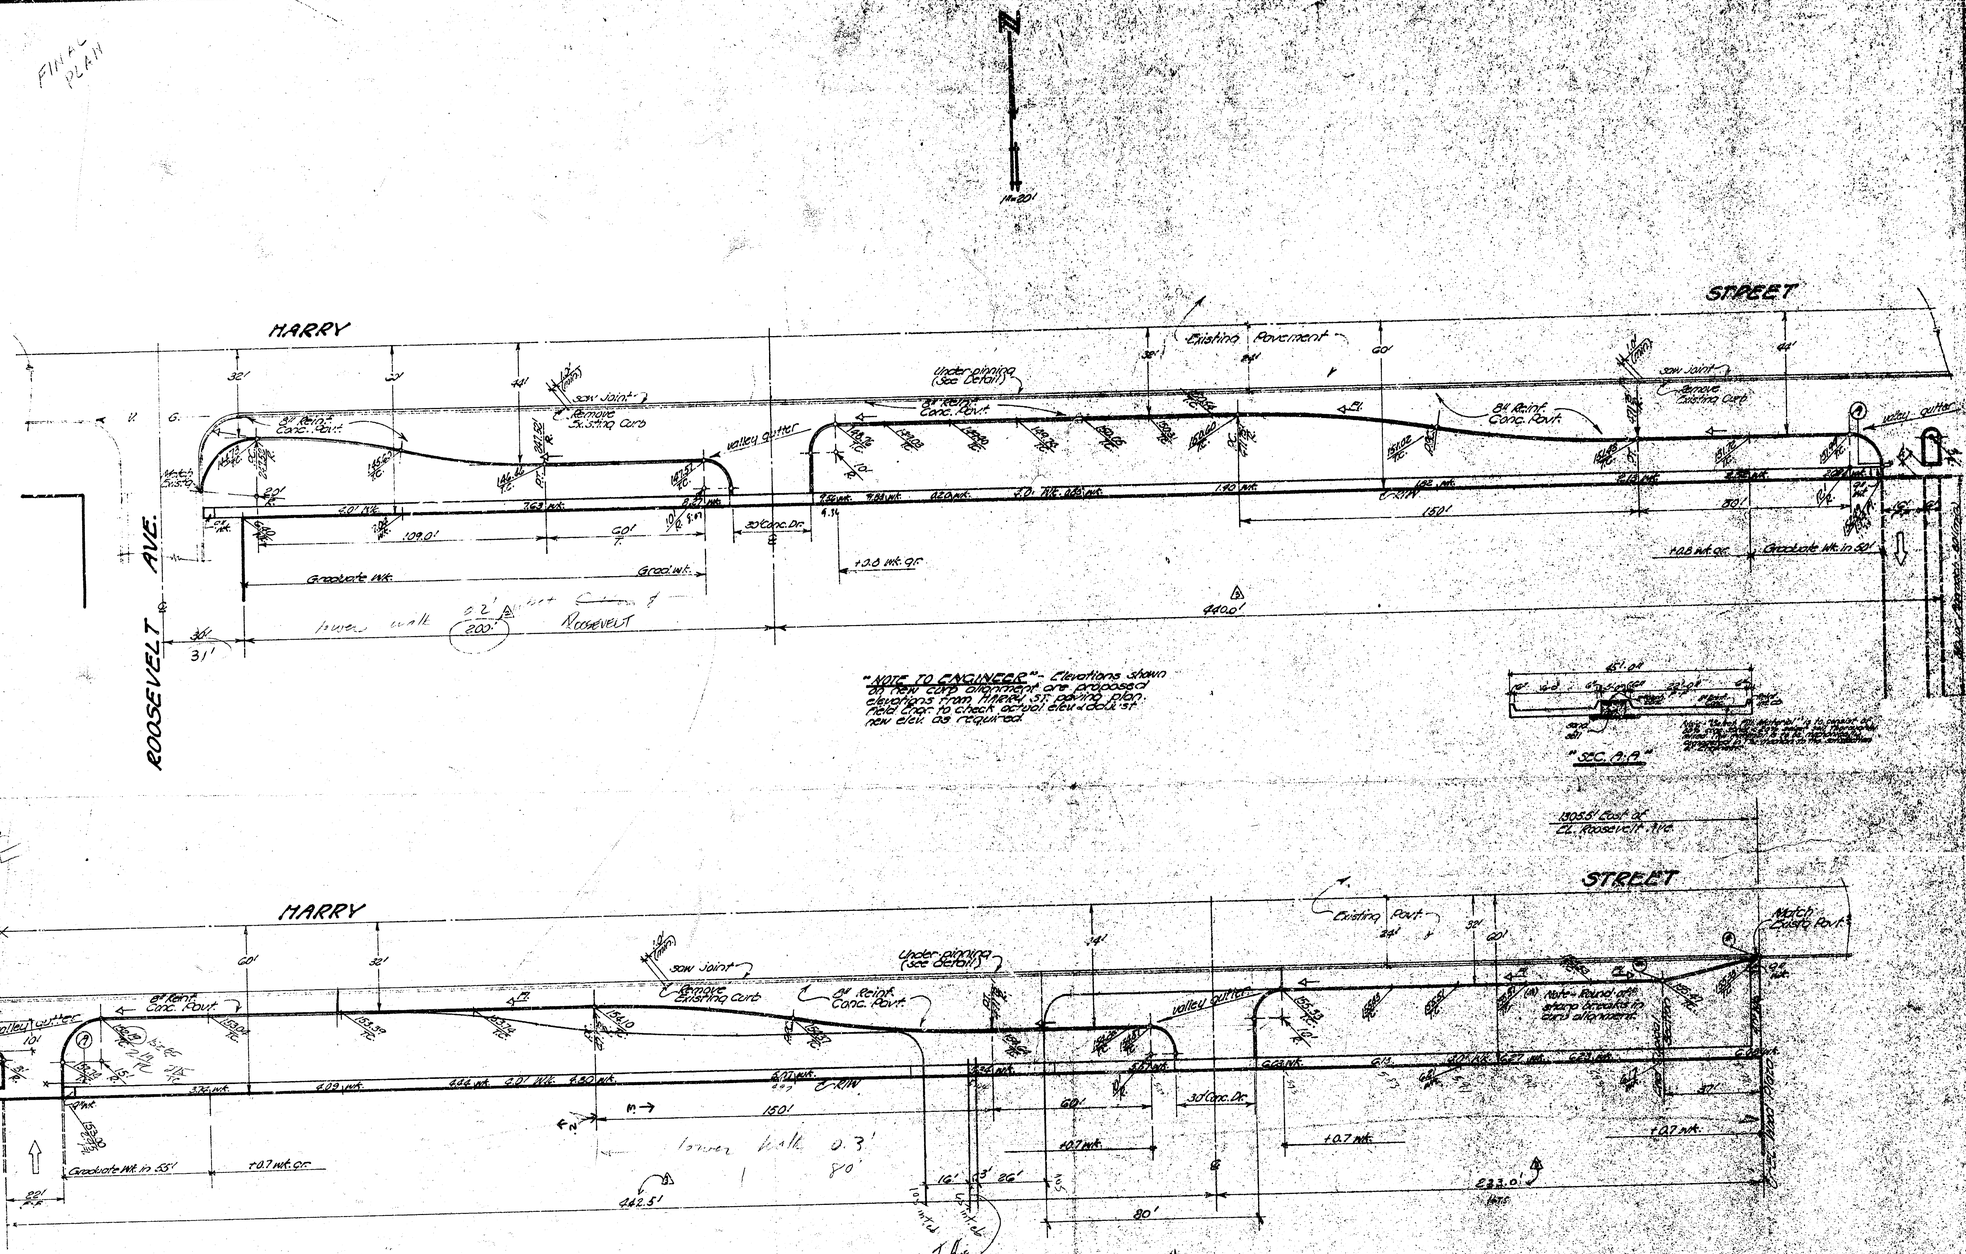


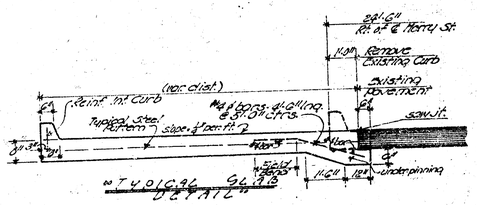

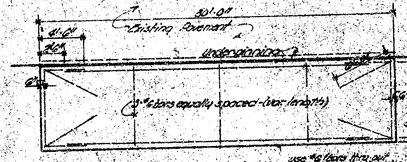

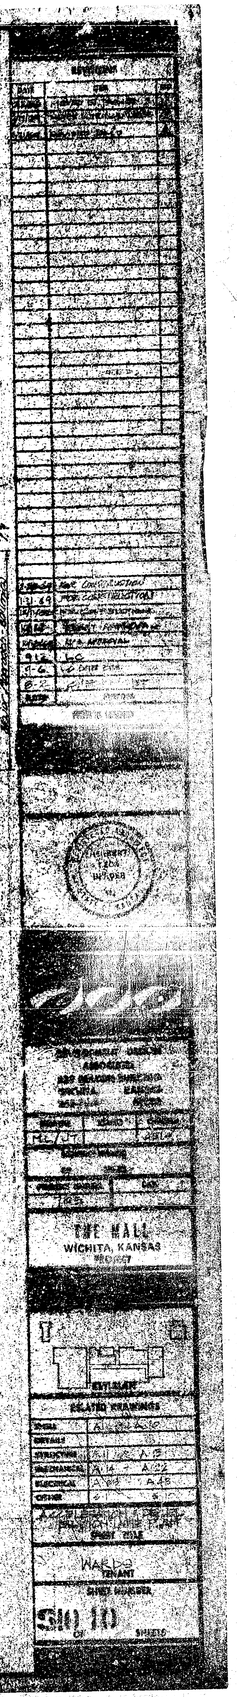

HARRY ST.
WOOD PLAZA

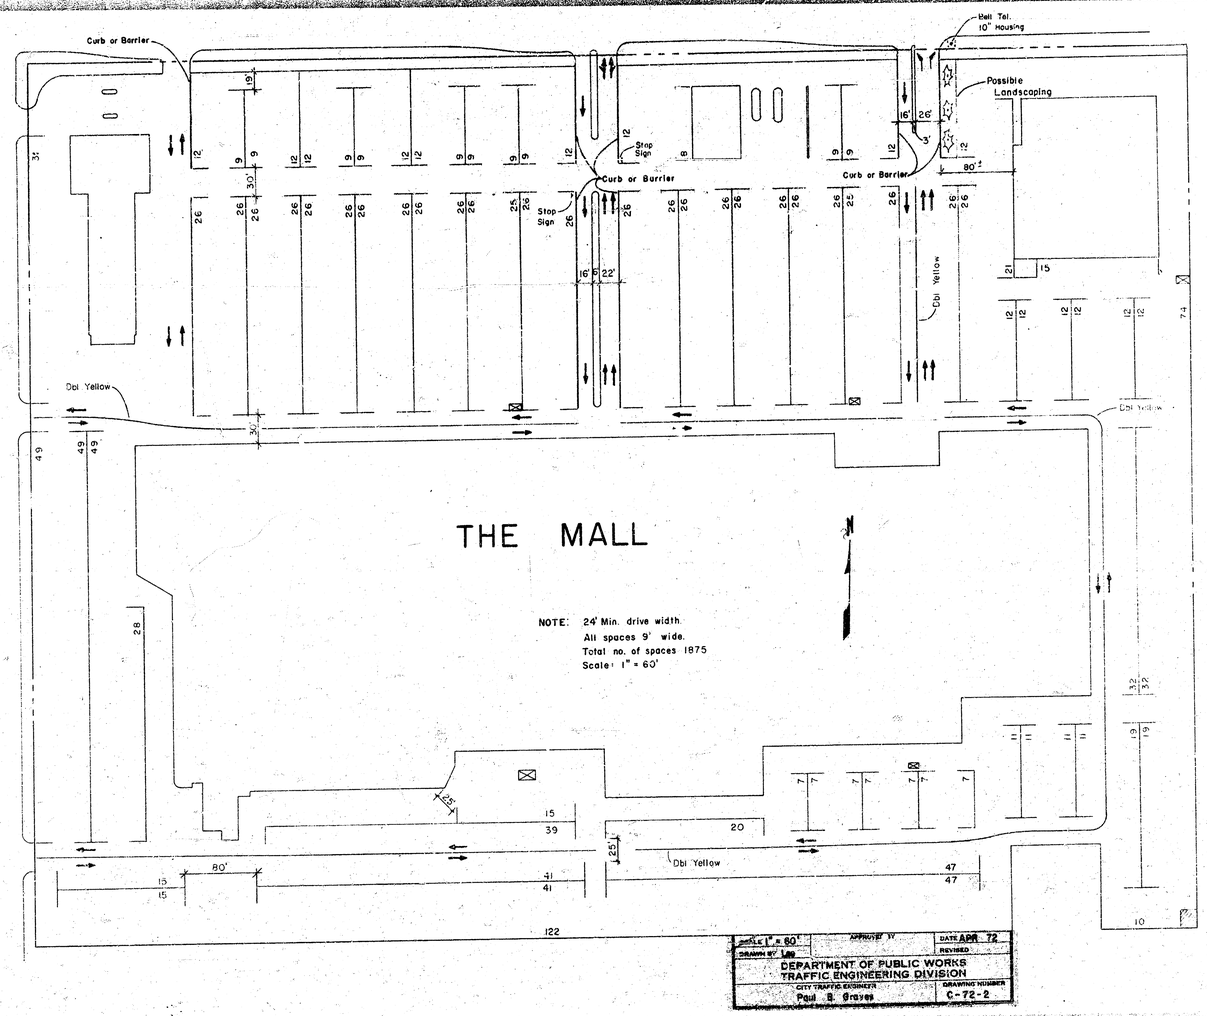
Curb or Barrier
Bell Tel. 10" Housing
Possible Landscaping
Stop Sign
Curb or Barrier
Curb or Barrier
Stop Sign
Dbl Yellow
Dbl Yellow
Dbl Yellow
THE MALL
NOTE: 24' Min. drive width.
All spaces 9' wide.
Total no. of spaces 1875
Scale: 1" = 60'
80'
122
SCALE 1" = 60'
DRAWN BY Lee
APPROVED BY
DATE APR 72
REVISED
DEPARTMENT OF PUBLIC WORKS
TRAFFIC ENGINEERING DIVISION
CITY TRAFFIC ENGINEER
Paul B. Graves
DRAWING NUMBER
C-72-2