




B.M. = 157.08 "□" Cut N.W. Cor. Conc. Base Meadow Lark Sign, S.S. Harry 100'± W. of W.L. Terrace Dr.
 Baseline is 50' North of & Parallel to E Harry St.

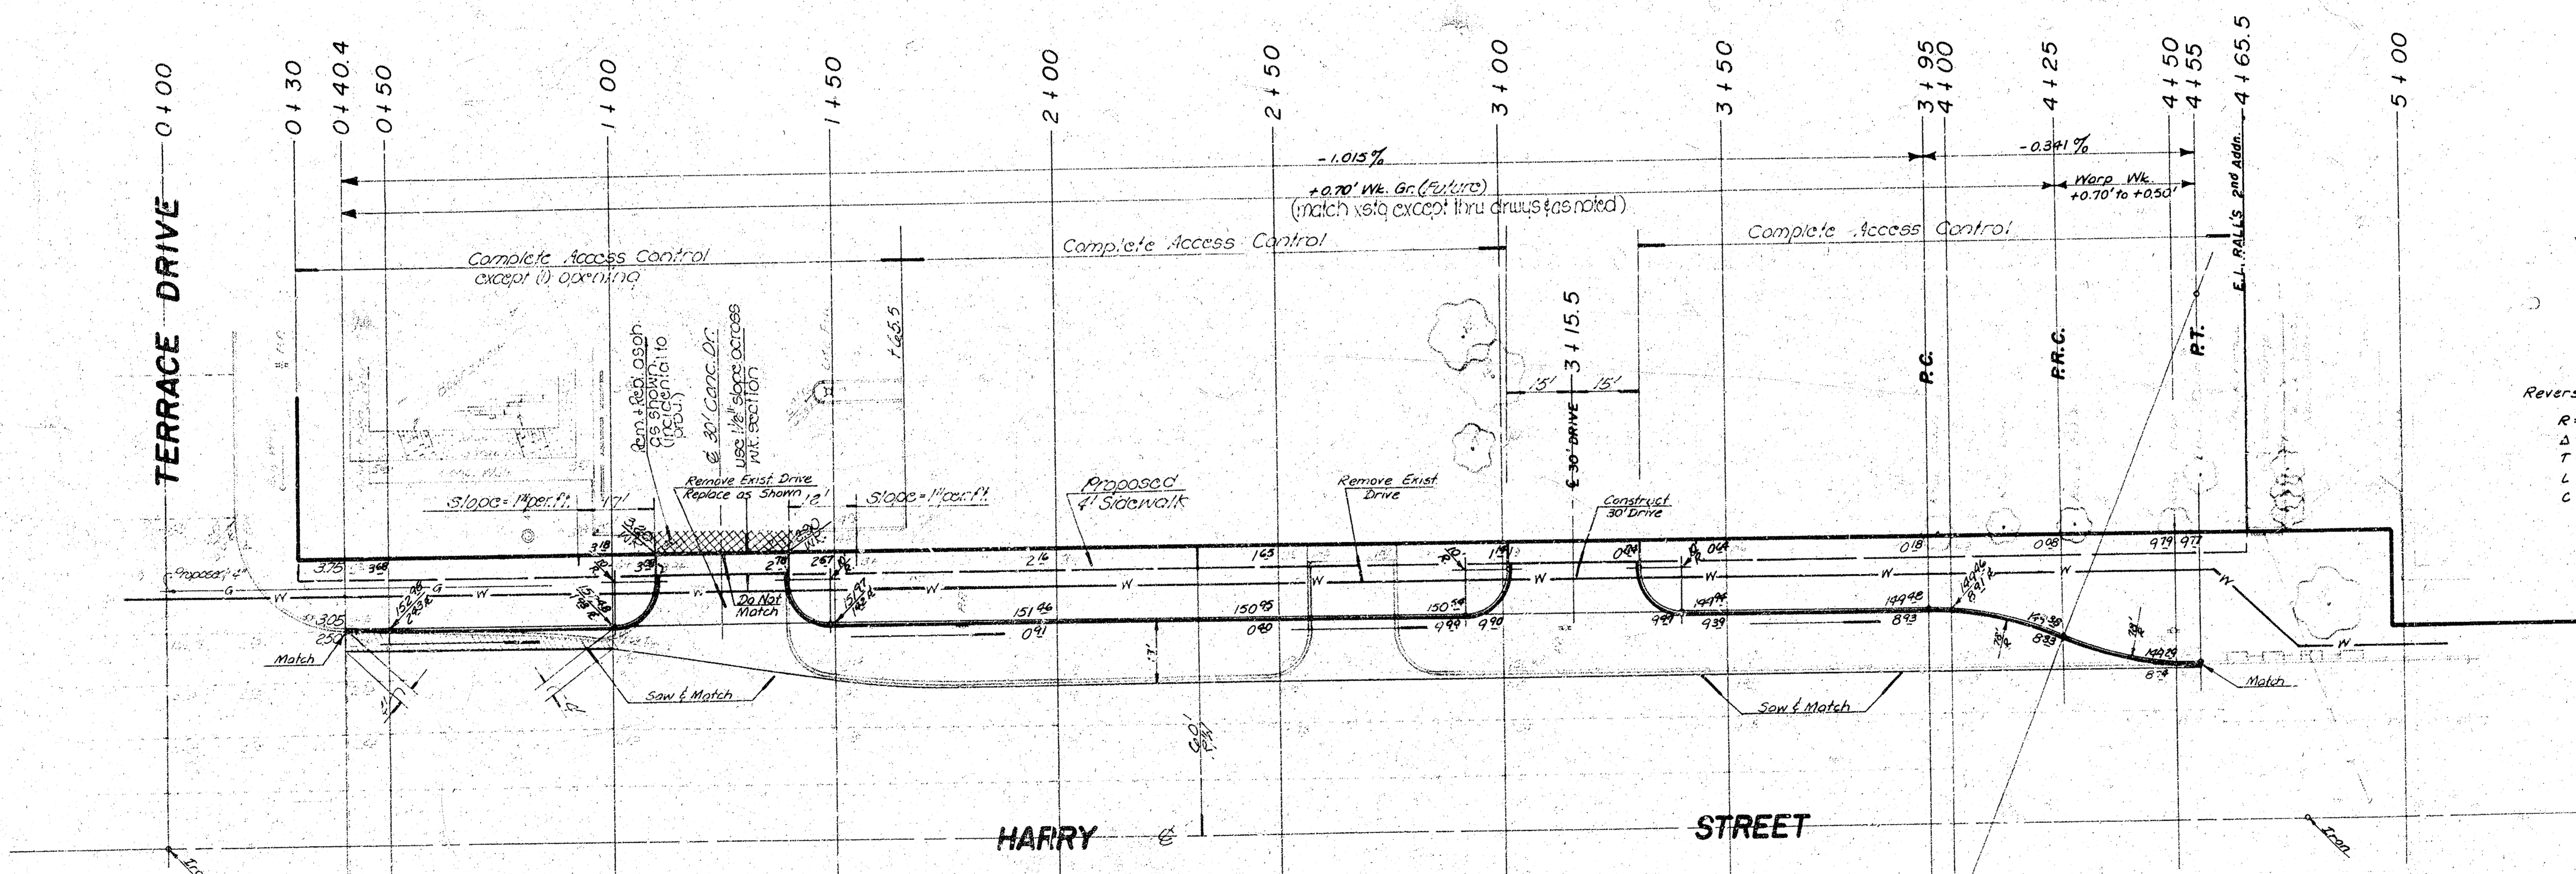

Reverse Curve Data:
 R = 78.00'
 $\Delta = 22^\circ 37' 12''$
 T = 15.40'
 L = 30.79'
 C = 30.59'

Survey D.L.C. 2001
 Plac. Henry
 Exc. Henry
 Checked

NOTE TO BID ENGINEER & CONTRACTOR
 Guide parking and clear right-of-way for proposed sidewalk. Curbcut fill in sidewalk areas to be constructed by contractor.

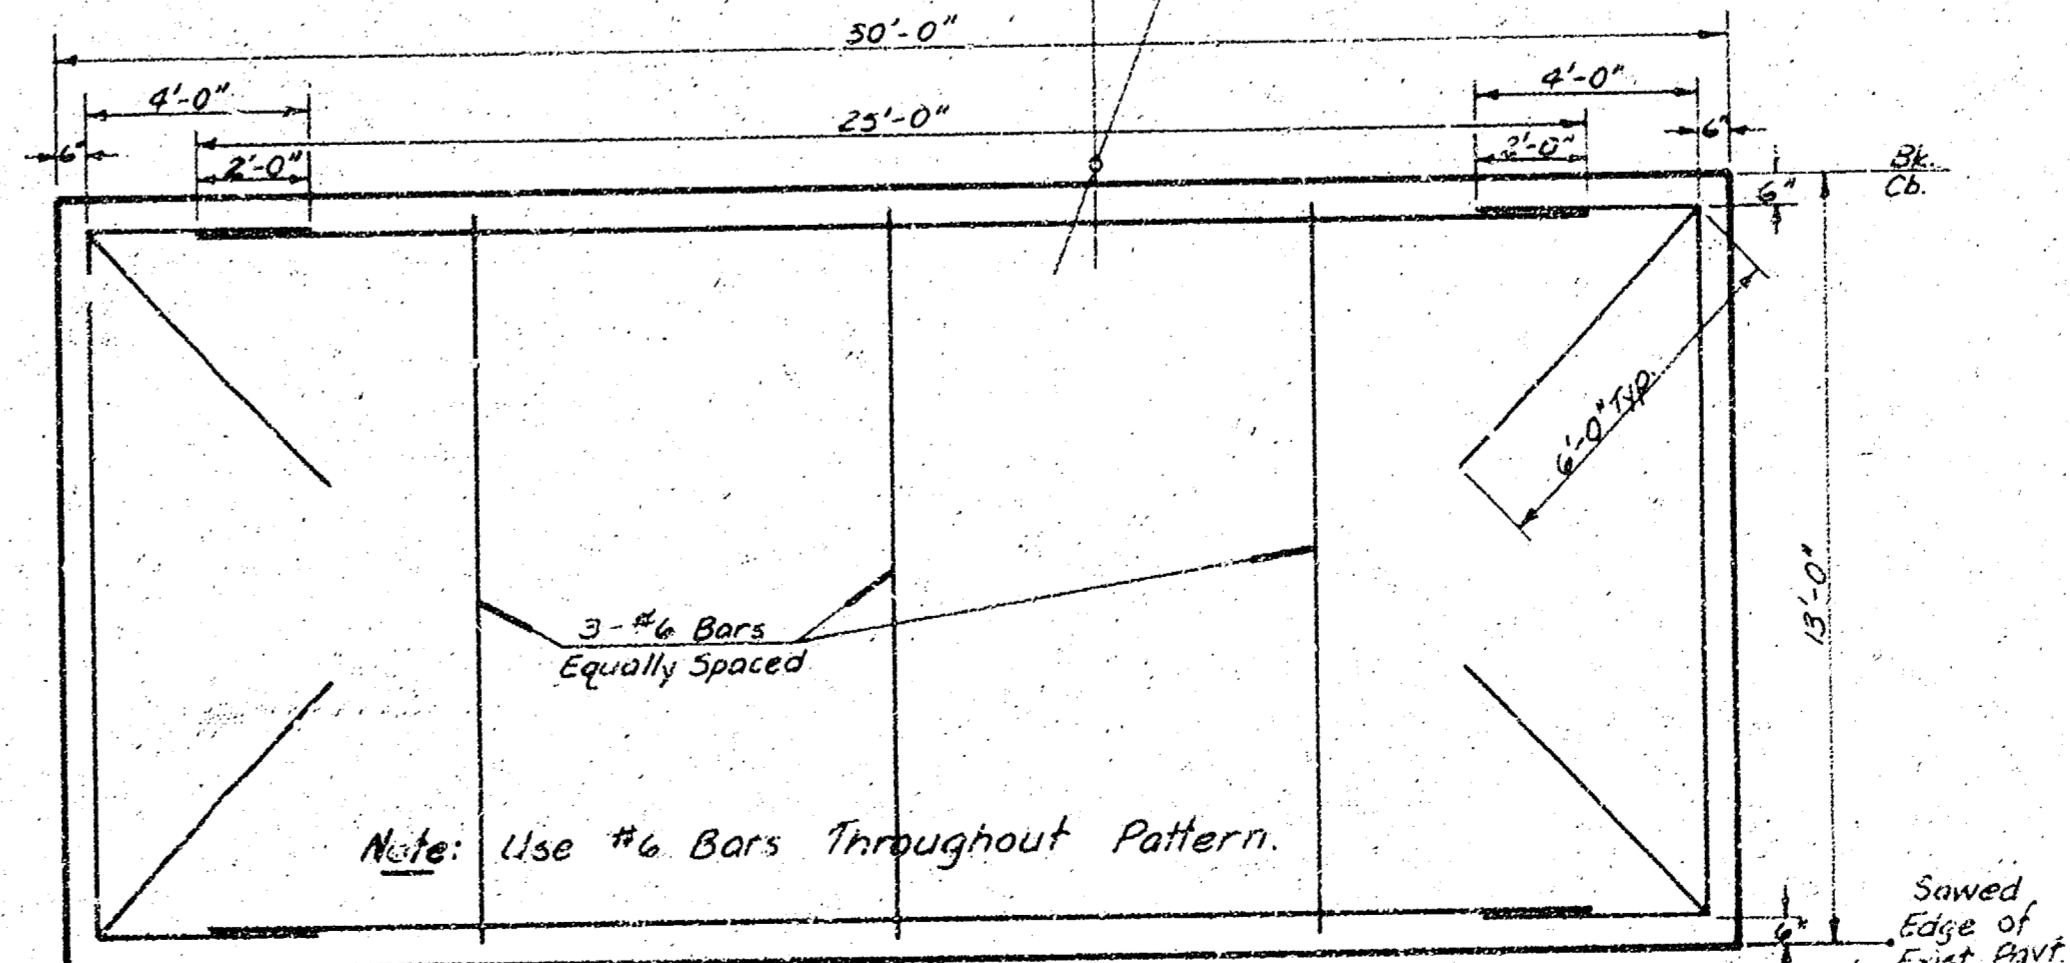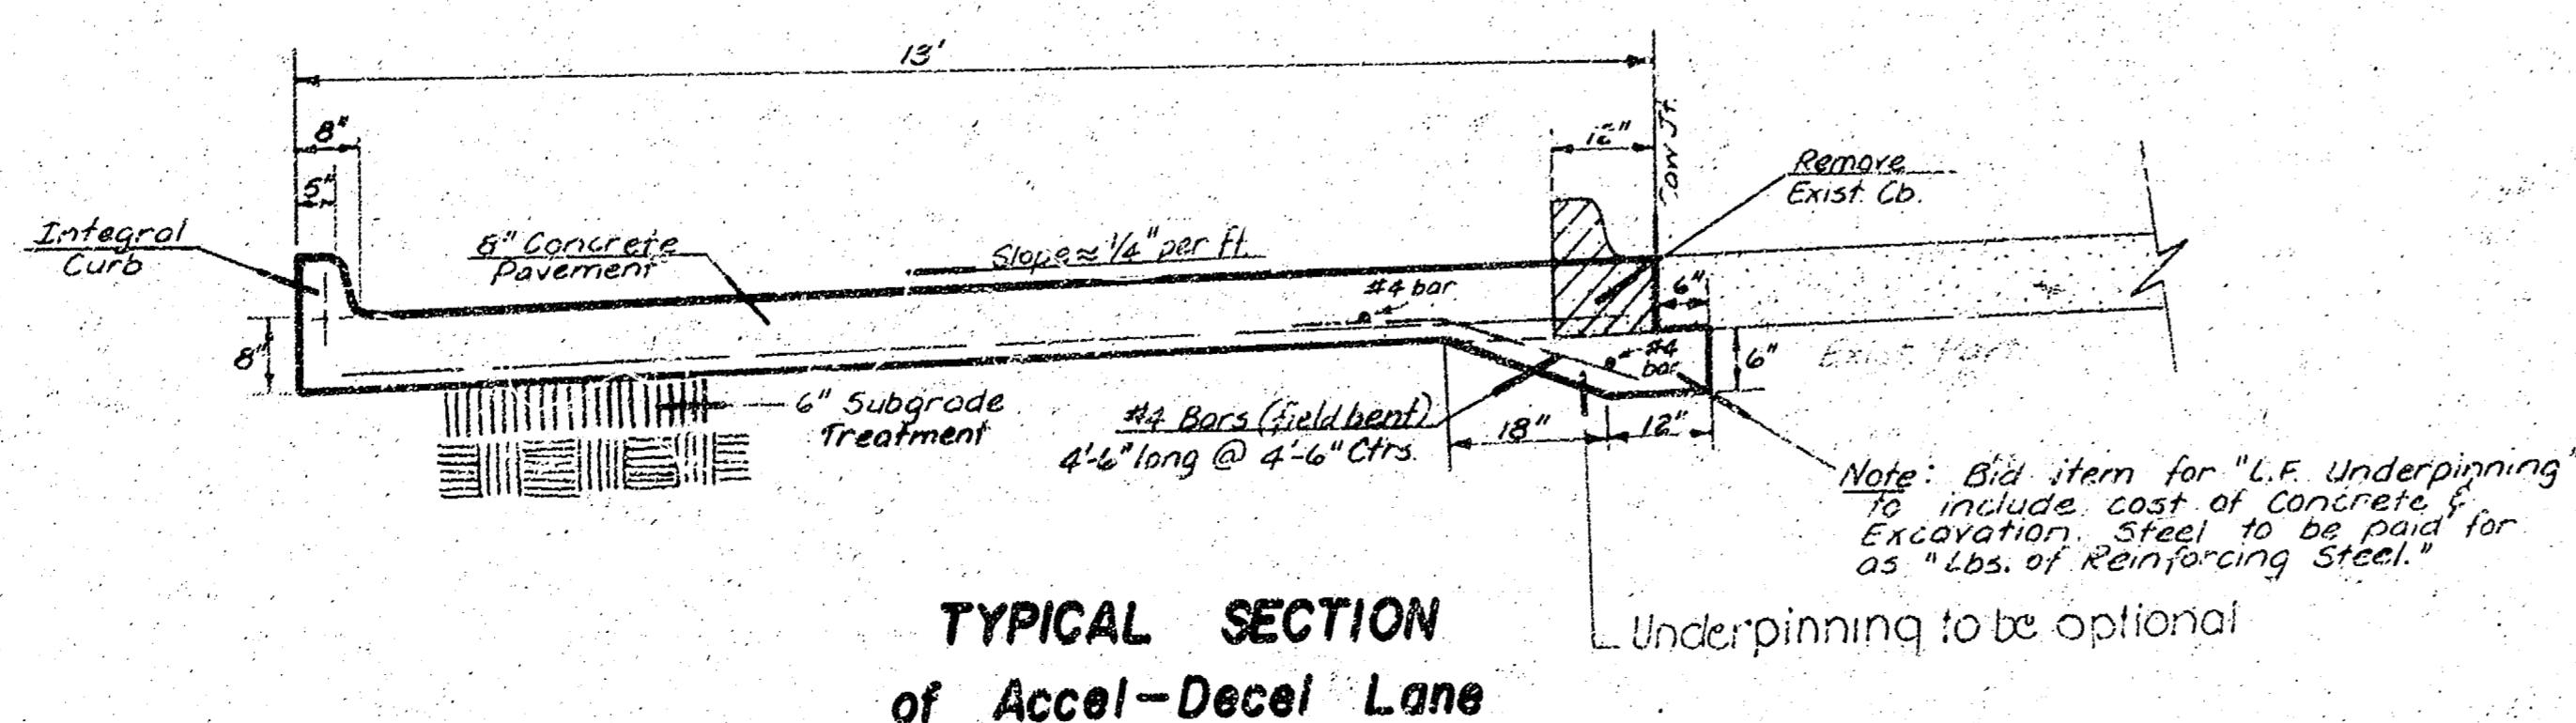

EARTHWORK	
Property	387.1 C.Y.
Excavation +10%	+ 38.7 C.Y.
	425.8 C.Y.
Manipulation	496.9 S.Y.

ACCEL-DECEL LANE
North Side HARRY STREET
 E.L. Terrace Dr. to 70E. of E.L. Ralls 2nd Addn.
 (8" Concrete Pavt. with Integral Curb)
CITY OF WICHITA, KANSAS
 R.W. Linn — City Engineer
 Proj. No. DAKS576065
 Date: _____

Plan revised 6-16-11 ags