

CITY OF WICHITA, KANSAS
R.W. LINN — City Engineer

HENDRYX STREET FROM E.L. TYLER ROAD TO E.L. LOT 15, BLOCK 3, FLOYD BAILEY FOURTH ADDN.
41' B-B ASPH. CONC. PAV'MT WITH CB. & GTR.


PROJECT NO. DAKS 573025

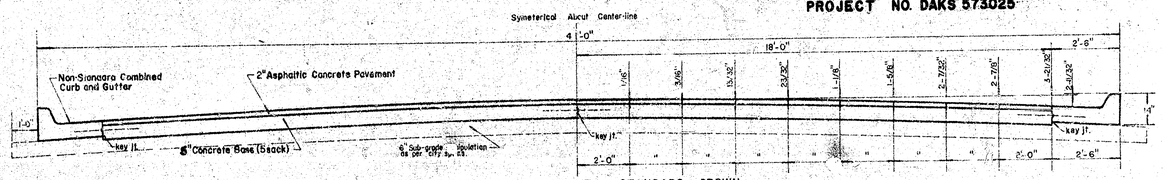

TYPICAL SECTION WITH STANDARD CROWN
40'-0" ASPHALTIC CONCRETE PAVEMENT

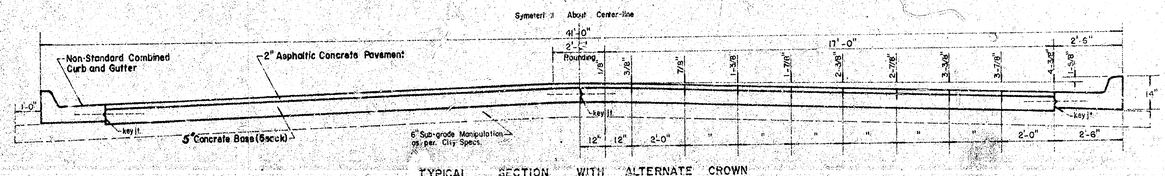

TYPICAL SECTION WITH ALTERNATE CROWN
40'-0" ASPHALTIC CONCRETE PAVEMENT

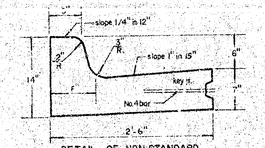


DETAIL OF NON-STANDARD COMBINED CURB AND GUTTER

GENERAL NOTES-

Contraction Joints may be constructed in combined curb and gutter by sawing with an approved concrete saw. The cut shall extend 2-1/2" below the surface of the gutter and curb. Sawed Contraction Joints shall have a maximum spacing of 10 ft. and be filled with a specified joint filler, such that the joint in the gutter section will be completely filled.

Pavement Grades shown on plans are for standard crown.

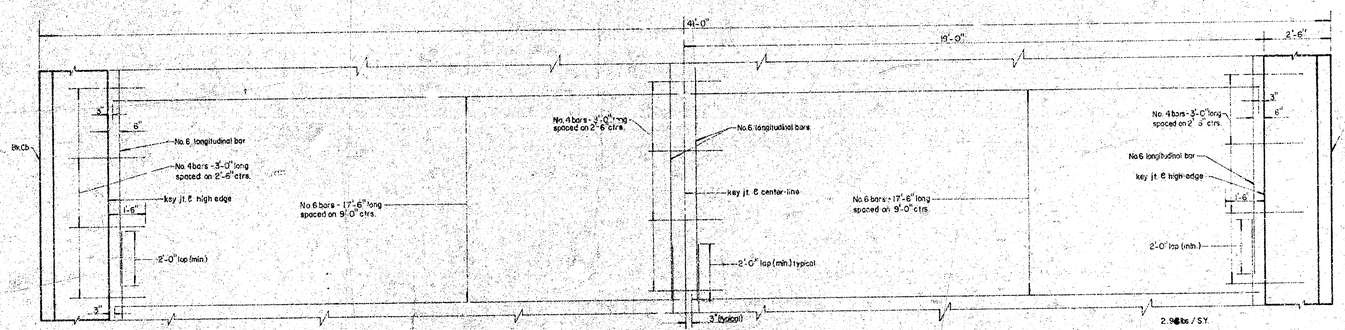


TYPICAL STEEL PATTERN
40'-0" ASPHALTIC CONCRETE PAVEMENT

R. W. LINN — CITY ENGINEER — 3694 — REGISTERED PROFESSIONAL ENGINEER — KANSAS

DONALD E. SCHNEIDER — LICENSED — 6311 — KANSAS — PROFESSIONAL ENGINEER

Survey Gipson Blk. CL602
Plan Laursen & Spruce
by
Checked

B.M. 141.55 City Standard S.W. Corner U.S. 54 & Tyler.
B.M. 1934.1 City Standard S.E. Corner Maple & Tyler.
B.M. 1932.0 R.R. Spike E.S. P.P. S.W. Corner University & Tyler.
B.M. 1948.54 "O" Cut N.W. Corner & Step At 520 Evergreen.

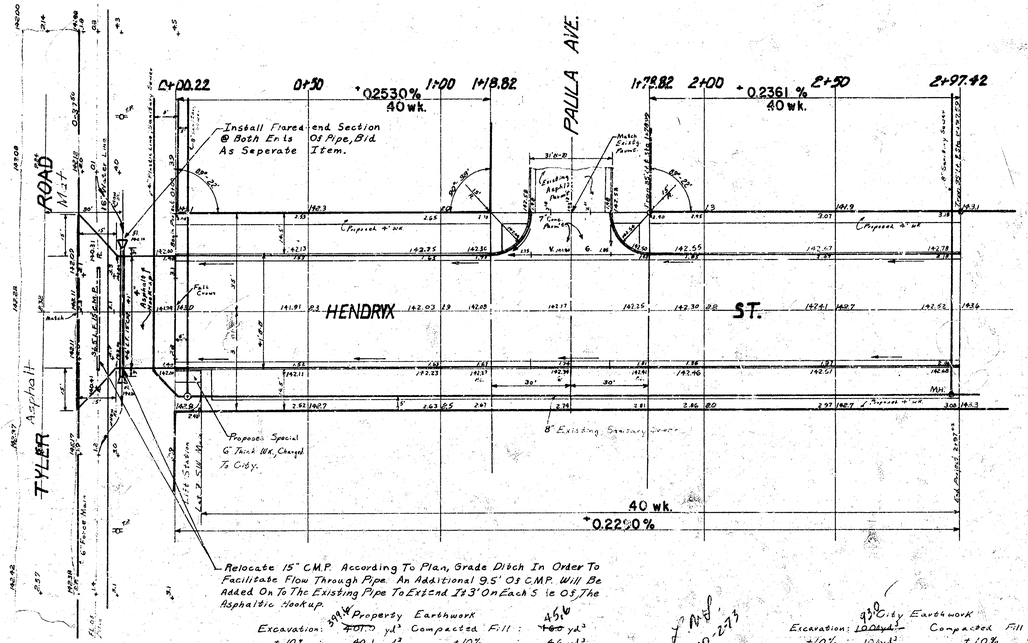

Scale: 1"=20'

Note: Type Of Sub-grade Treatment Shall Be Determined By The Field Engineer. Sub-grade Treatment May Consist Of Lime Treatment, Cement Treatment, Subgrade Modification, Or Any Combination Of These.

Note: The Contractor Is To Grade The Parking And Clear The R/W For Proposed Sidewalk, The Const. Of Which Is To Be Done BY Others.

Note: Payment For Ditch Regrading Will Be Included In The Bid Price For Removing And Resetting The 15" CMP.

Note: If The Contractor Damages The 15" CMP While Removing And Resetting The 15" CMP. The Contractor Will Replace The 15" CMP. At His Own Expense.

Property Earthwork

Excavation: ~~391.4~~ 401.5 yd³	Compacted Fill:	~~45.6~~ 46 yd³
+10% : 40.1 yd³	+10%	: 4.6 yd³
Total : 441.1 yd³		50.6 yd³

City Earthwork

Excavation: 100 yd³	Compacted Fill:	220 yd³
+10% : 10 yd³	+10%	: 2.2 yd³
Total +110.0 yd³		29.7 yd³

HENDRYX STREET FROM E. L. TYLER ROAD TO E.L. LOT 15, BLOCK 2, FLOYD BAILEY FOURTH ADDITION.
41' ASPH. CONC. PAVMT W/ CB. & STR.
CITY OF WICHITA, KANSAS
R. W. LINN CITY ENGINEER
PROJ. NO. DAKS 573025
DATE: MAY 1973