



HILLSIDE AVE
N.L. 17TH TO S.L. 21ST
PROJ. NO. CI3-264

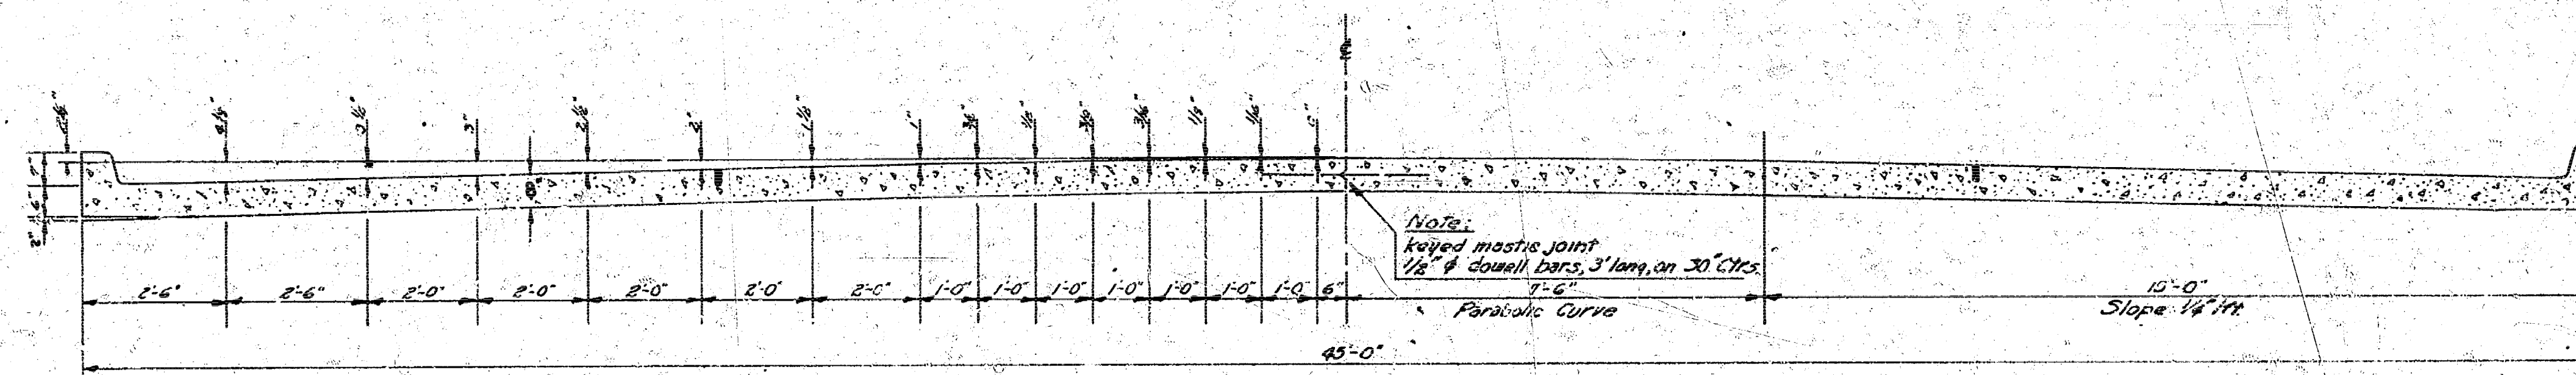


TYPICAL SECTION
NO SCALE

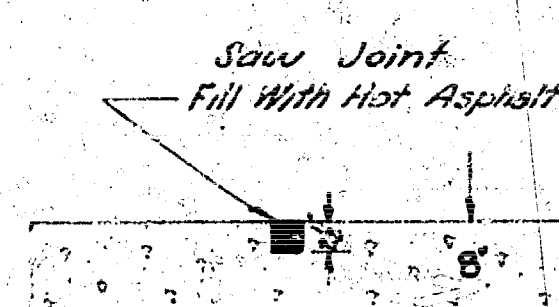


TRANSVERSE & LONGITUDINAL
JOINT DETAIL
NO SCALE

NOTE -

WHERE CURBS IN THE SAME SECTION
ARE AT DIFFERENT ELEVATIONS USE
ELEVATION SHOWN ON PLAN FOR
CONSTRUCTION JOINT.

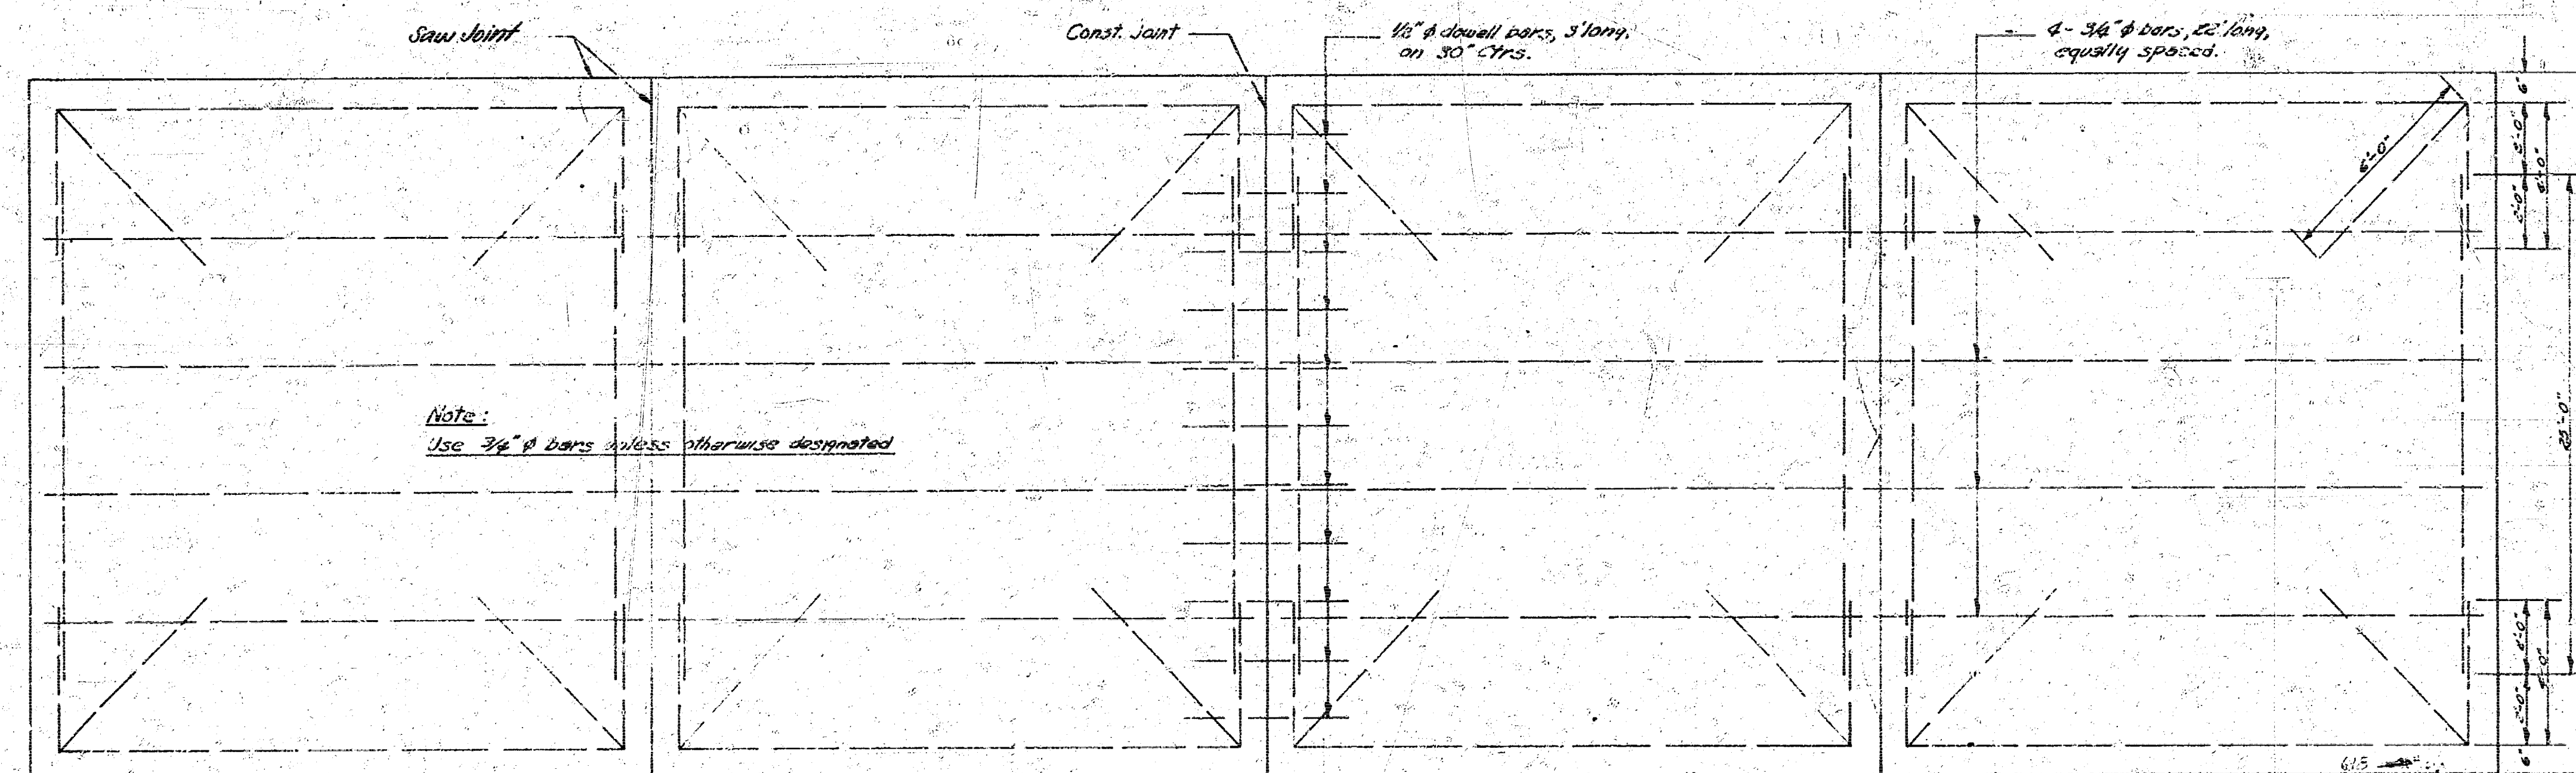



STEEL PATTERN
NO SCALE

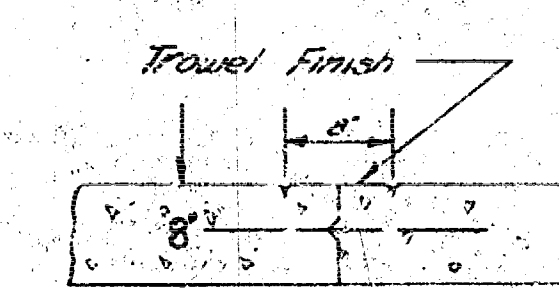



C.L. MARKER DETAIL
NO SCALE



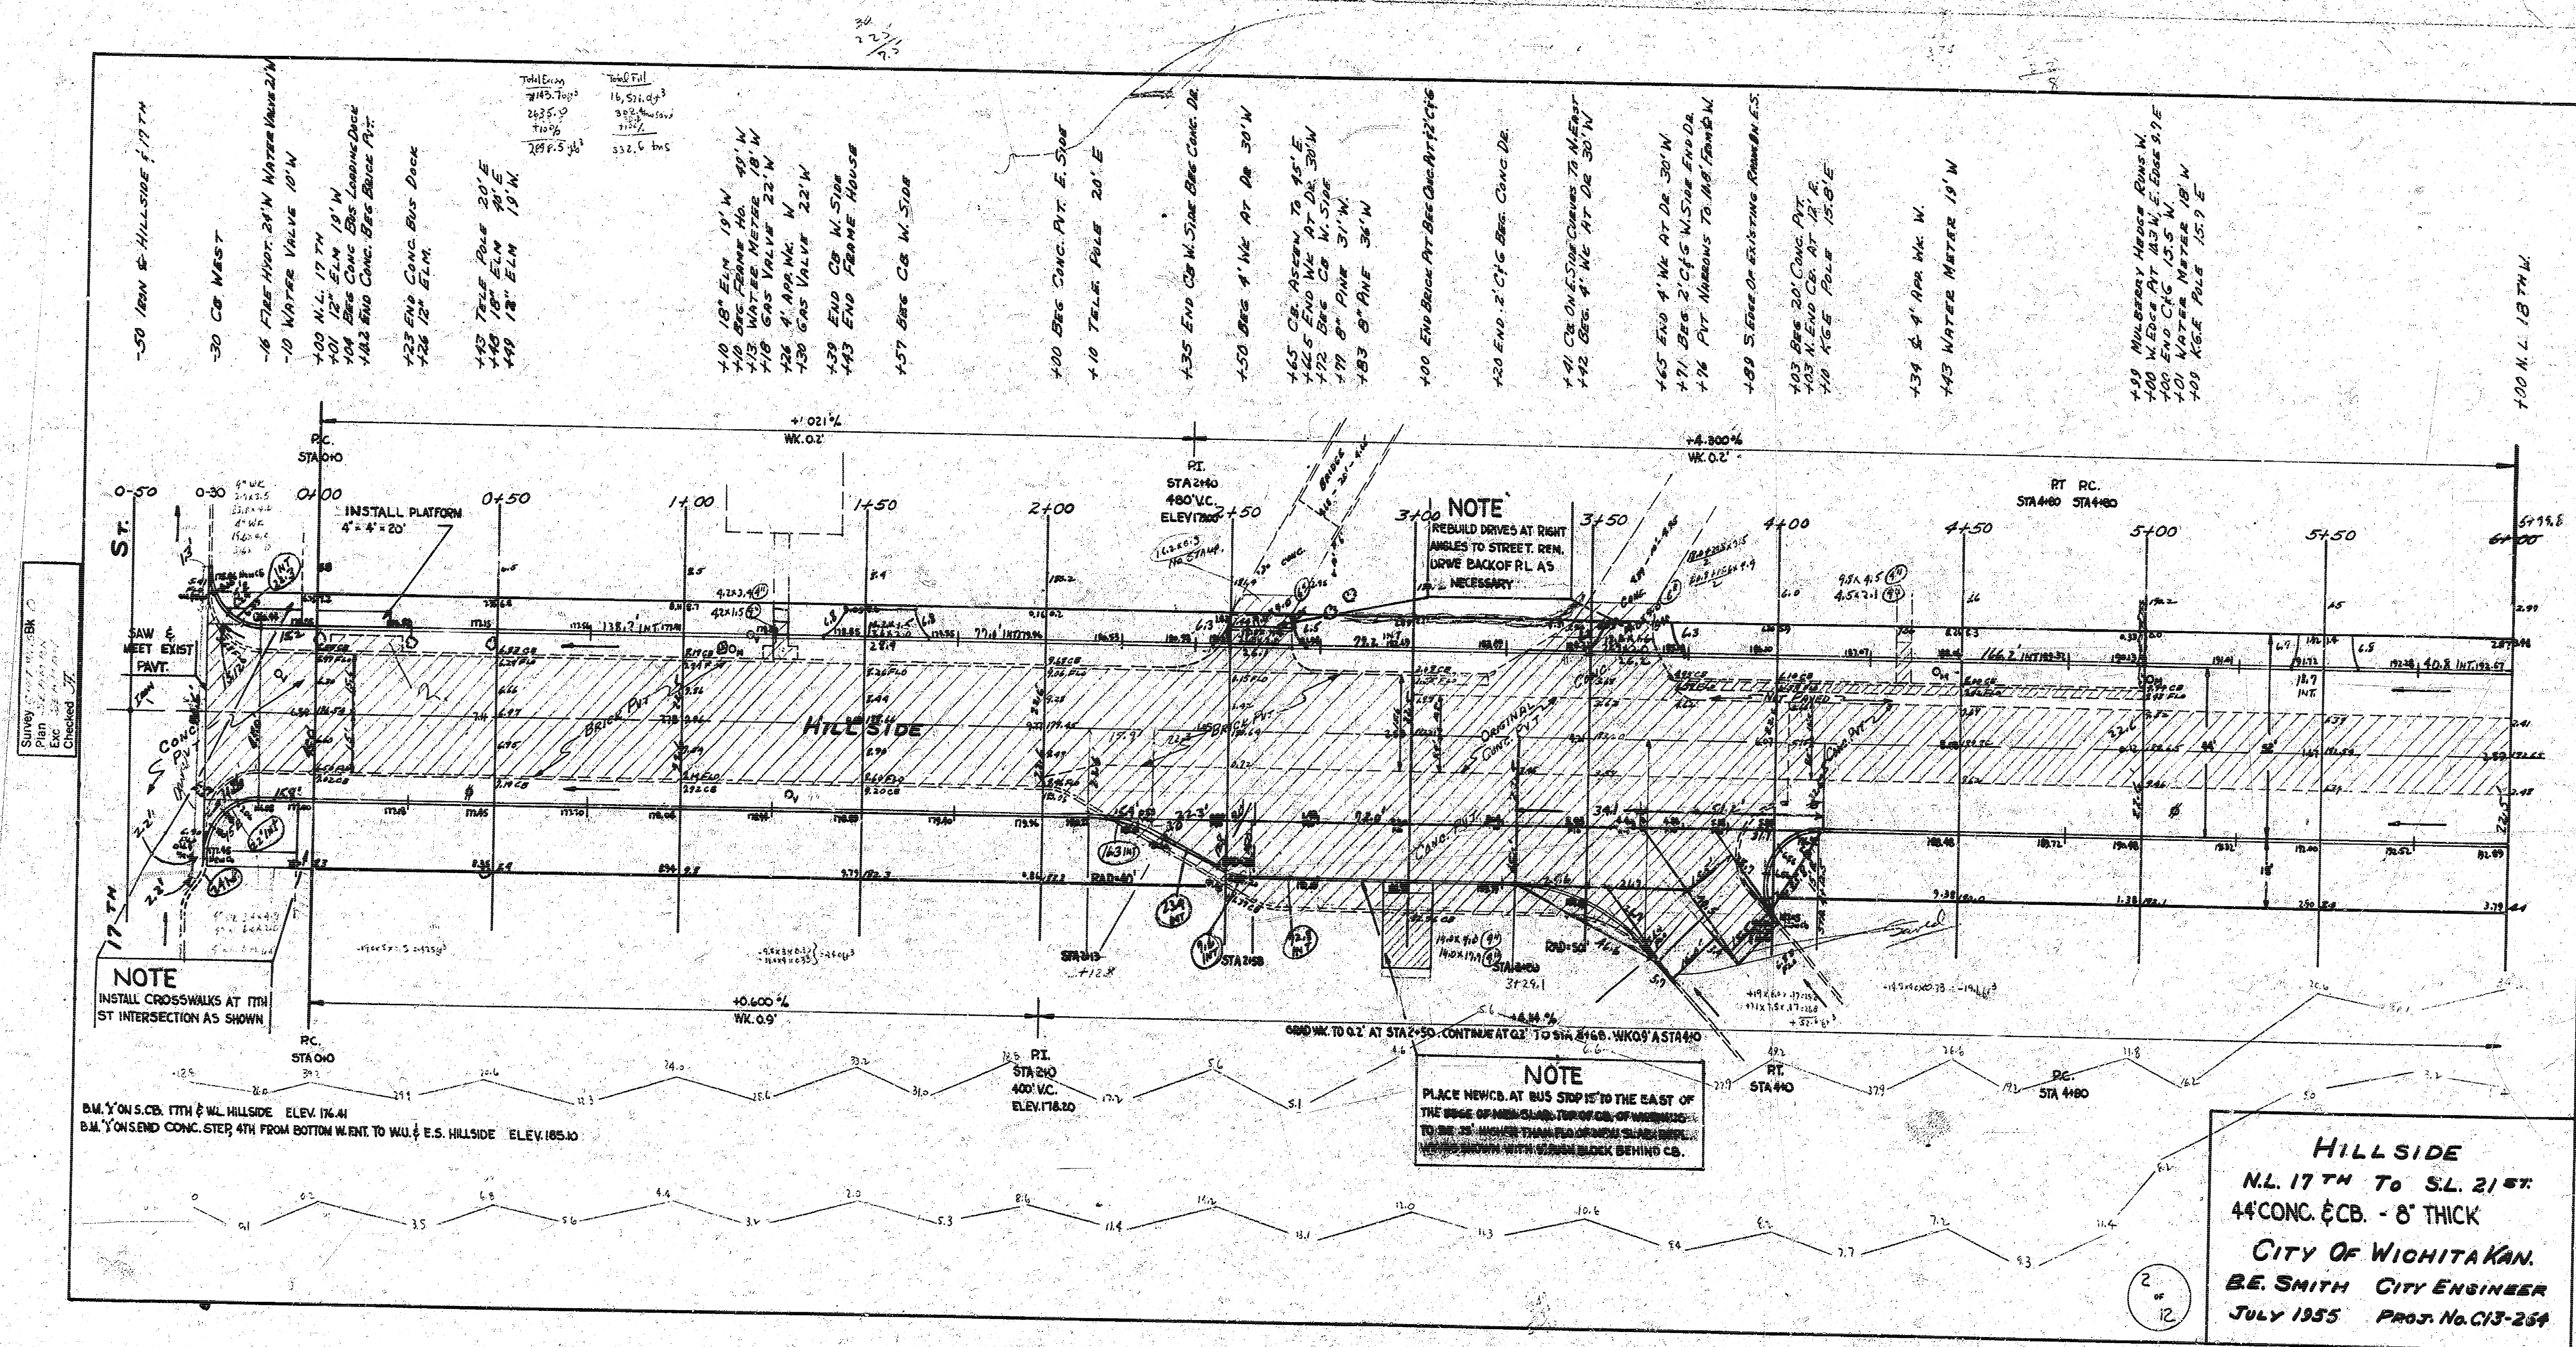



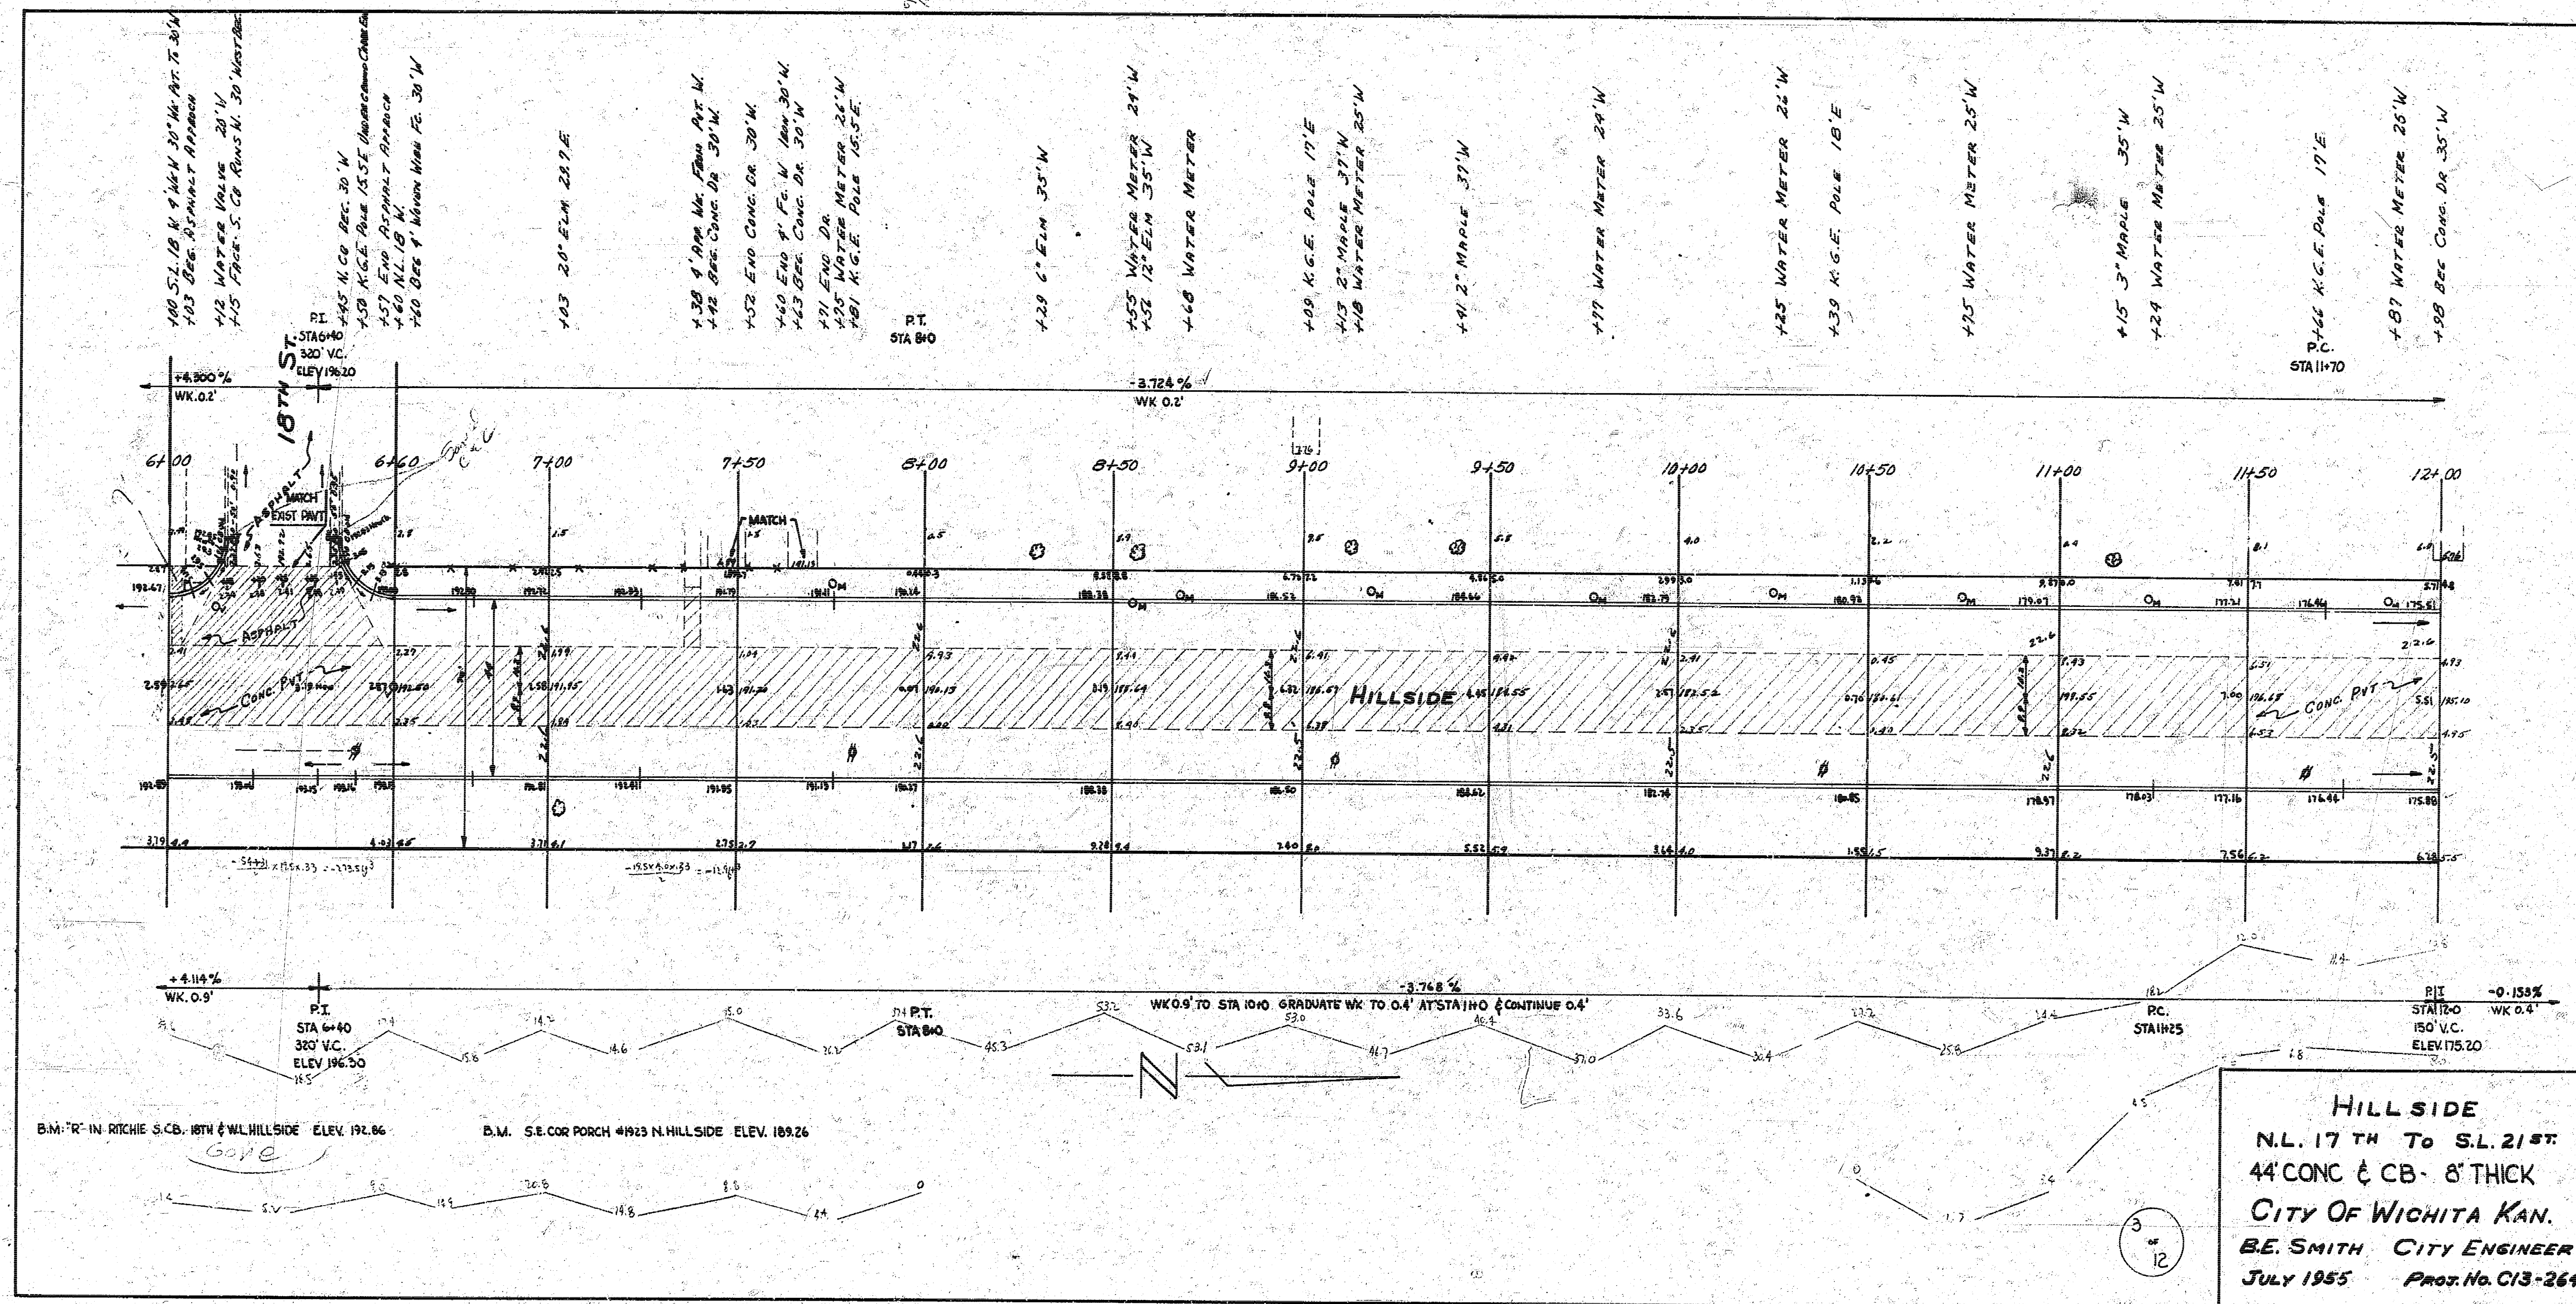



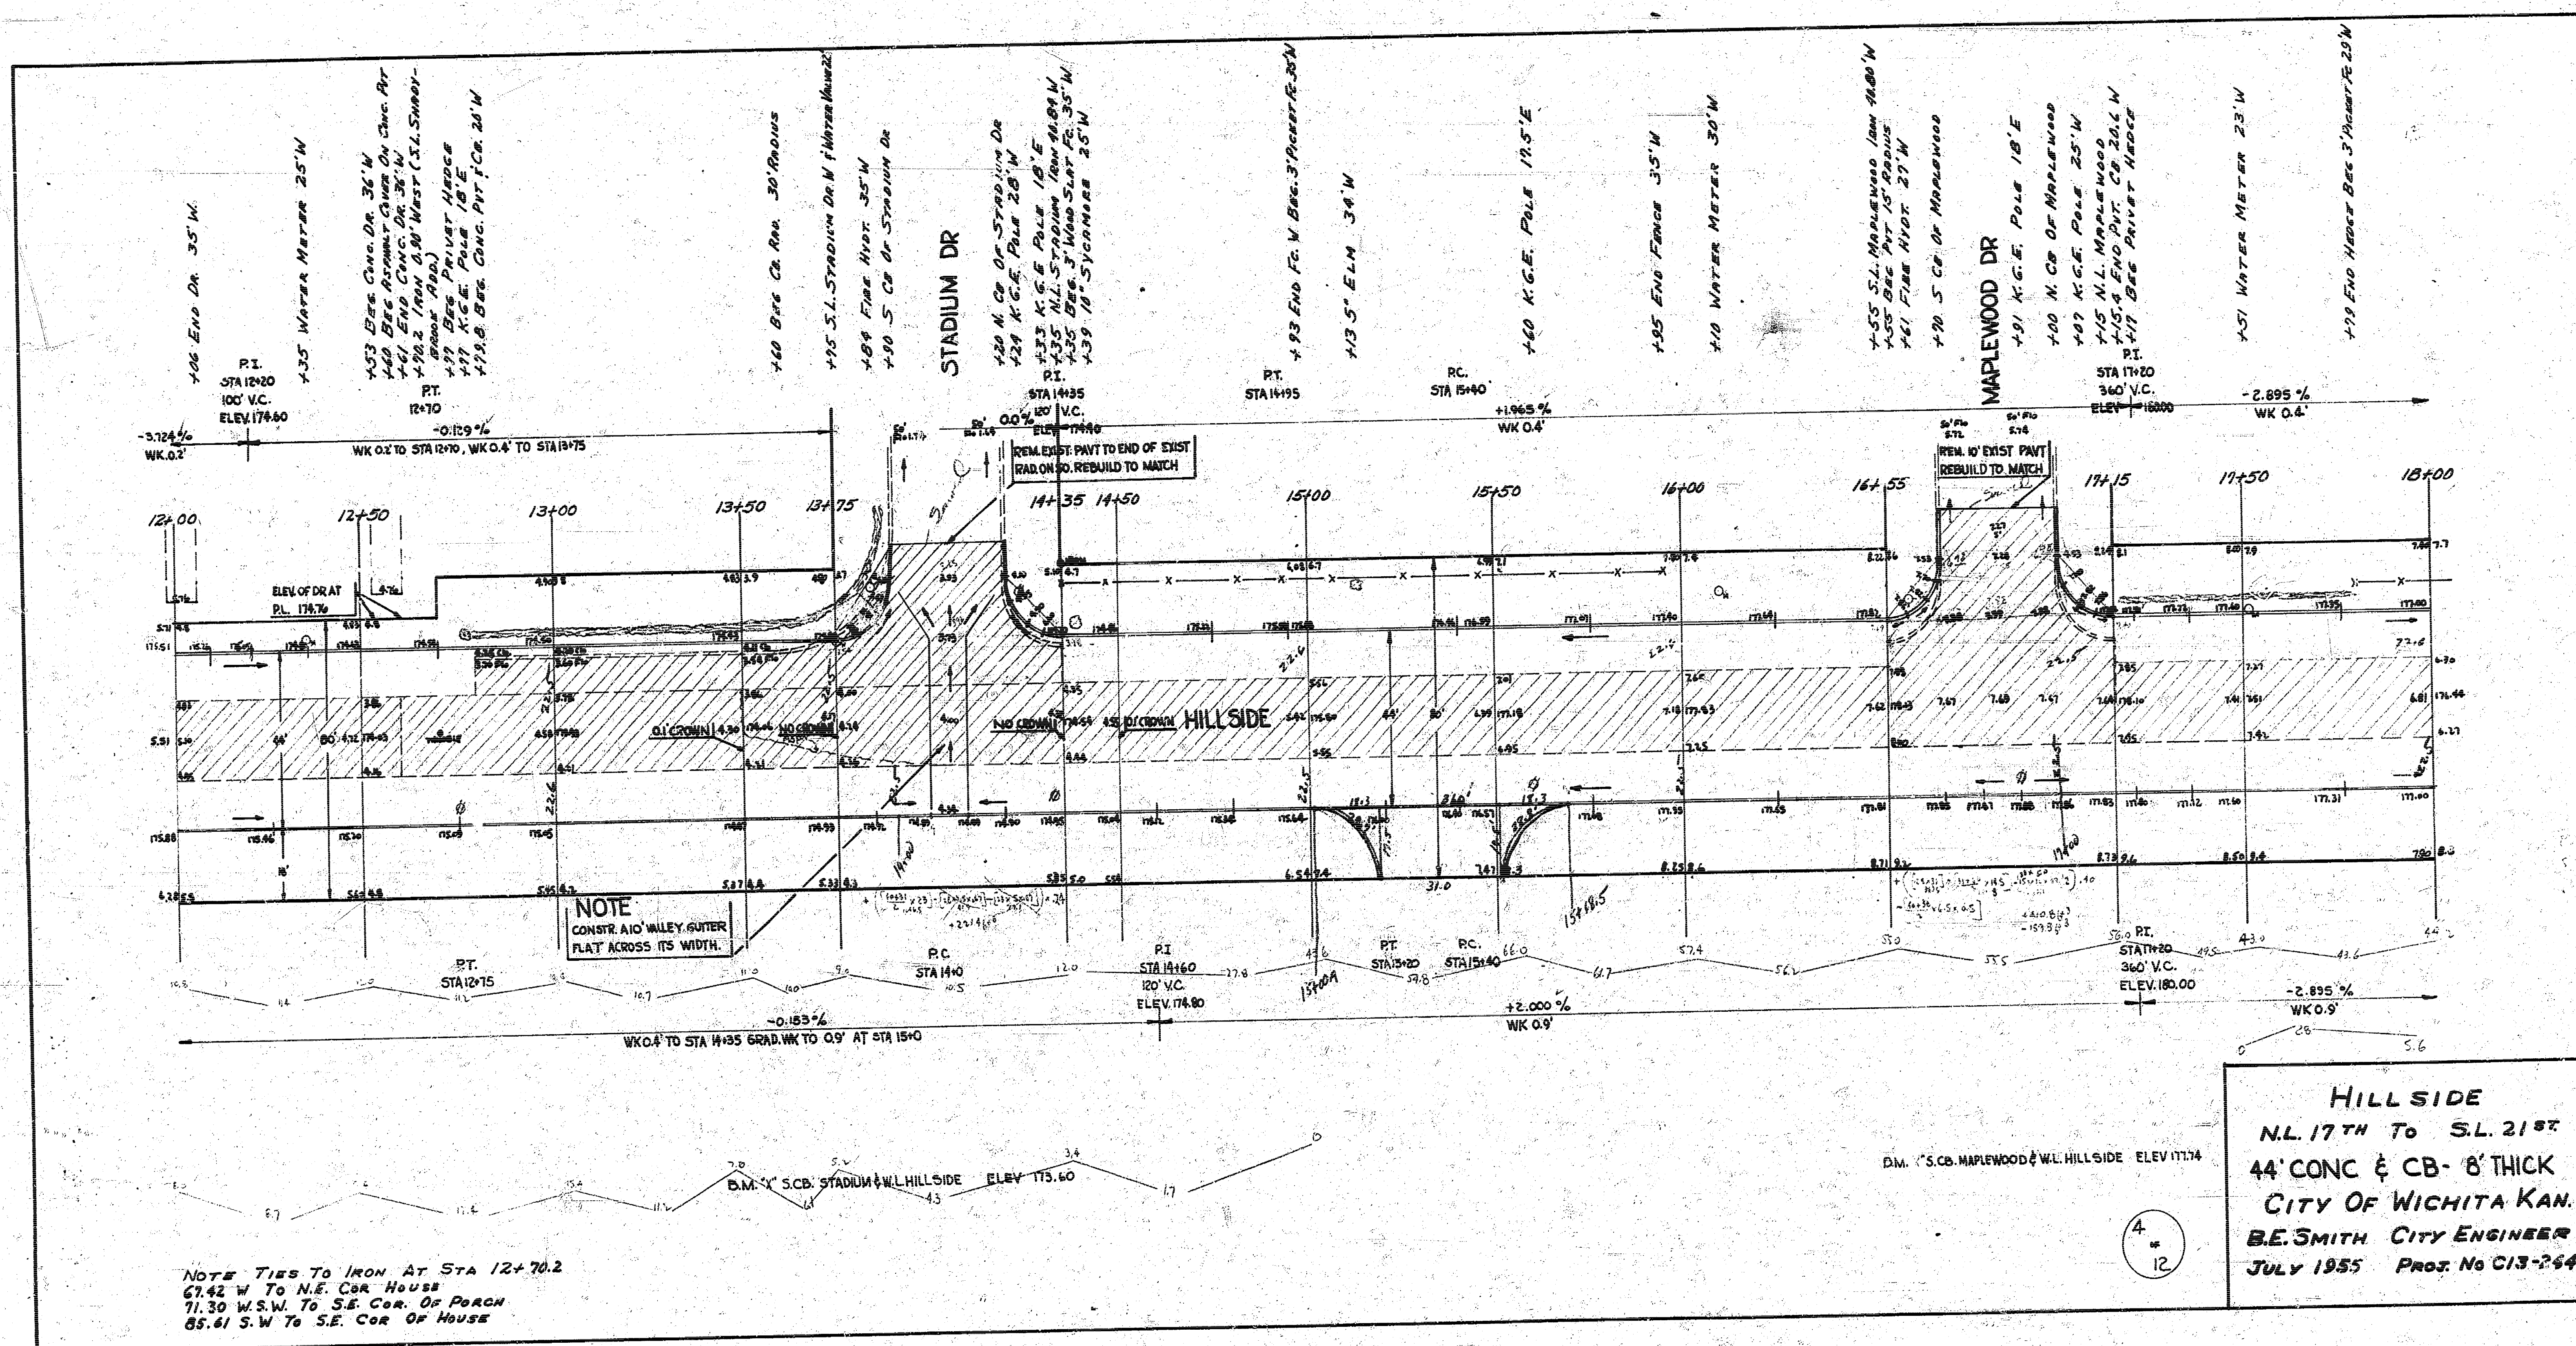


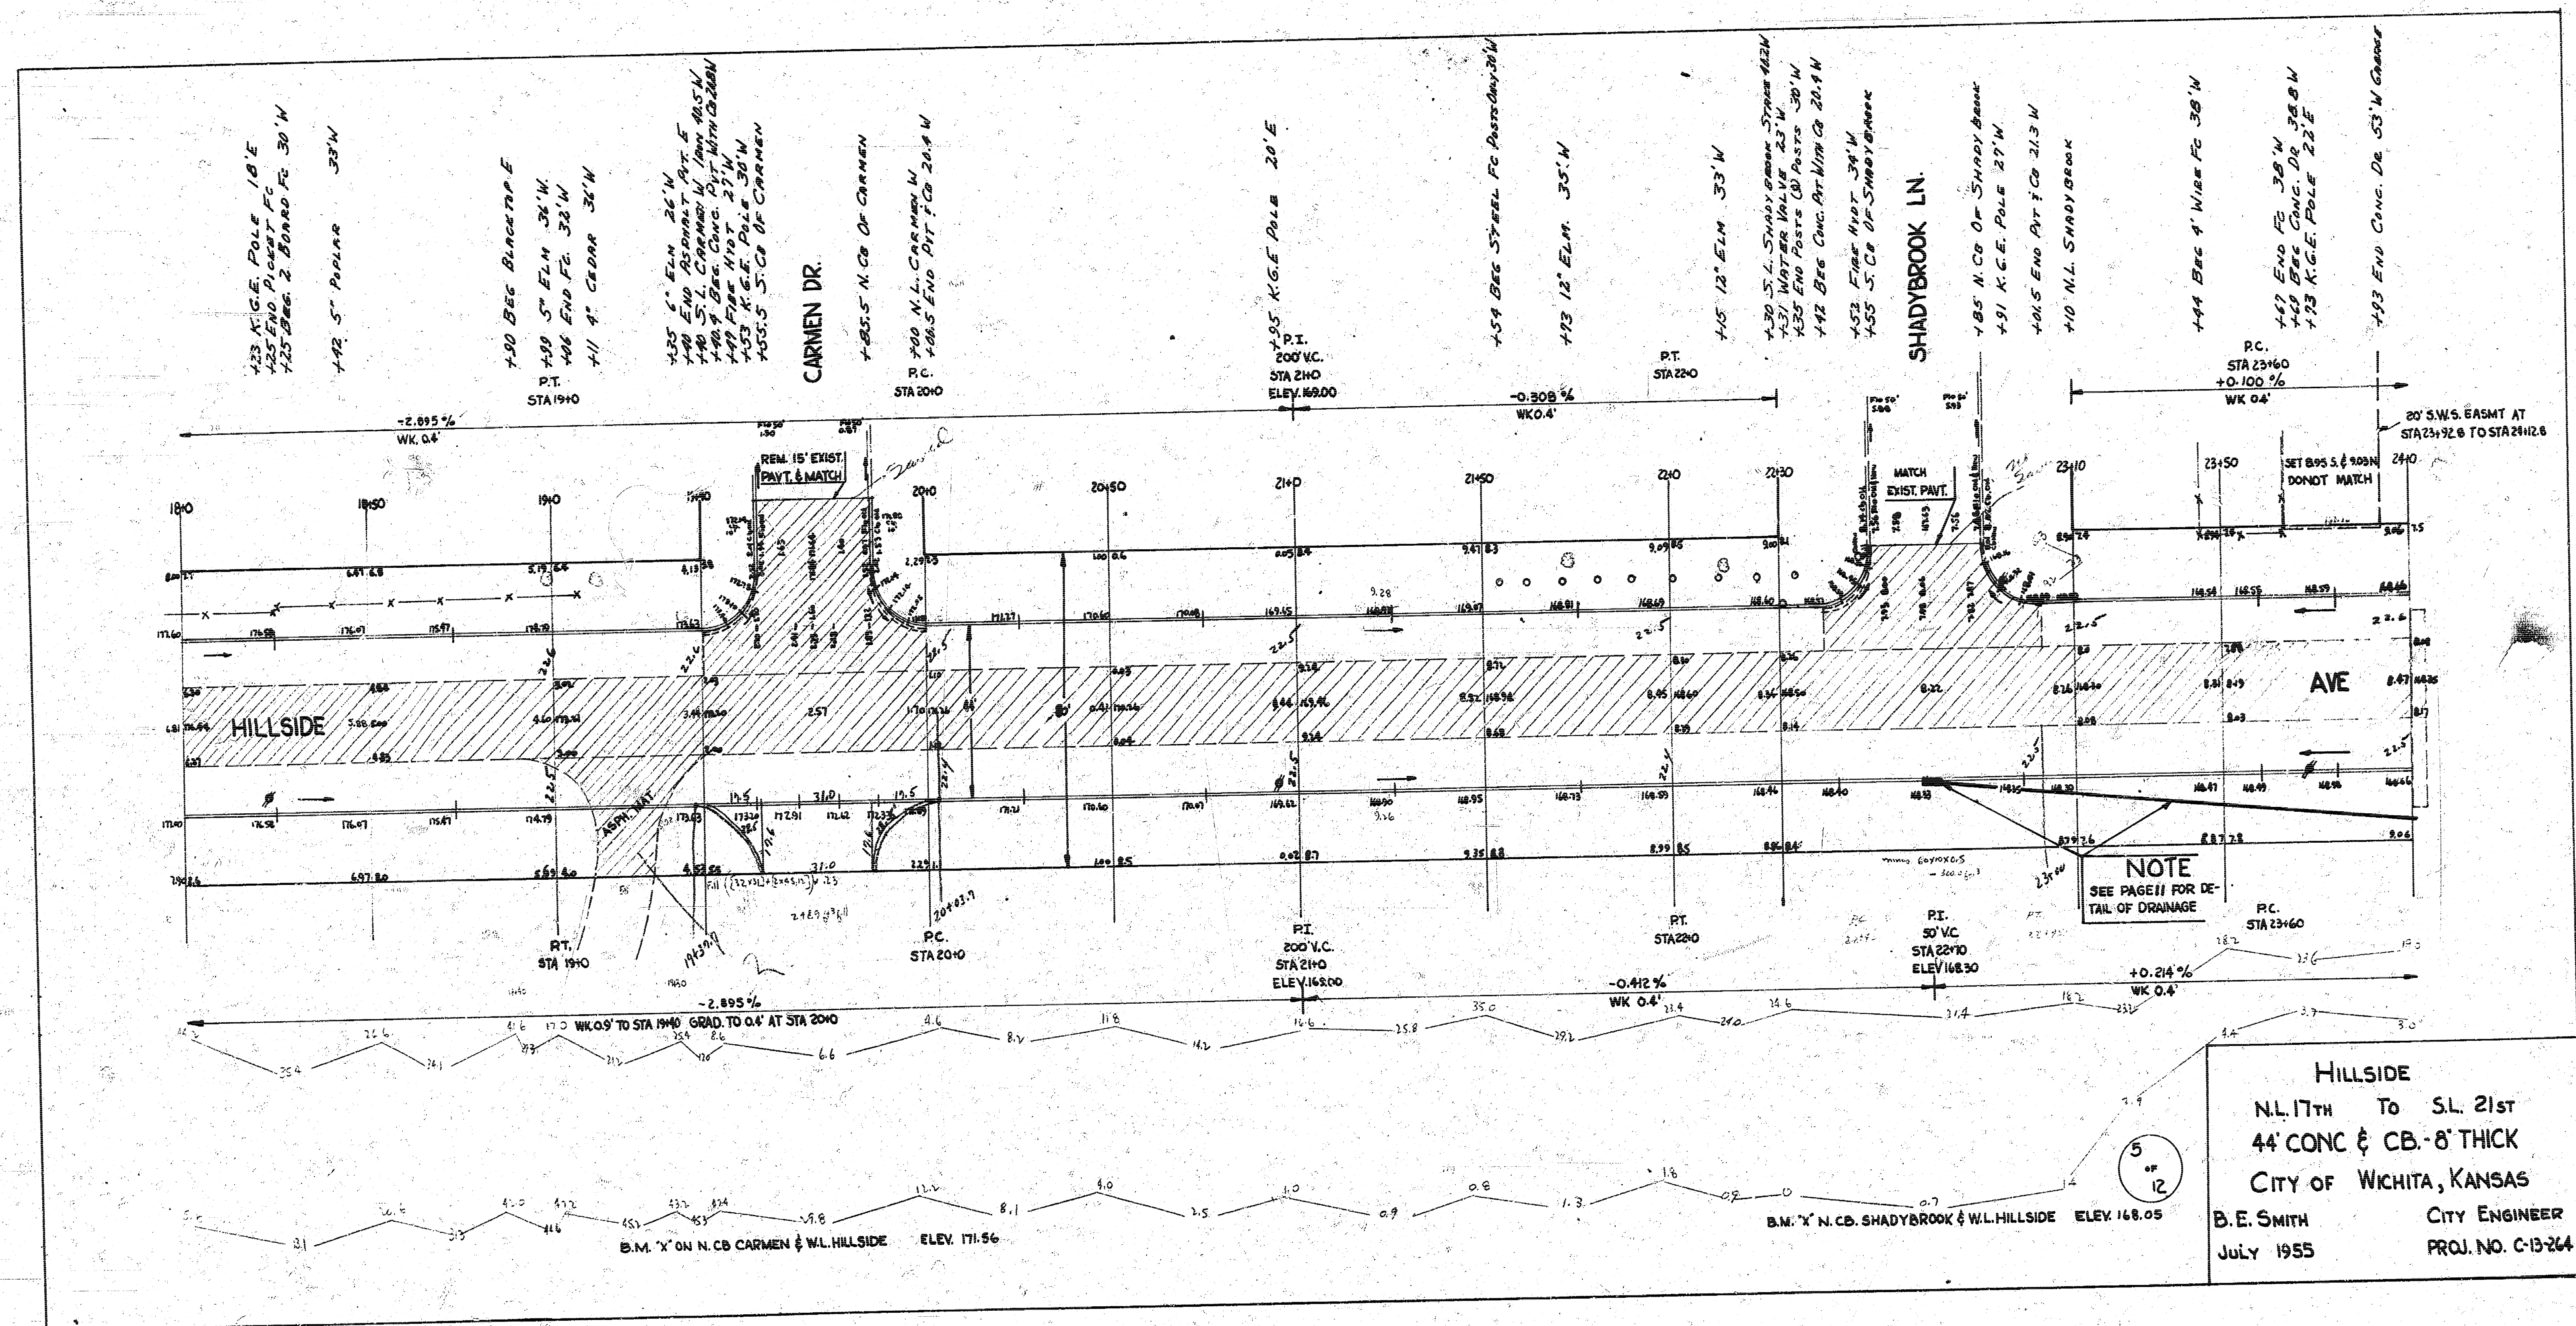



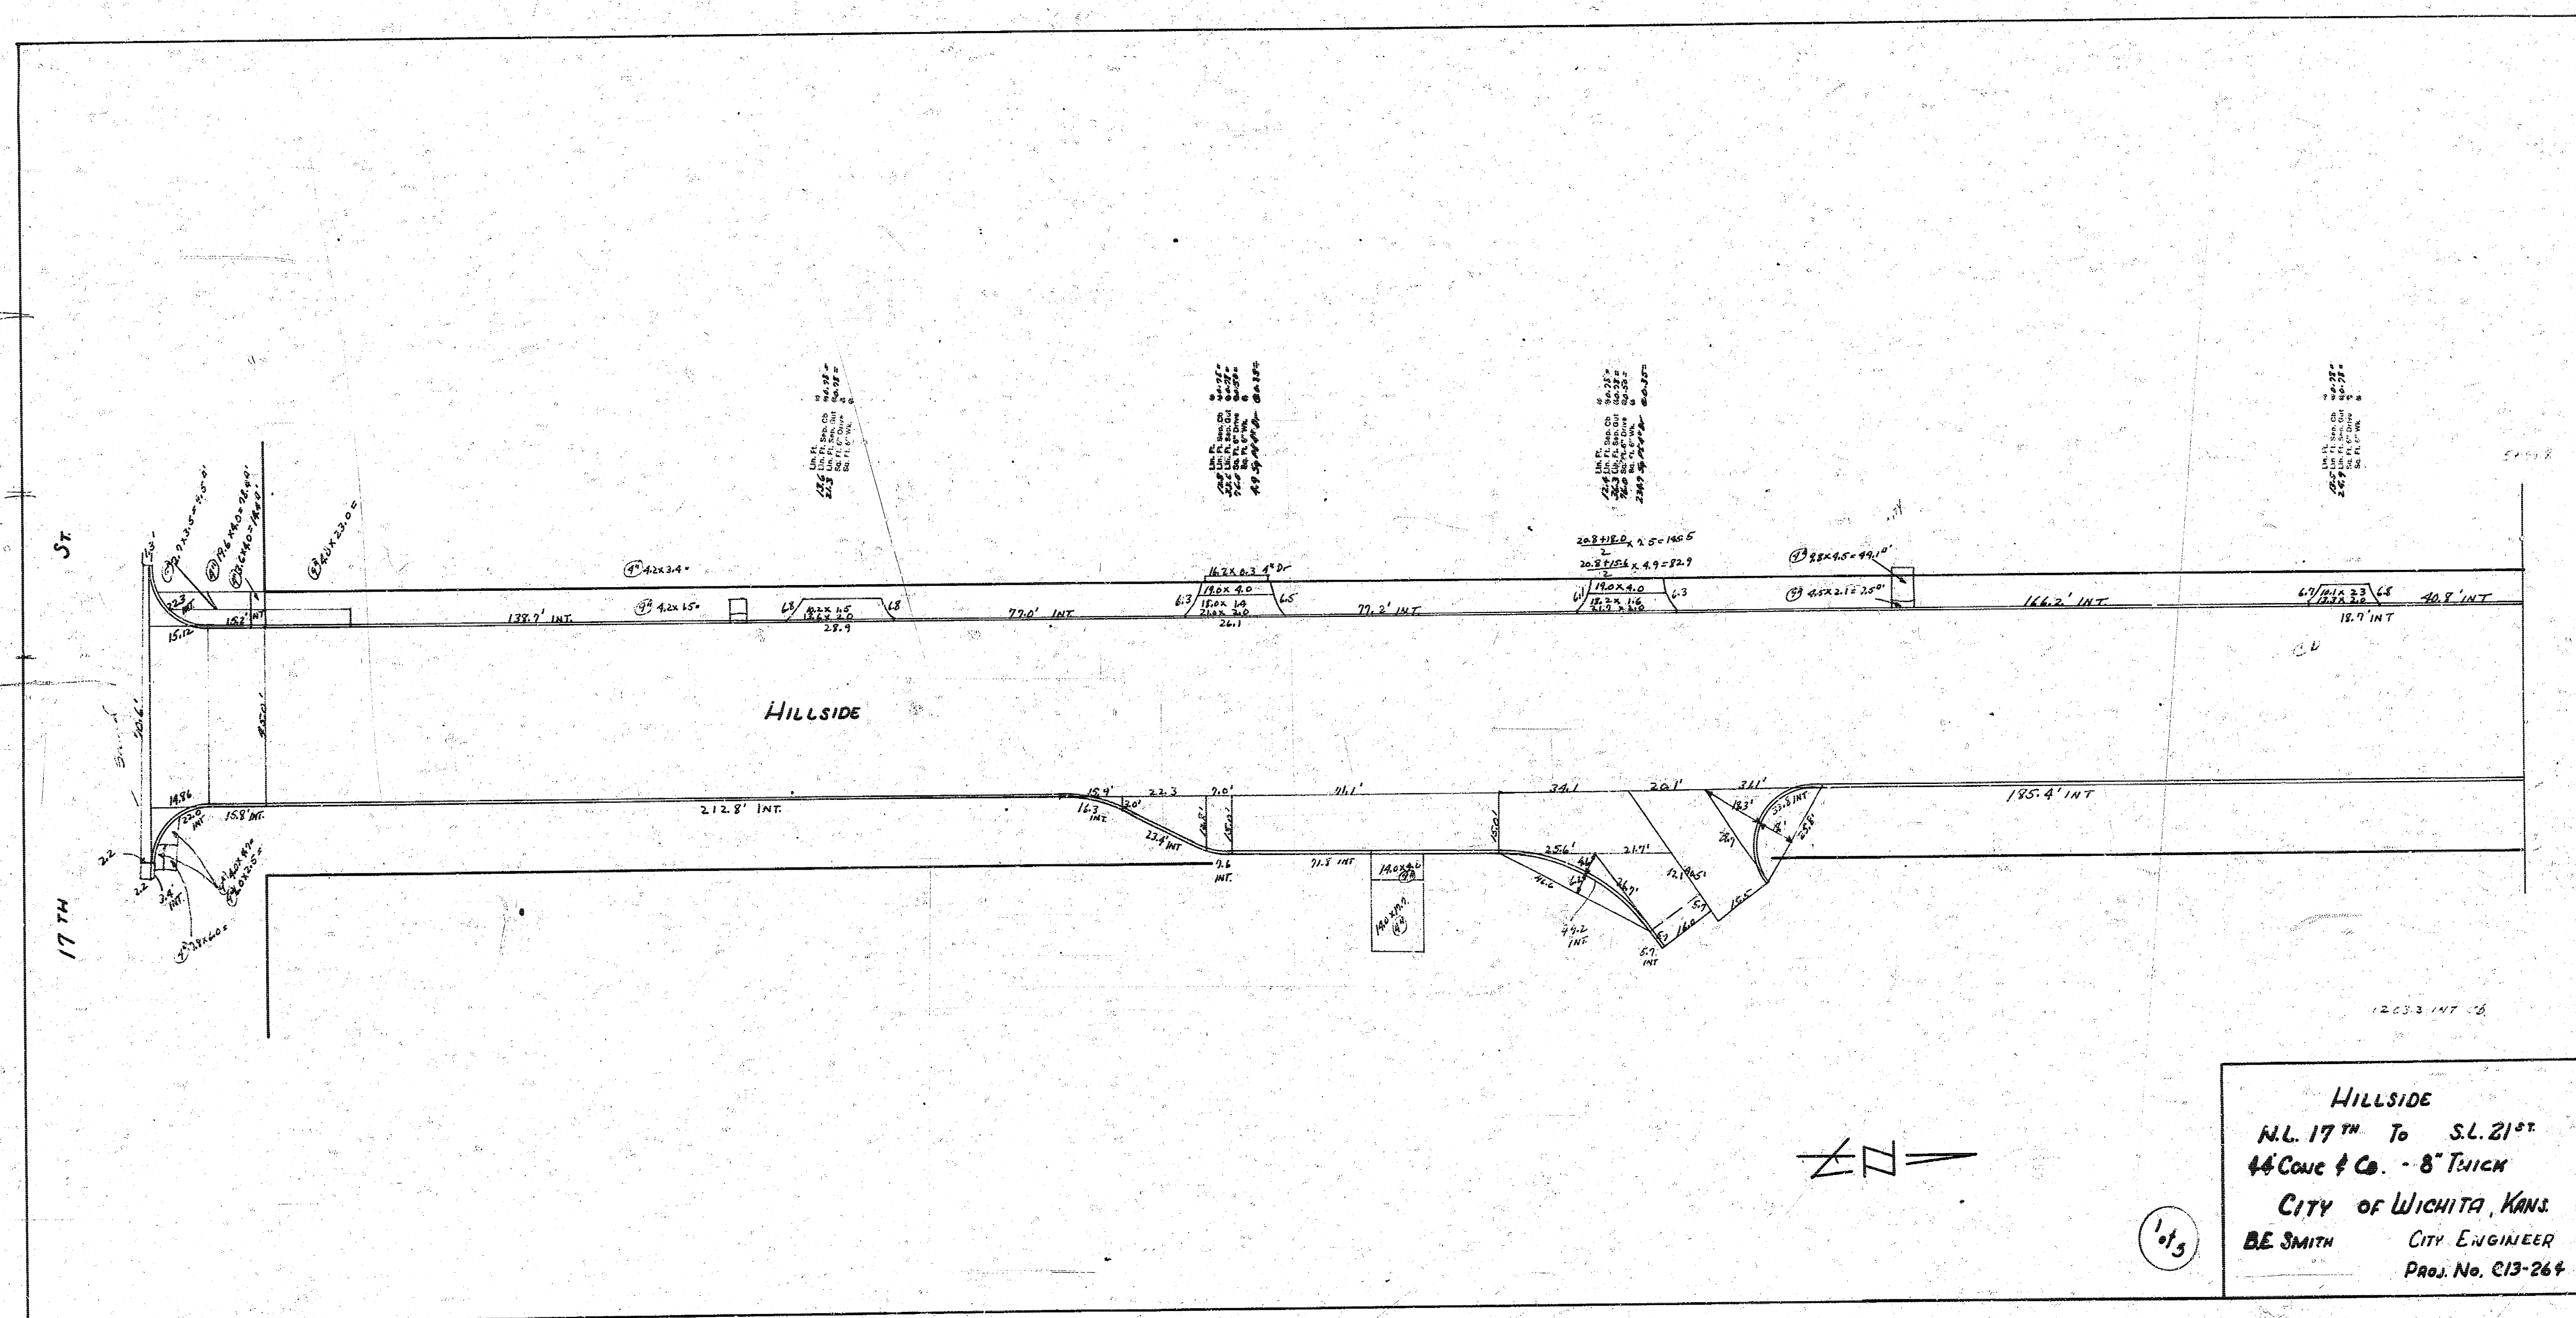

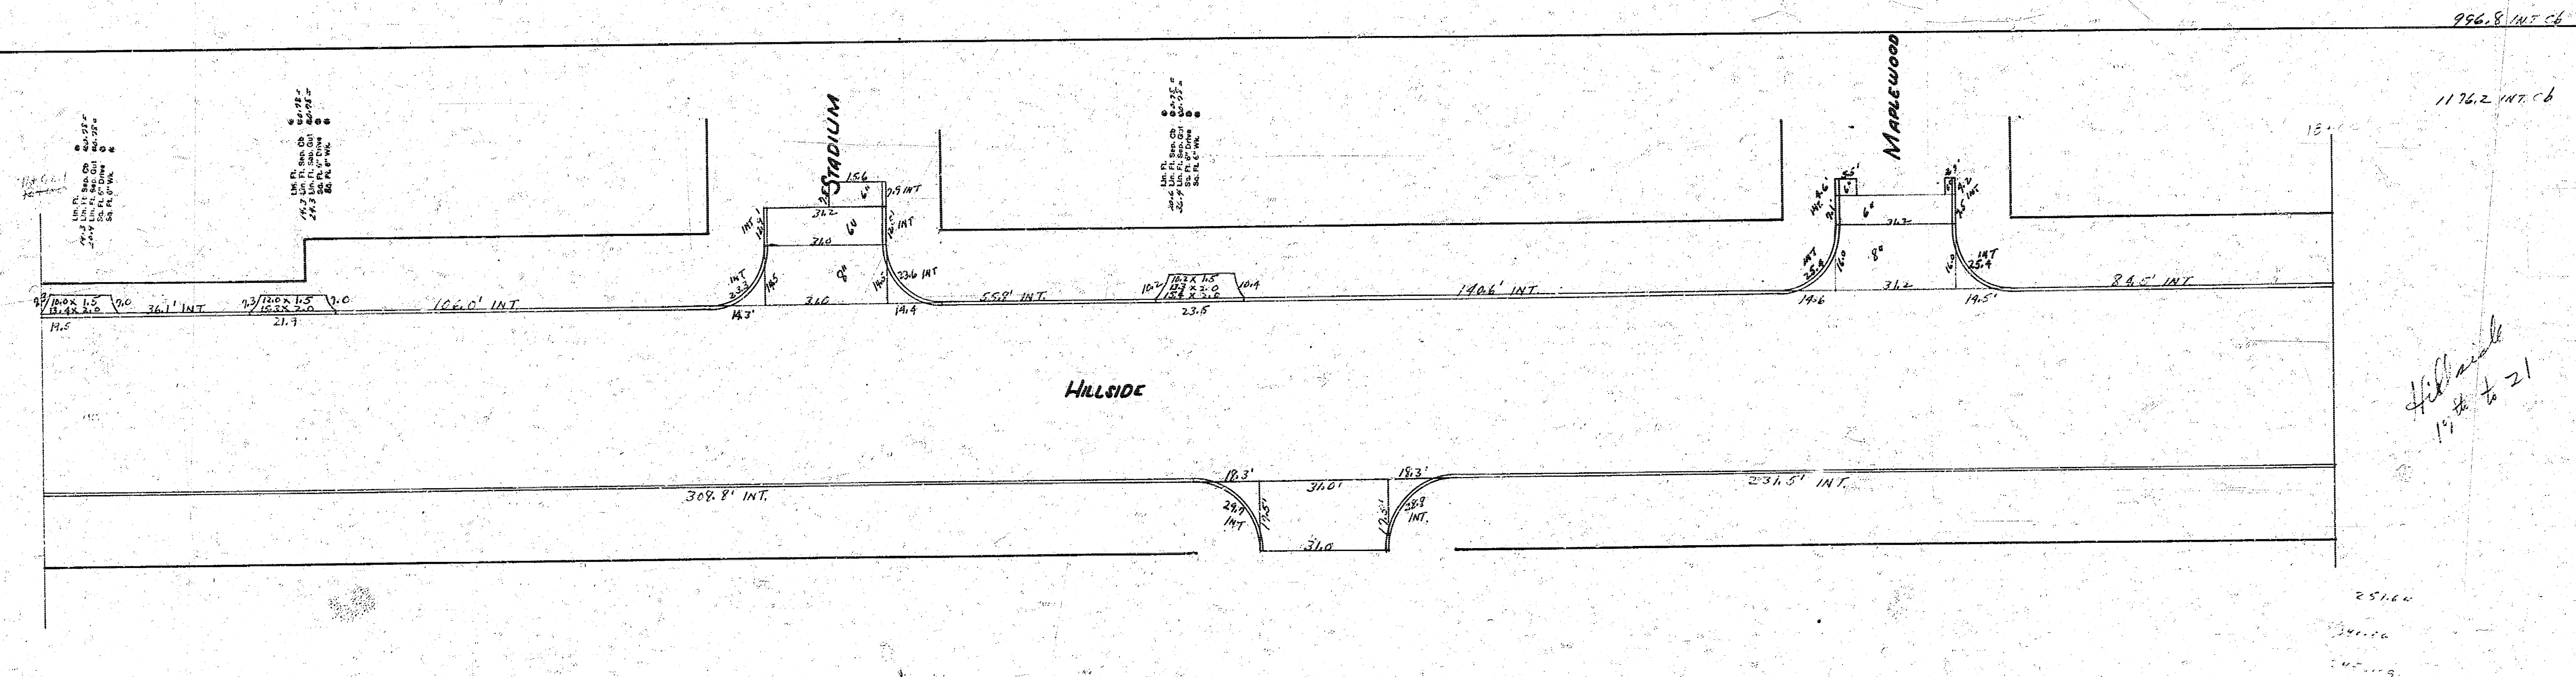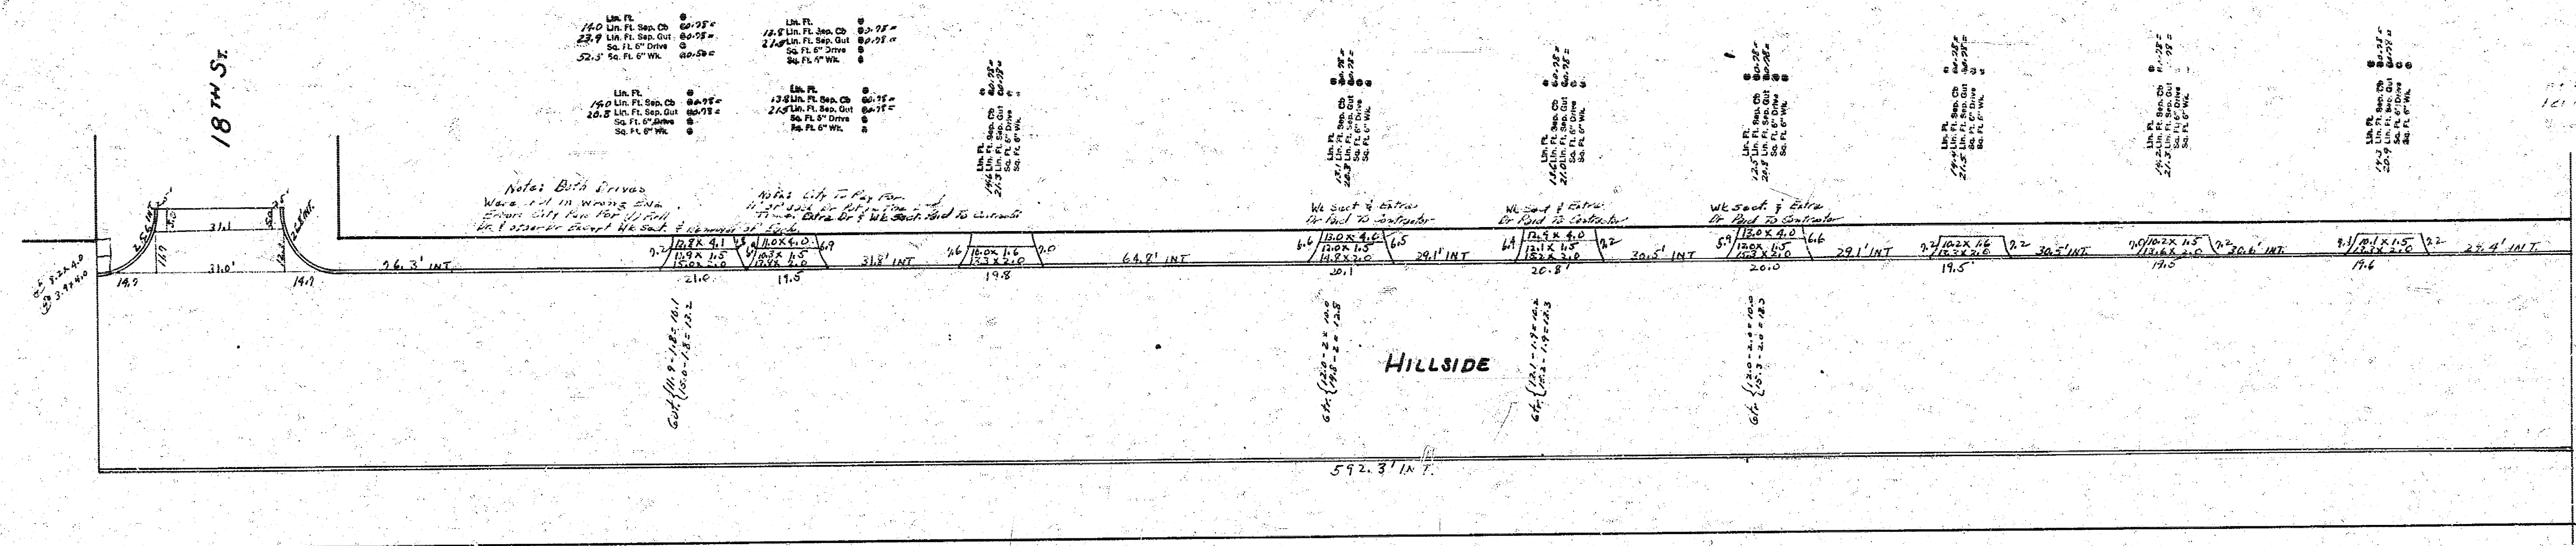

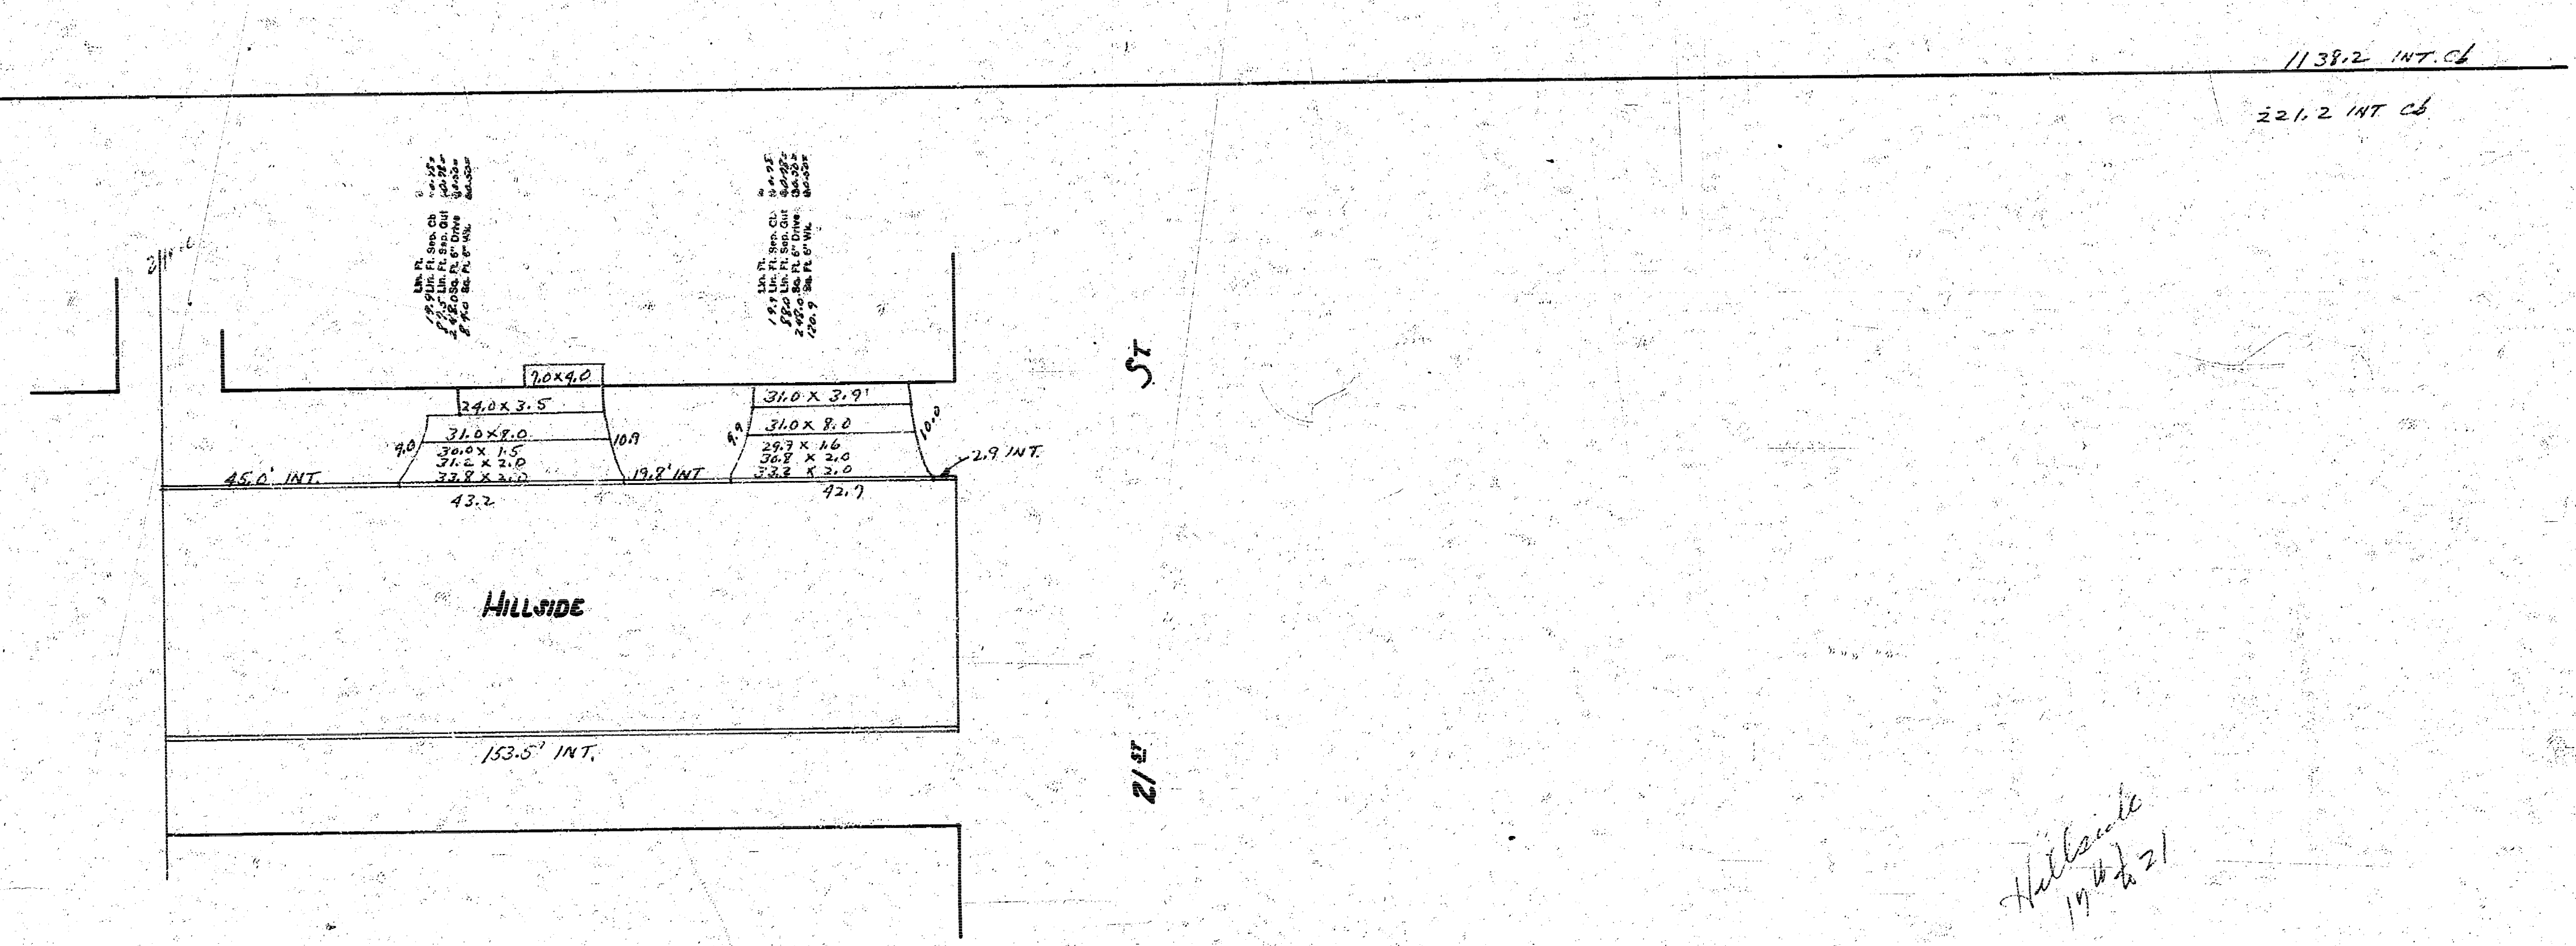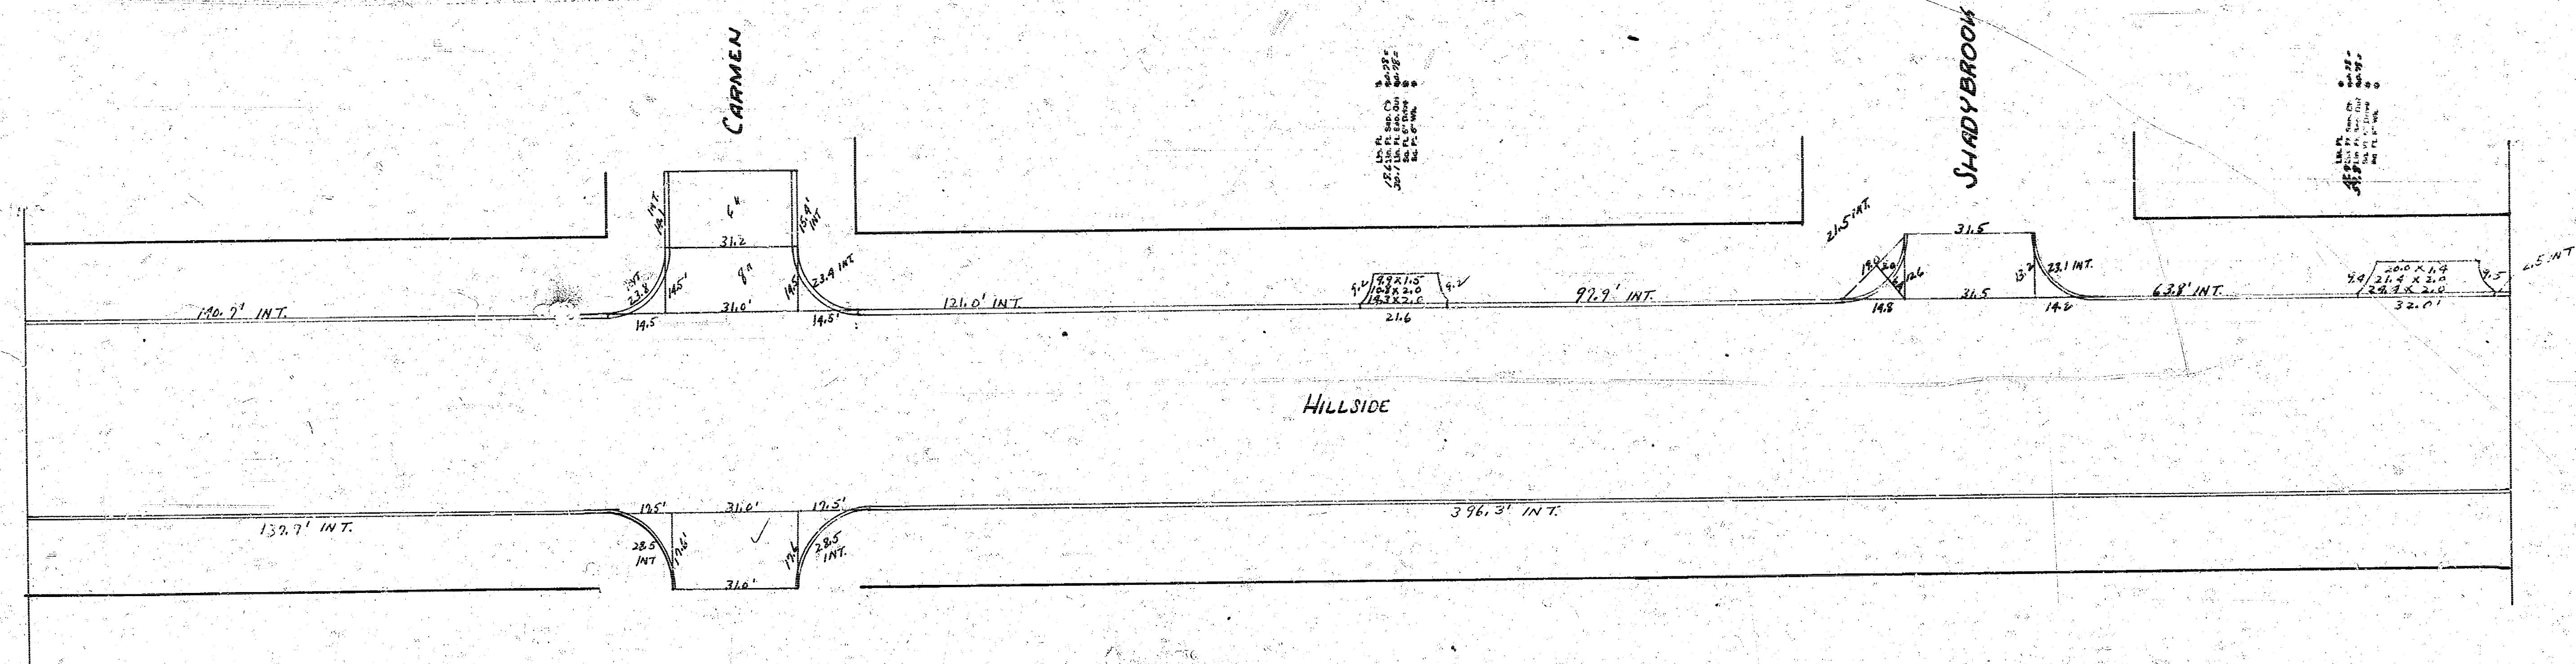

Hillside
19th & 21st



