


Ties To Iron E.L. Hood & 20th  
1. 62.14' N.E. to S.W. Cor. Porch Ho# 2102 Hood  
2 73.54' S.E. to N.W. Cor H# 2056  
3 54.63' S.W. to "B" in Globe W. of Hood & 20th

0475 E conc parking Stab.

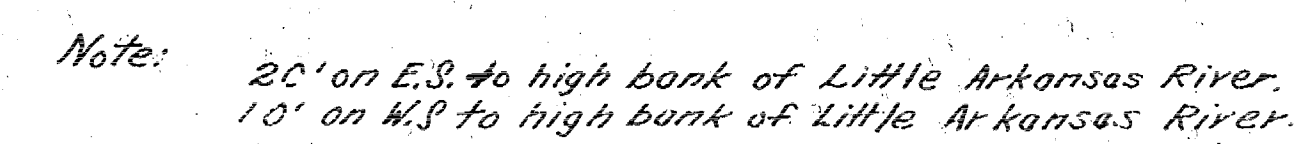

LITTLE ARKANSAS RIVER

80  
 54  
 663  
 100  
 784  
 883  
 1080  
 500

HOOD AVE  
N.L. 20<sup>TH</sup> TO S.L. FERRELL DR  
30' cons'f' ch.  
CITY OF WICHITA, KANS.  
L. K. WHITE CITY ENGINEER  
APRIL, 1950 PROJ. No. C10-20