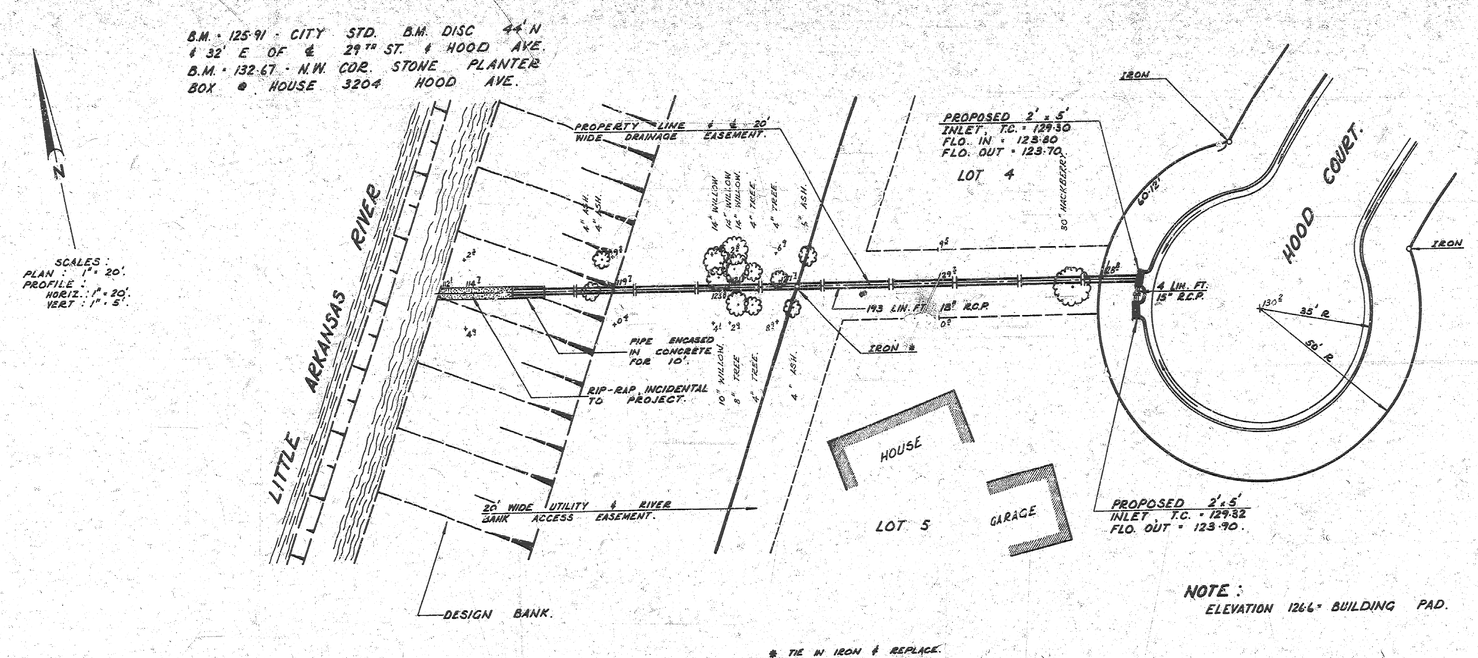

NOTE:
ELEVATION 126.6 = BUILDING PAD.

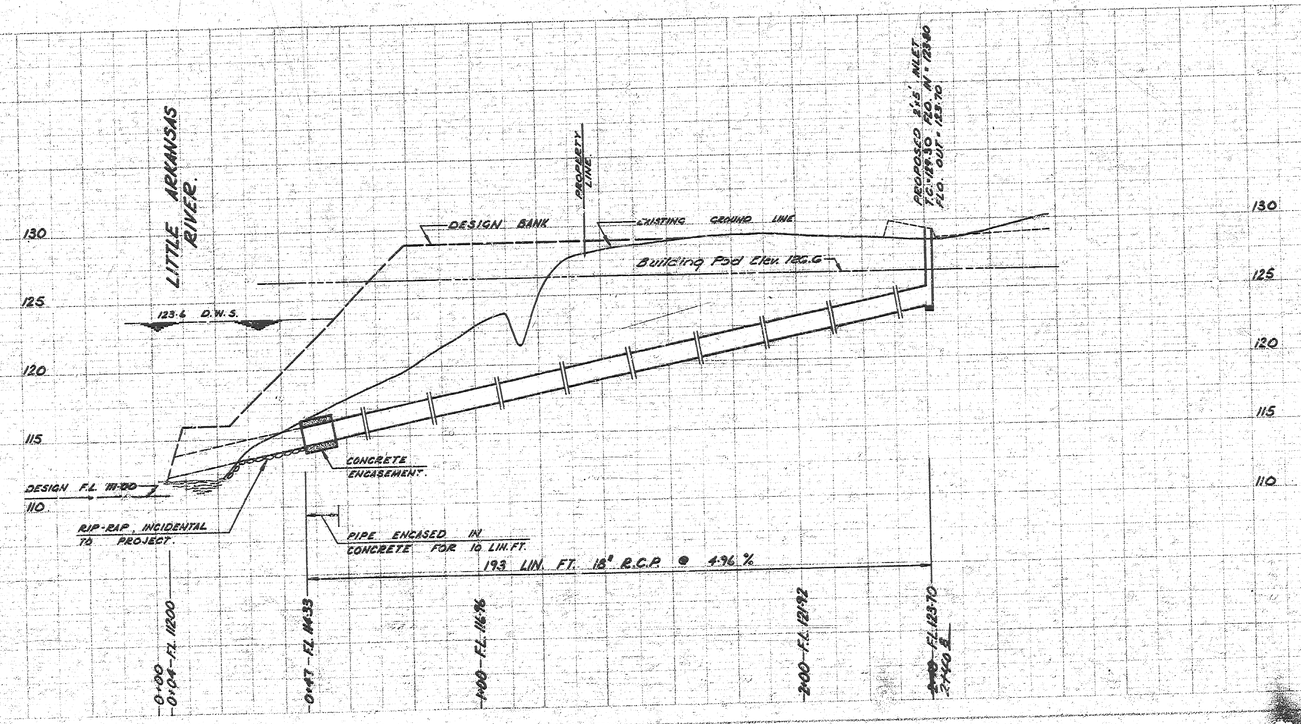

As Built 10-8-75

"DRAINAGE" IN CONNECTION WITH PAVING OF HOOD CT.
CITY OF WICHITA, KANSAS.
R.W. LINN. - CITY ENGINEER.
DATE: PROJ. NO. DAKD 574081.

R. W. LINN LICENSED 3684 KANSAS PROFESSIONAL ENGINEER

RIGGS BUTTERFIELD 1-22-75 2-6-75

PLAN AR 90

PLATE 1 PLAN PROFILE