C.M. #68

B.M. 108.91 "B" in S. Blake, c. Wt. N., N.W. Everett & Irving
B.M. 107.34 Iron in thim. c Bonn & N.S. Mc Cormick
B.M. 108.32 Iron in thim. c Everett & N.S. Mc Cormick
B.M. 109.04 S.W. cor. conc. porch, Ho N.W. Bonn & Irving
B.M. 106.96 Iron in thim. c Hiram & N.S. Mc Cormick
B.M. 106.59 "+" on cb. rad., S.W. cor. Hiram & Irving

TIES

C. Irving & C. Everett Mon. 10"
39.84 N.E. to "T" in Timmons bk. Wt. E.
56.55 N.W. to "B" in S. Blake C. Wt. N.
69.33 S.E. to mid. 3 nails W.S. Elm.

C. Bonn & C. Irving Mon. 6"
46.71 S.E. to mid. 3 nails W.S. Cottonwood
51.97 N.E. to "K" in Keeler, C. of E. and app. Wk.
74.58 S.W. to N.E. cor. conc. porch.

C. Hiram & C. Irving
Iron pin in pav. = 2.5' S. of ℄ of cb. ends W.

Excav.

Prop.
141.1
137.4
134.8
136.7
134.1
126.5
114.8
54.0
977.4
+10% 97.7
1075.1 Cu Yds.

City
187.6
89.8
106.0
383.4
+10% 38.3
421.7 Cu Yds.

Grand Total Excav.

Prop
1075.1
702.7
total 1777.8 Cu Yds

City
421.7
321.5
total 743.2 Cu Yds

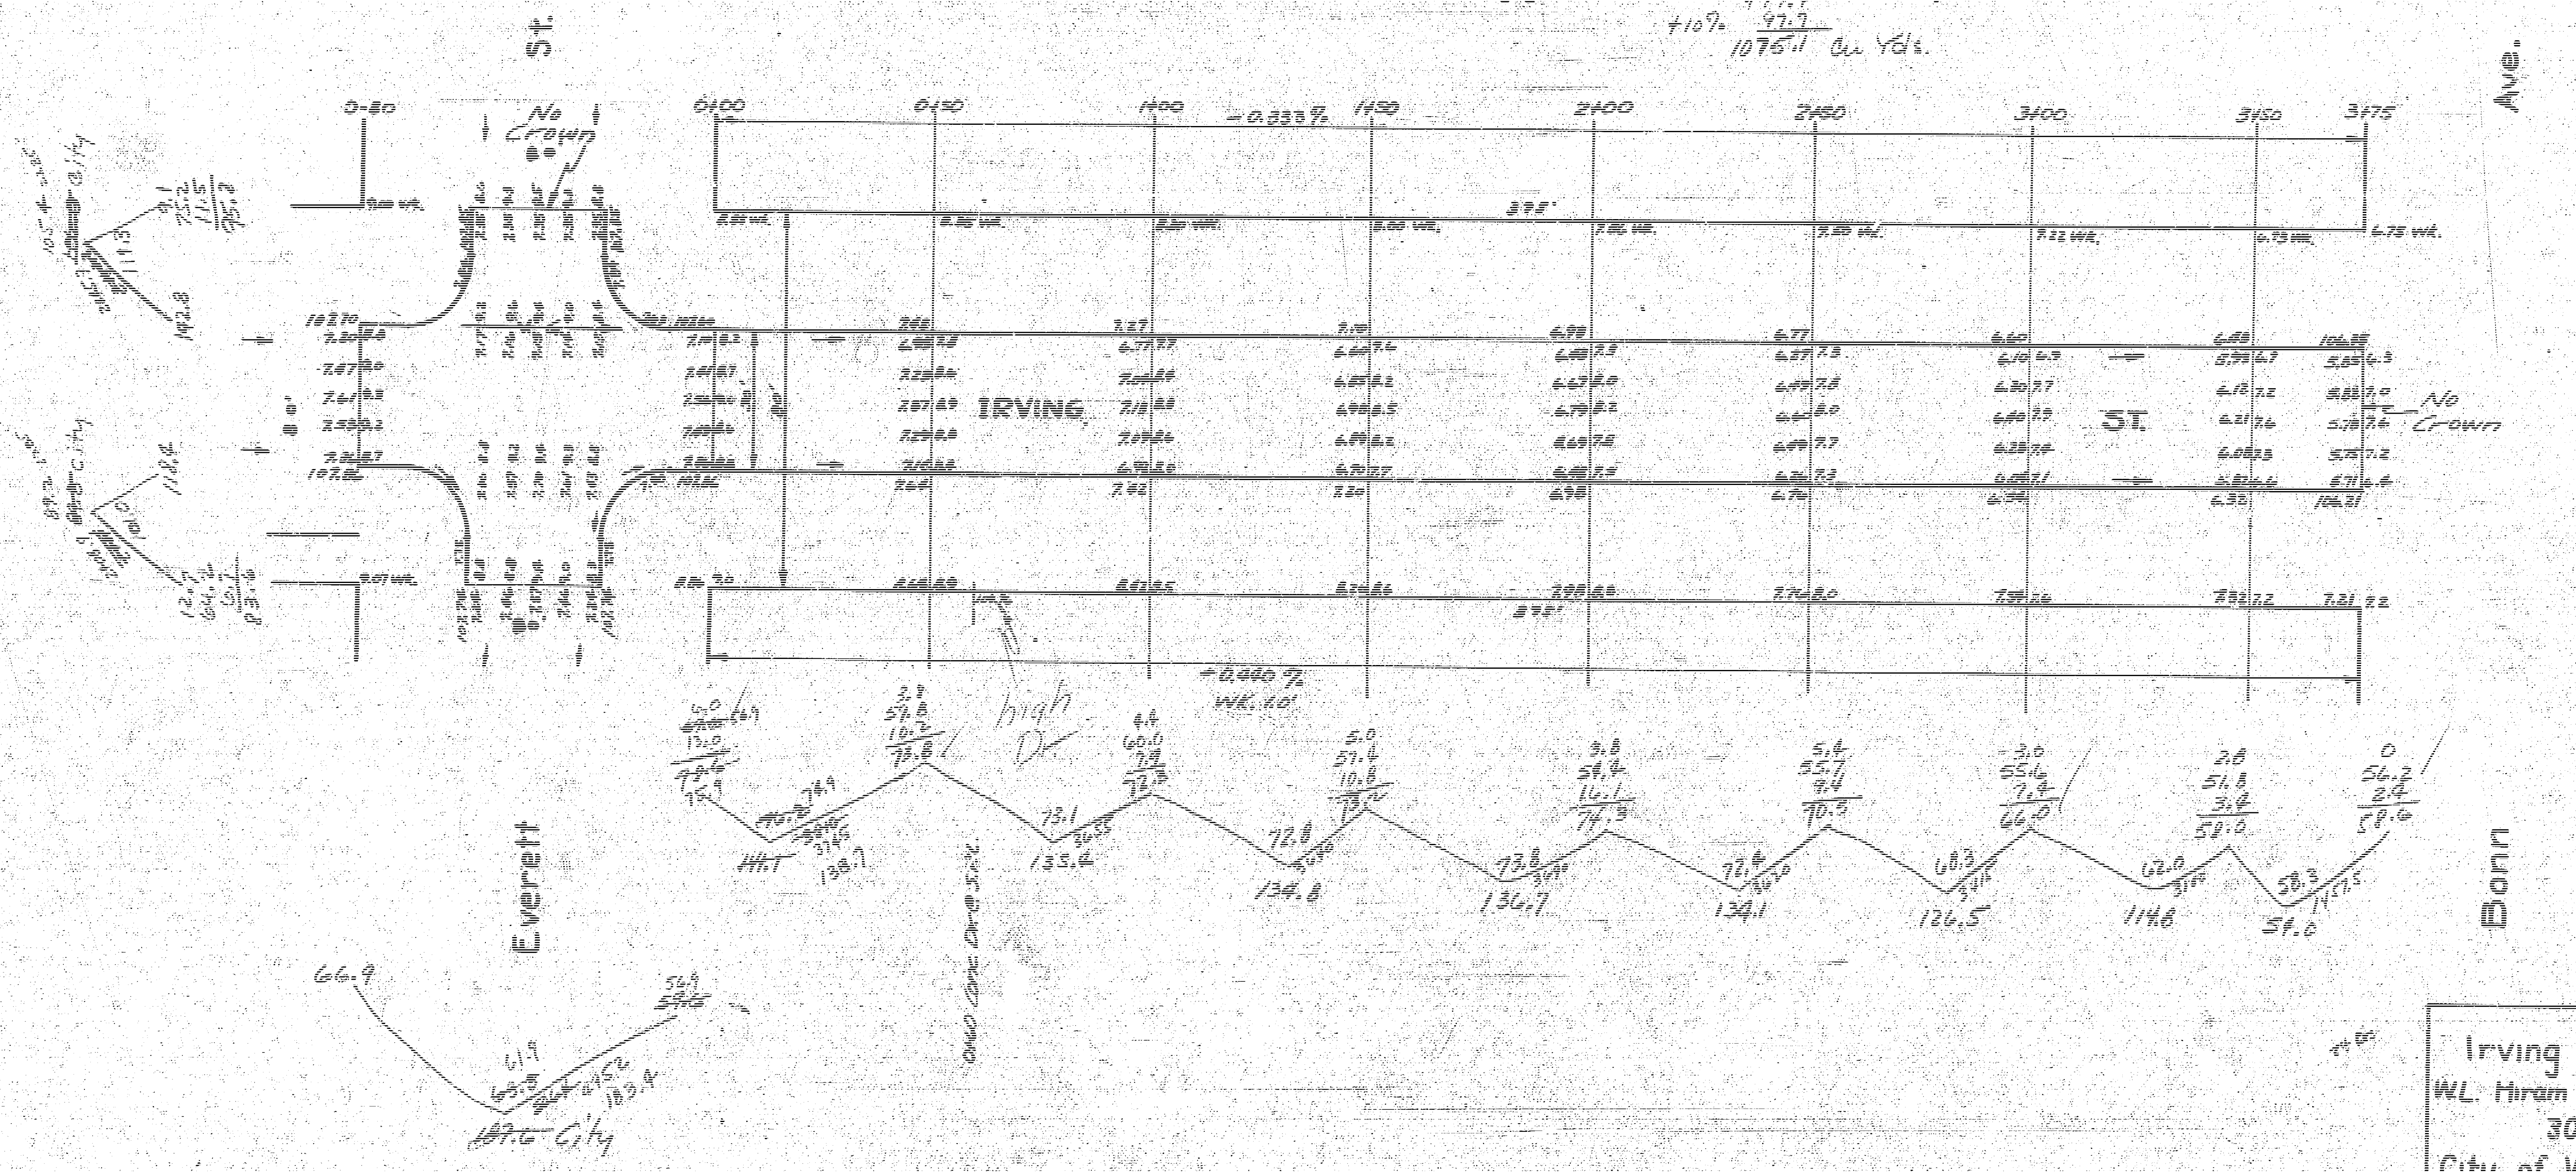

1/2

Irving St.
W.L. Hiram to W.L. Everett
30' conc. & curb
City of Wichita, Kansas
L. K. White ~ City Engineer
June 1950 Proj. C-10-60

C.M. #68

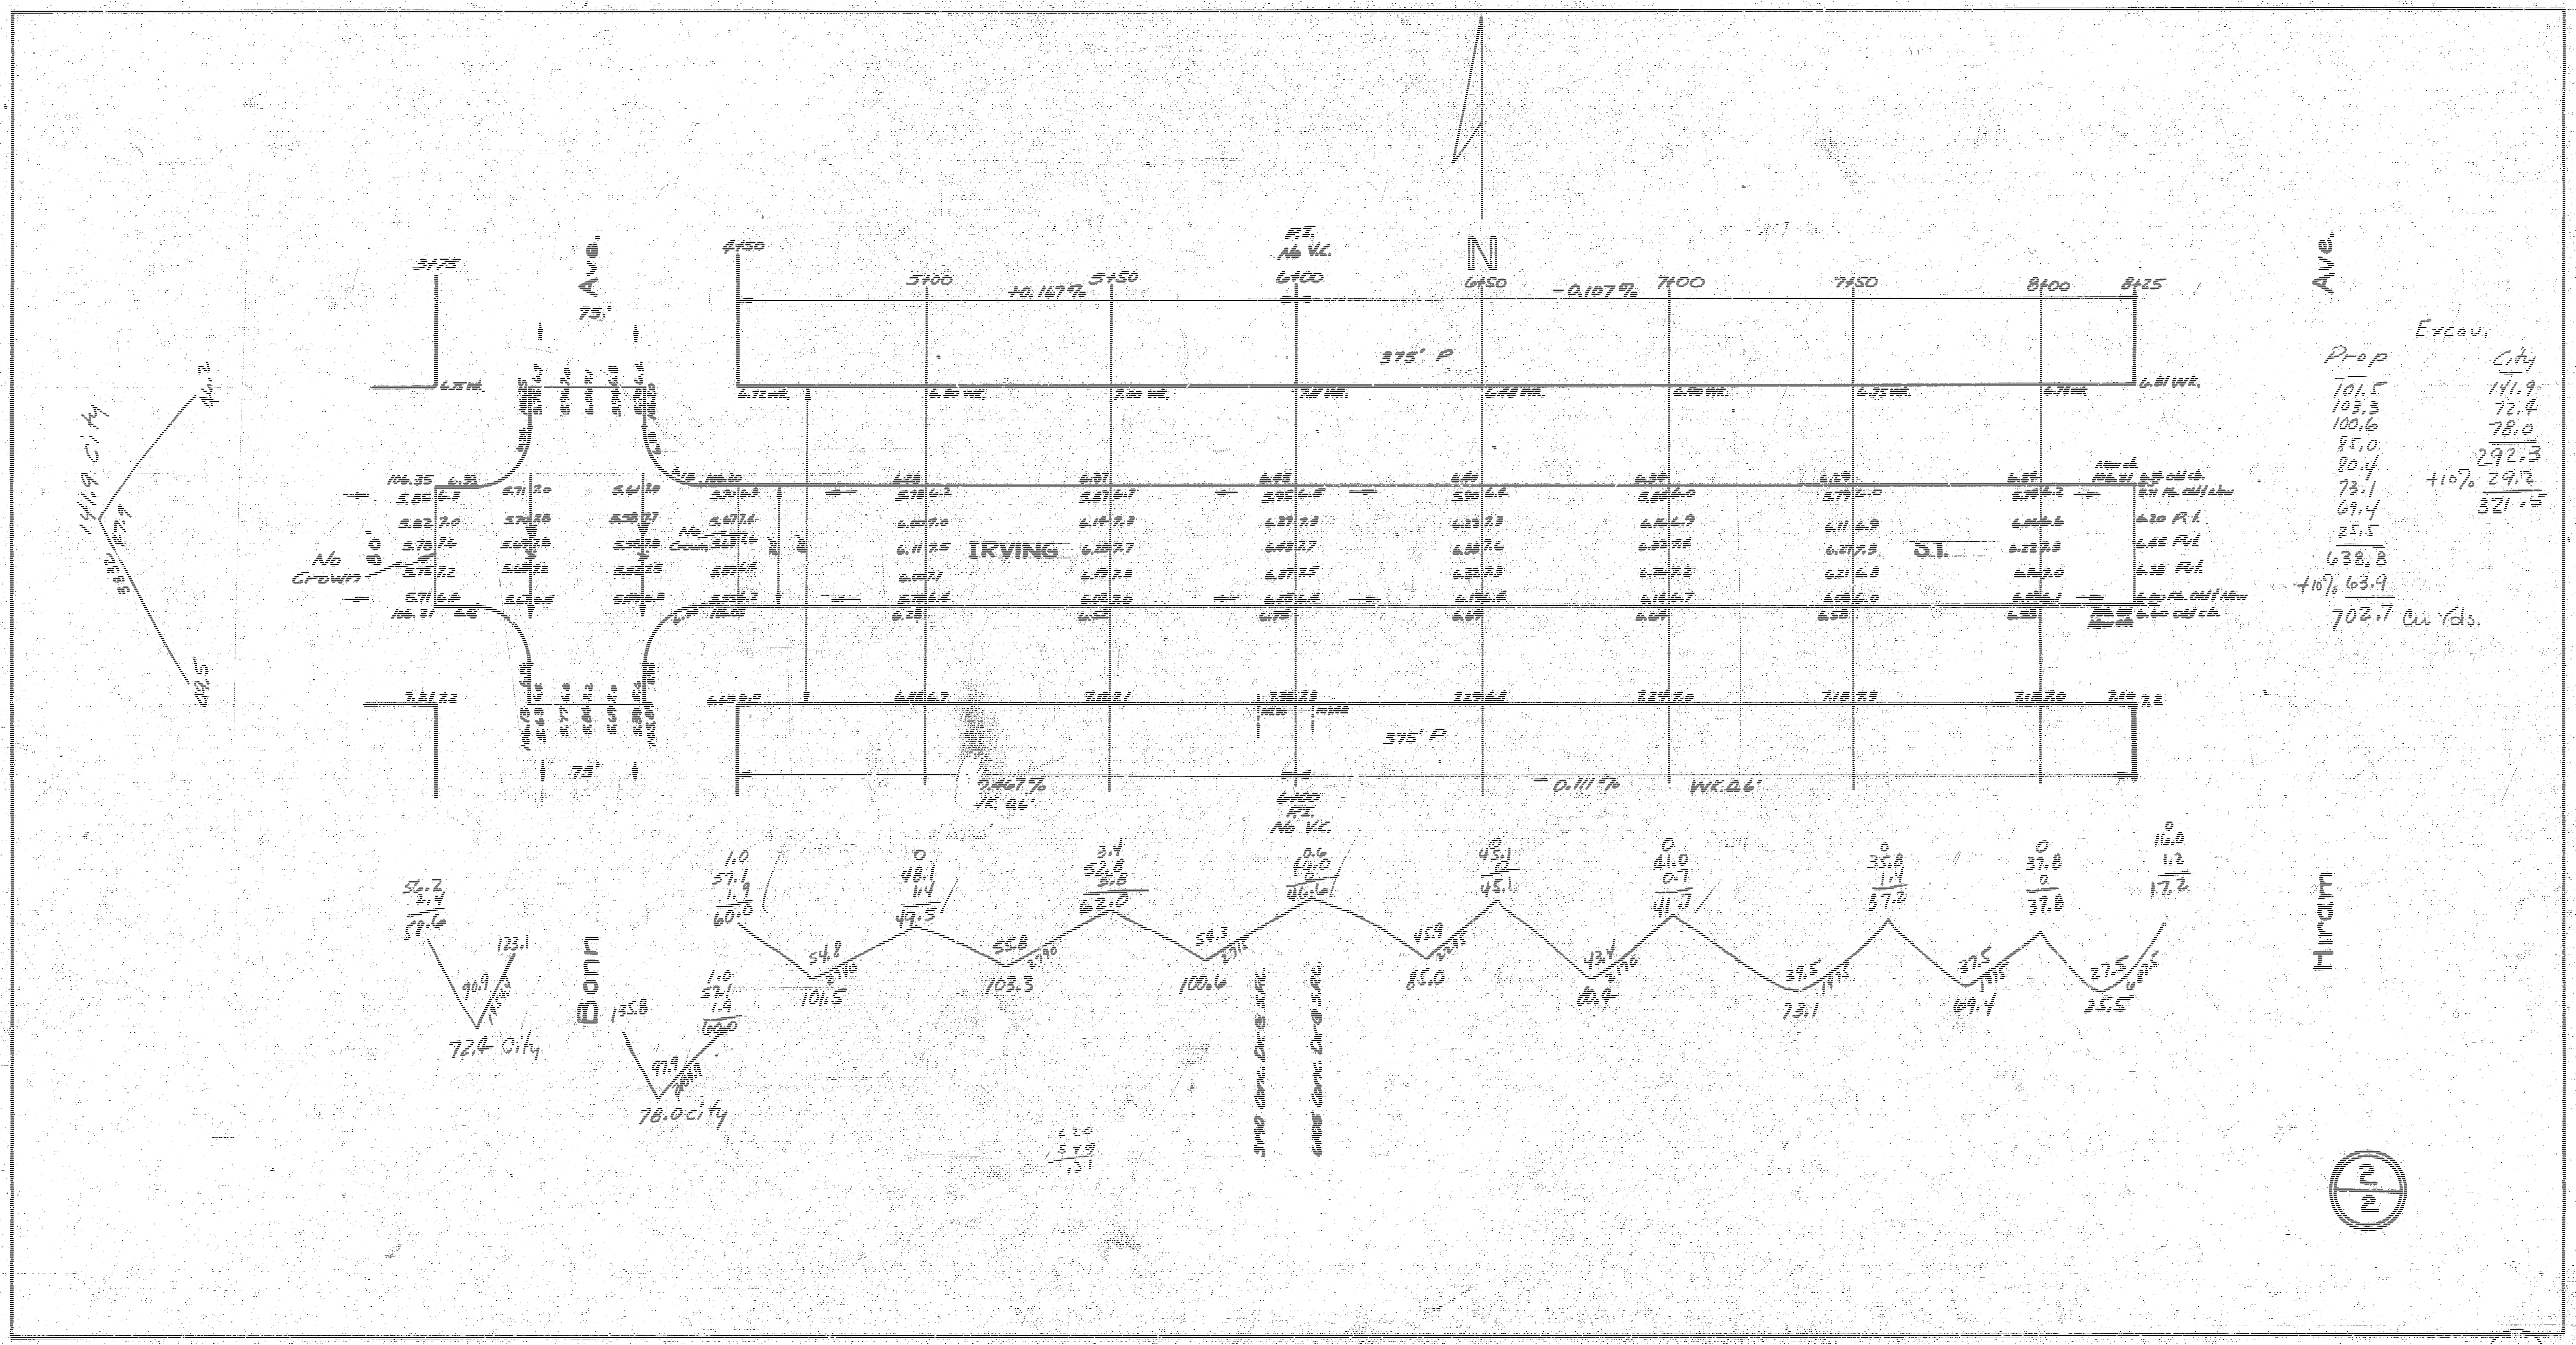

Excav.

Prop	City
101.5	141.9
103.3	72.4
100.6	78.0
85.0	292.3
80.4	+10% 29.2
73.1	321.5
69.4	
25.5	
638.8	
+10% 63.9	
702.7 Cu. Yds.	

4 6 5 (55)