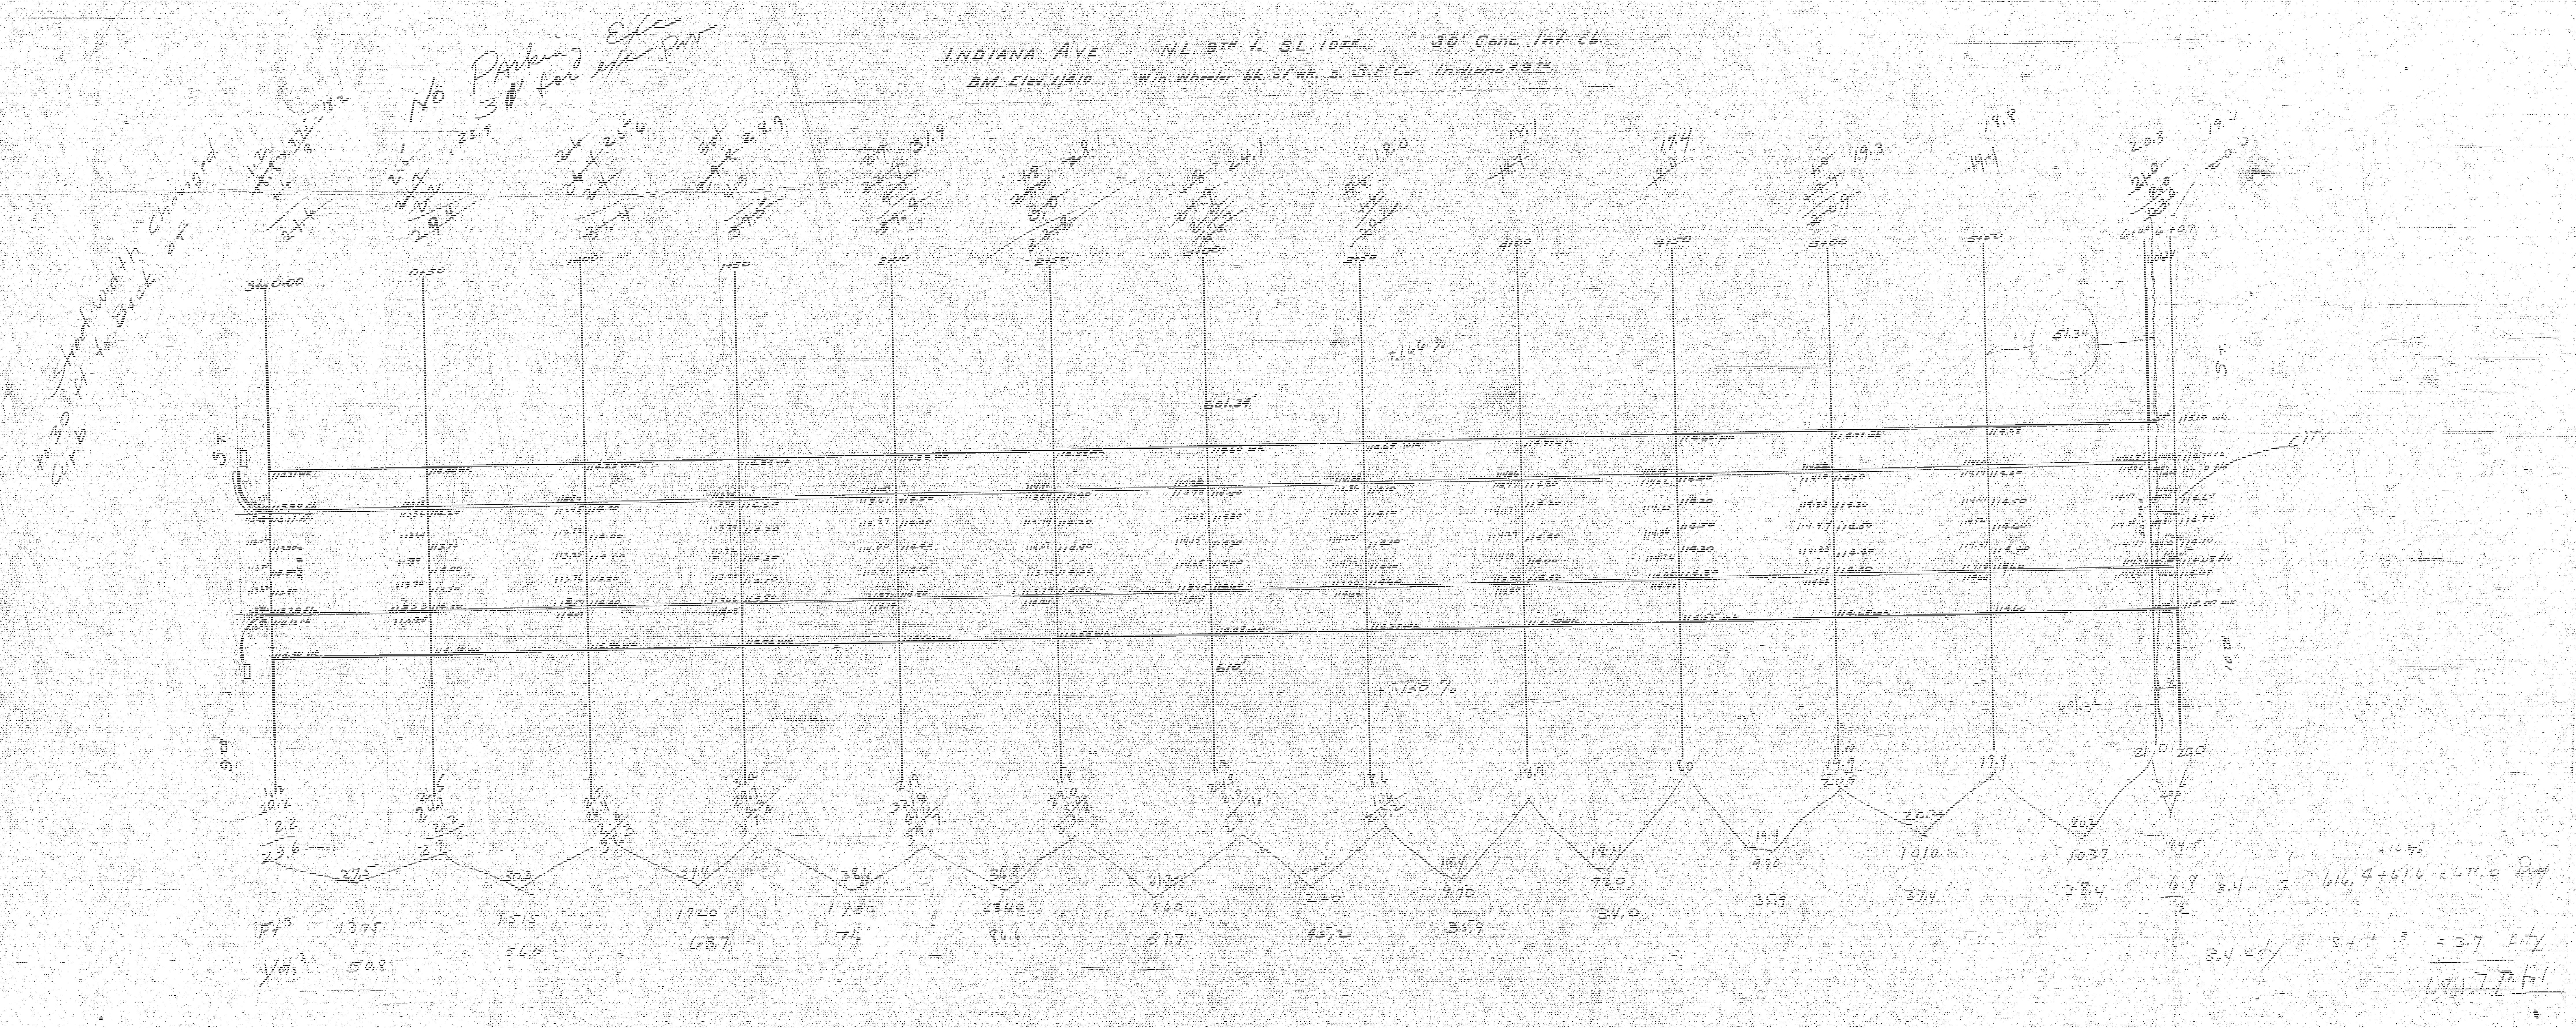
INDIANA AVE NL 9TH to SL 10TH 30' Conc. Int. Cb.
BM. Elev 114.10 Win Wheeler bk. of wk. S. S.E. Cor. Indiana & 9TH
Street width Changed to 30 ft. to Back of Curb
No Parking Ete
3 ft for ete Pav.
Sta 0.00
0+50
1+00
1+50
2+00
2+50
3+00
3+50
4+00
4+50
5+00
5+50
601.34'
610'
51.34
+.166 %
+.150 %
9th St
10th St
Ft³ 1375 1515 1720 1780 2340 1540 1220 970 920 970 1010 1037
Yds³ 50.8 56.0 63.7 71.3 86.6 57.7 45.2 35.9 34.0 35.9 37.4 38.4
616.4 + 67.6 = 684.0 Pav
3.4 cu
3.4 + .3 = 3.7 cu
687.7 Total

PAVING PLAN
INDIANA AVE
NL 9th
to
SL 10th
1940