


M. 185.66 City St. 38' N 3.4' W of N.E. of Center of West 1/2 of Edgemoor
M. 192.27 City St. Woodlawn Central, 56' N 1.44' W of E of both
M. 192.37 City St. Woodlawn 9th, 30.5' N 51.2' W of E of both
M. 195.97 S. end of S.E. curb road, Cor. of Jacqueline & Grace Lane

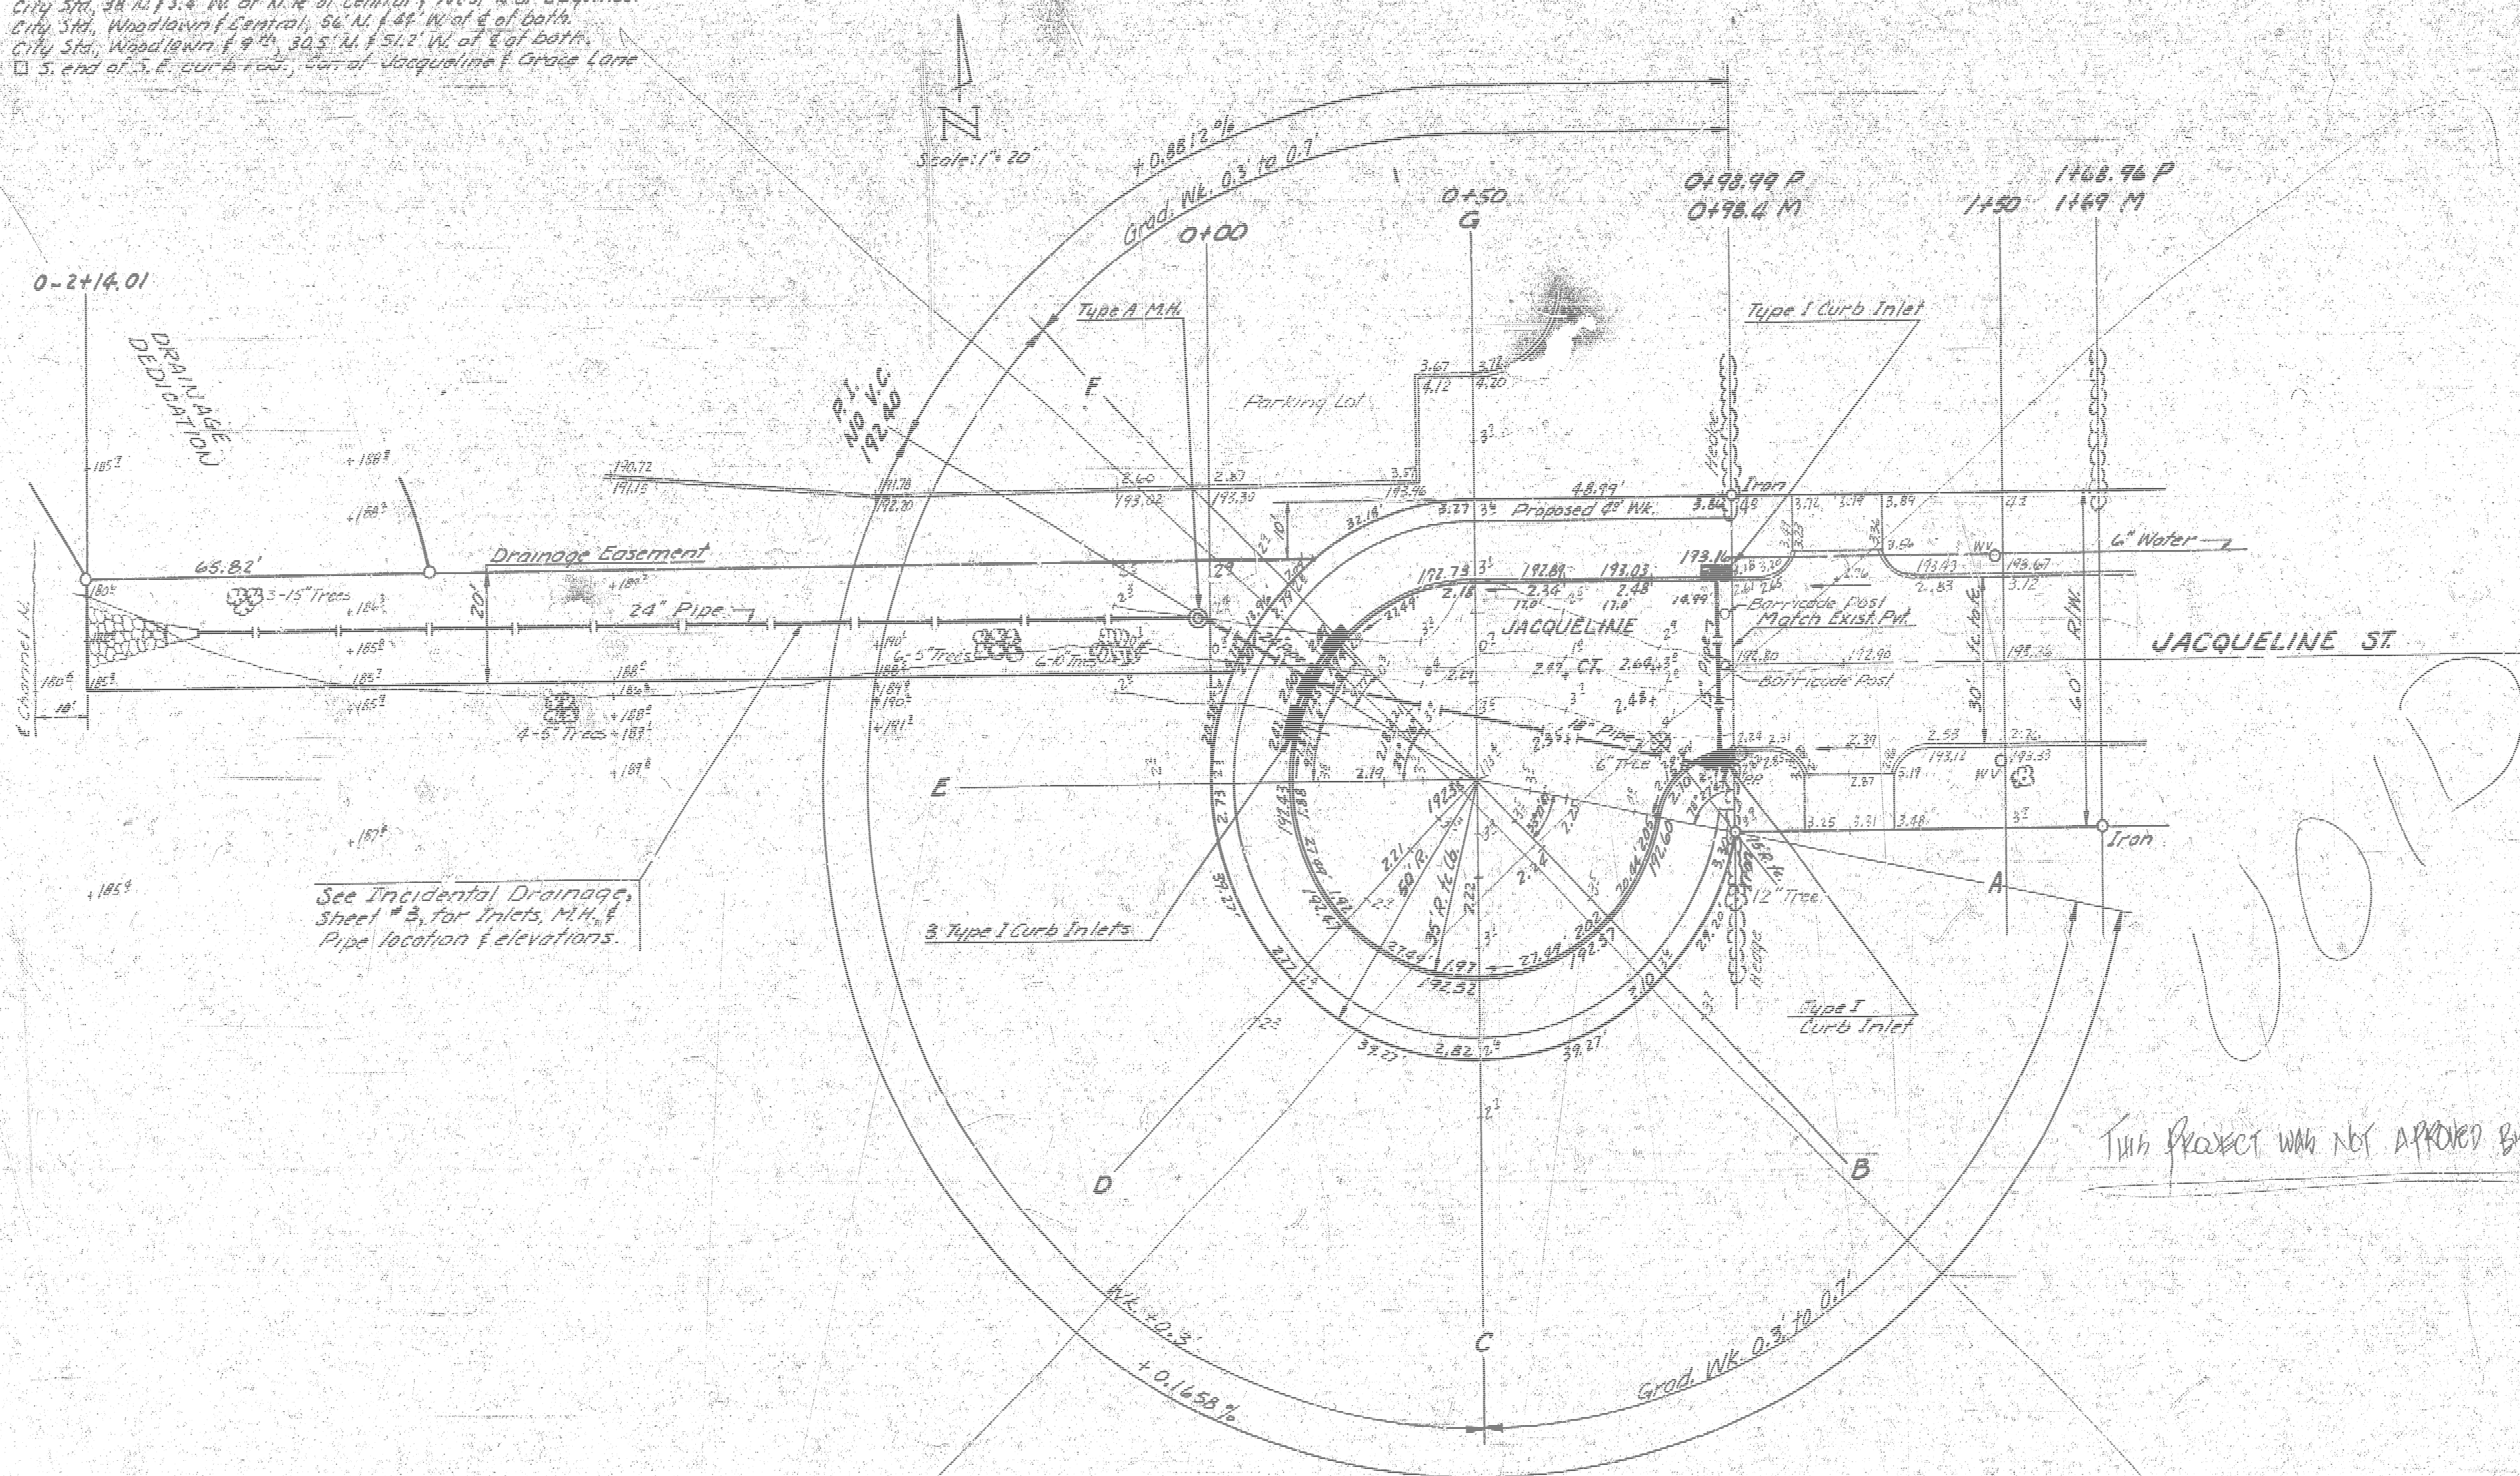

See Incidental Drainage,
Sheet # 5, for Inlets, M.H., &
Pipe location & elevations.

Note: Paving Contractor & Sewer
Contractor to coordinate work efforts
on this project.


EARTHWORK
Excavation
240.7 C.Y.
+10% 24.1
Total 319.8 C.Y.

Manipulation = 546.4 S.Y.


NOTE: Trees to be removed are marked thus except
that any tree marked for removal which in the opinion
of the Engineer can be saved, shall be spared.

NOTE TO FIELD ENGINEER & CONTRACTOR
Grade paving and clear right-of-way for pro-
posed sidewalk. Compact fill in sidewalk area.
TO BE CONSTRUCTED BY "OTHERS".

SUB-GRADE
TYPE OF SUB-GRADE TREATMENT SHALL BE DE-
TERMINED BY THE FIELD ENGINEER. SUB-GRADE
TREATMENT MAY CONSIST OF LIMF TREATMENT,
CEMENT TREATMENT, SUB-GRADE MODIFICA-
TION, OR ANY COMBINATION OF THESE.

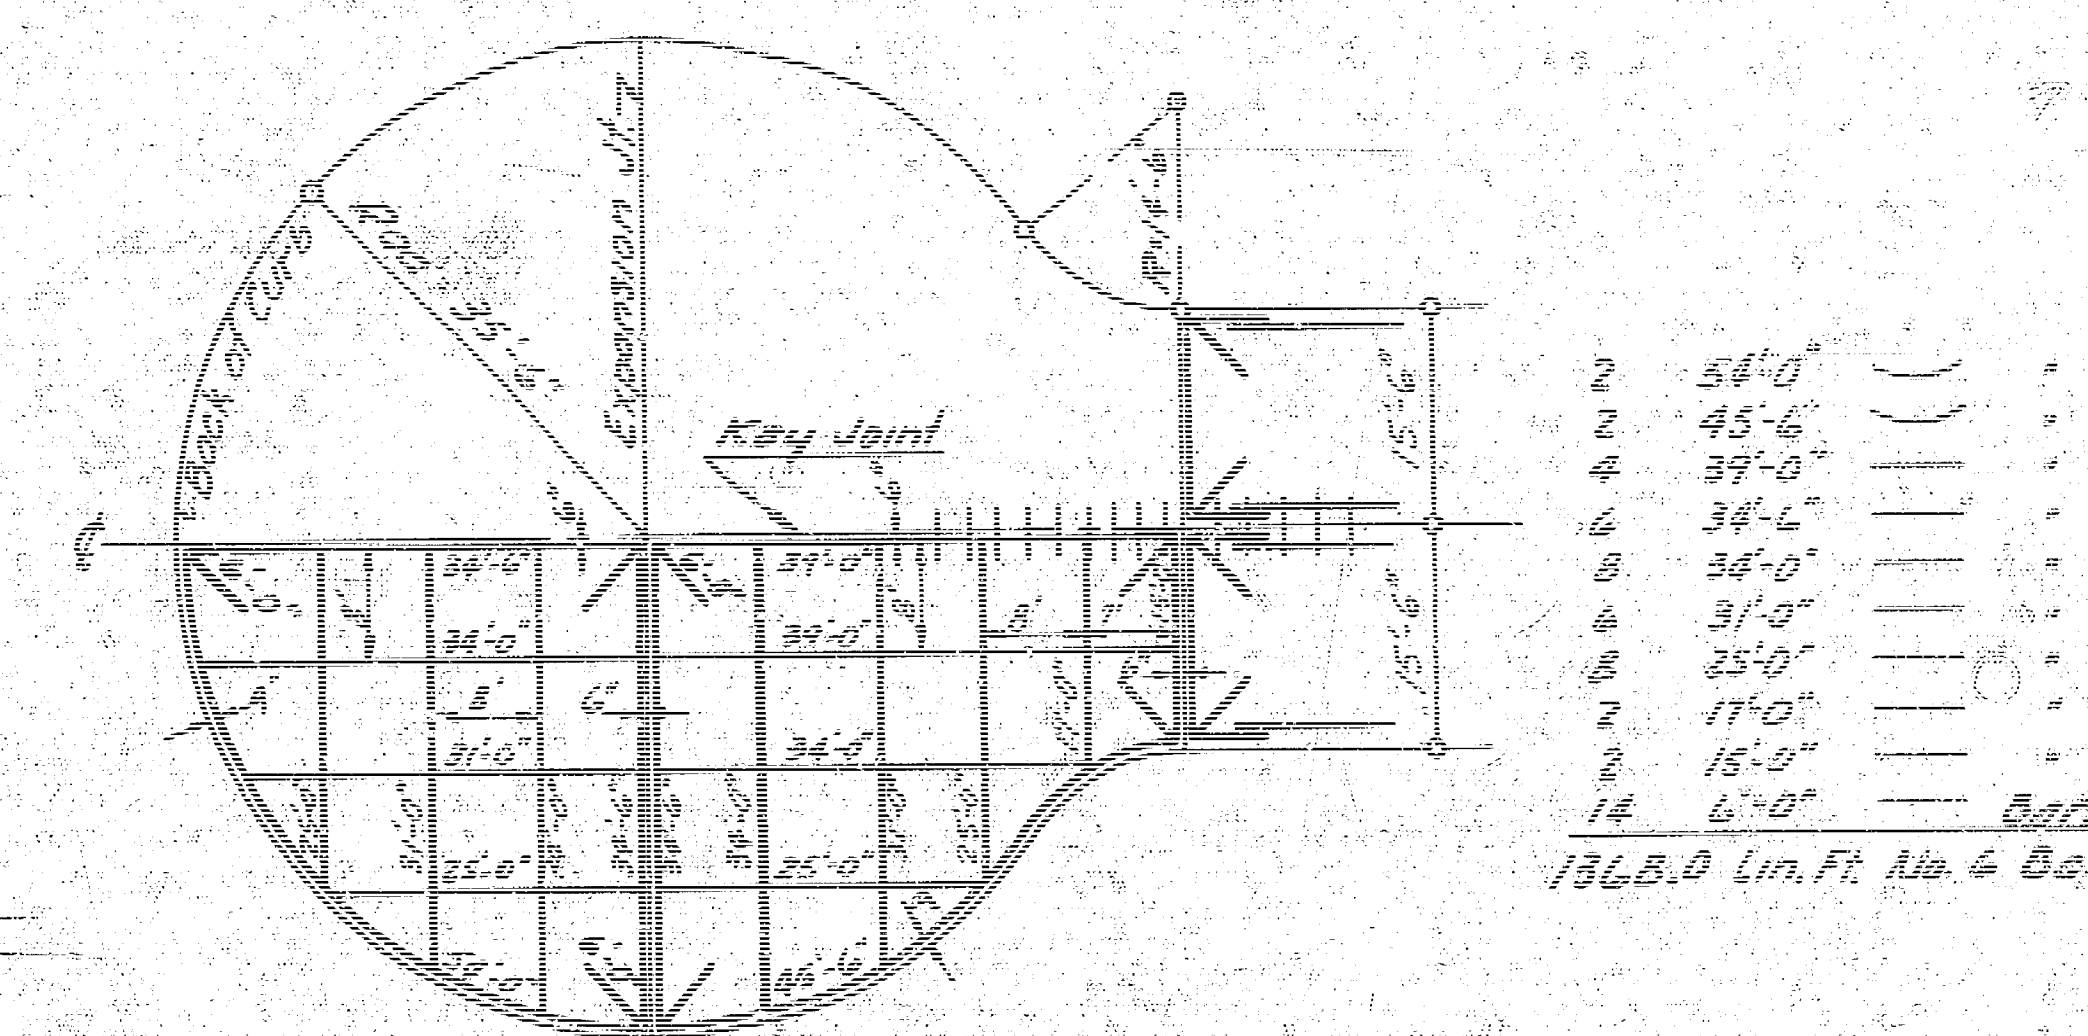


**CONCRETE CUL-DE-SAC
STEEL PATTERN**
No Scale

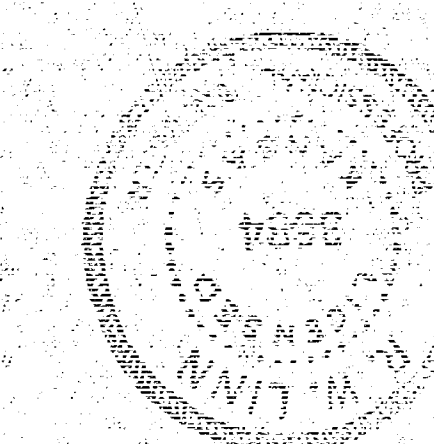

1/2



**JACQUELINE COURT
FROM E.L. EDGEMOOR PARK
BRANCH LIBRARY ADD^d TO
INCLUDING CUL-DE-SAC
6" CONC. / INT. CURB**
CITY OF WICHITA, KANSAS
RW LINN CITY ENGINEER
DATE 6/77 PROJ. NO. DAKS 575073

0+00 46.85' 0+50

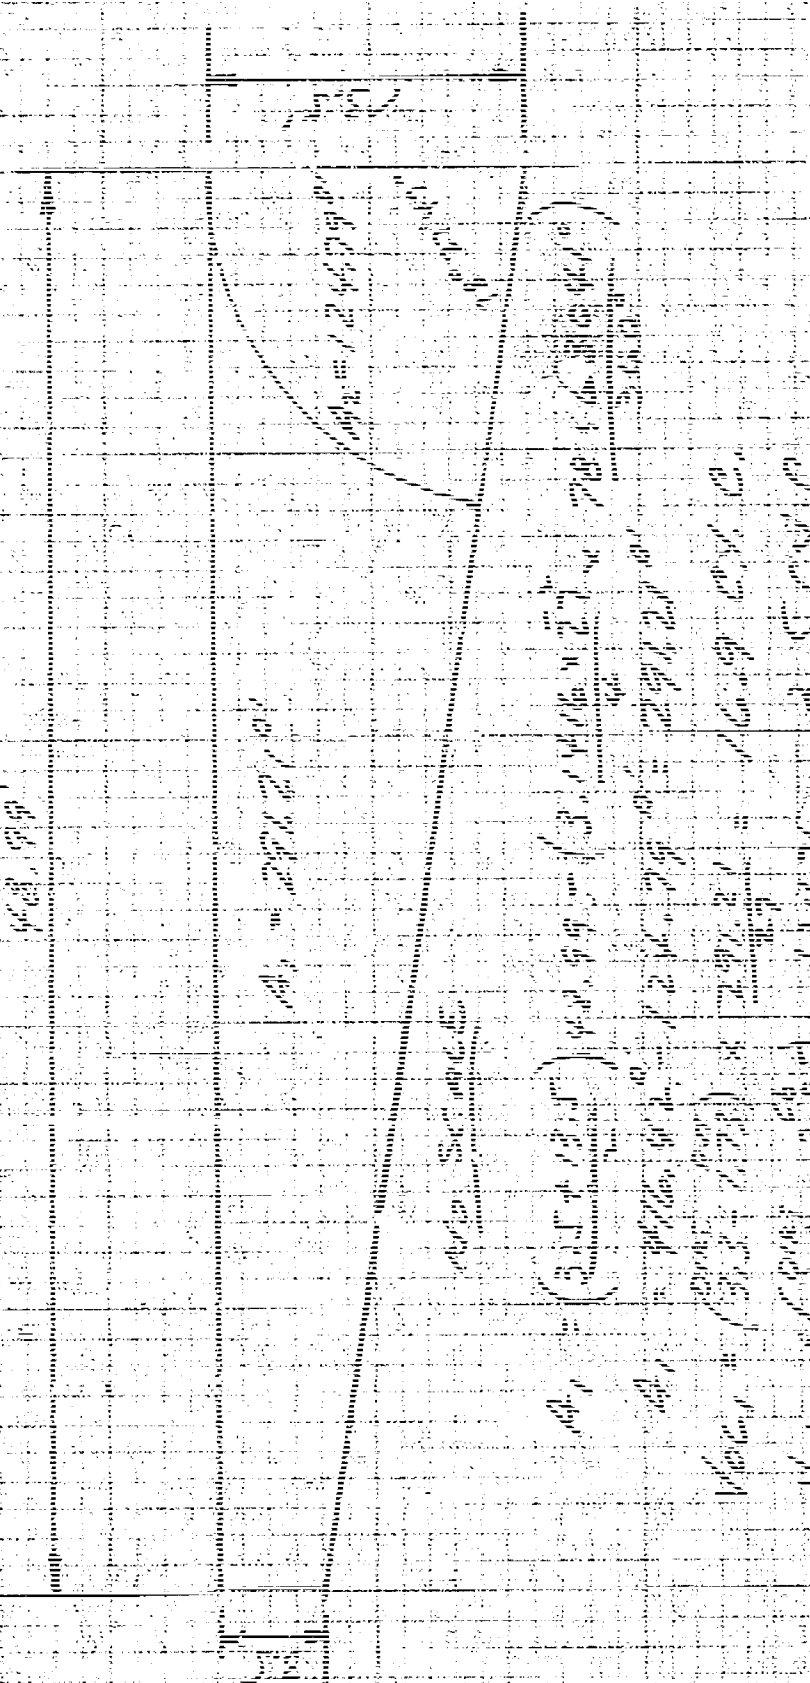

 $163.33 \times 2.44 = 397.20 \text{ sq. ft.}$

B.M. 185.66 City 5th, 38 N. 1/2 W. of N.B. of Central / West R. of Eggertson
 B.M. 192.27 City 5th, Woodlawn / Central, 54 N. 1/4 W. of E. 6th.
 B.M. 192.37 City 5th, Woodlawn / 9th, 30.5 N. 1/2 W. of E. 6th.
 B.M. 195.97 Δ So. end of S.E. curb road, Cor. of Jacqueline / Grace Lane

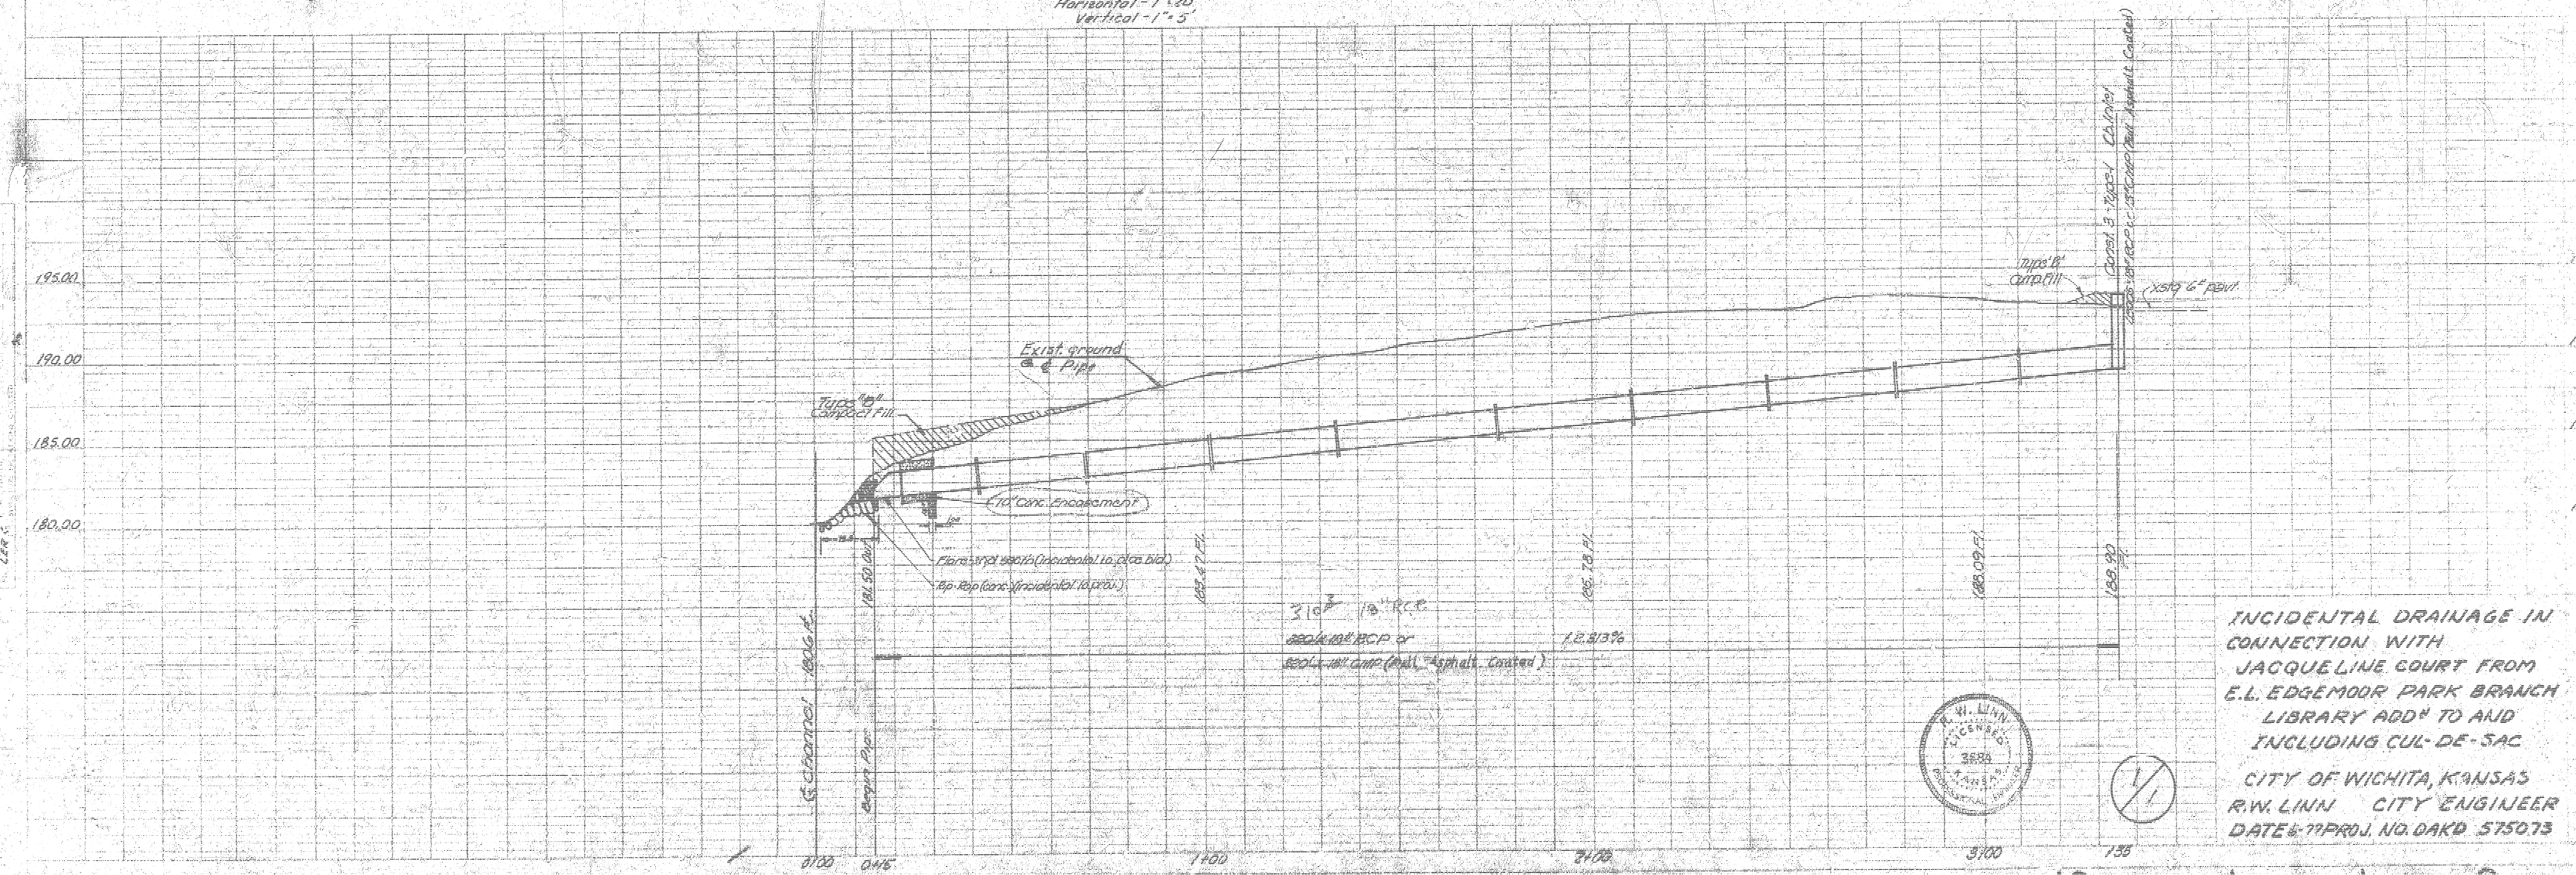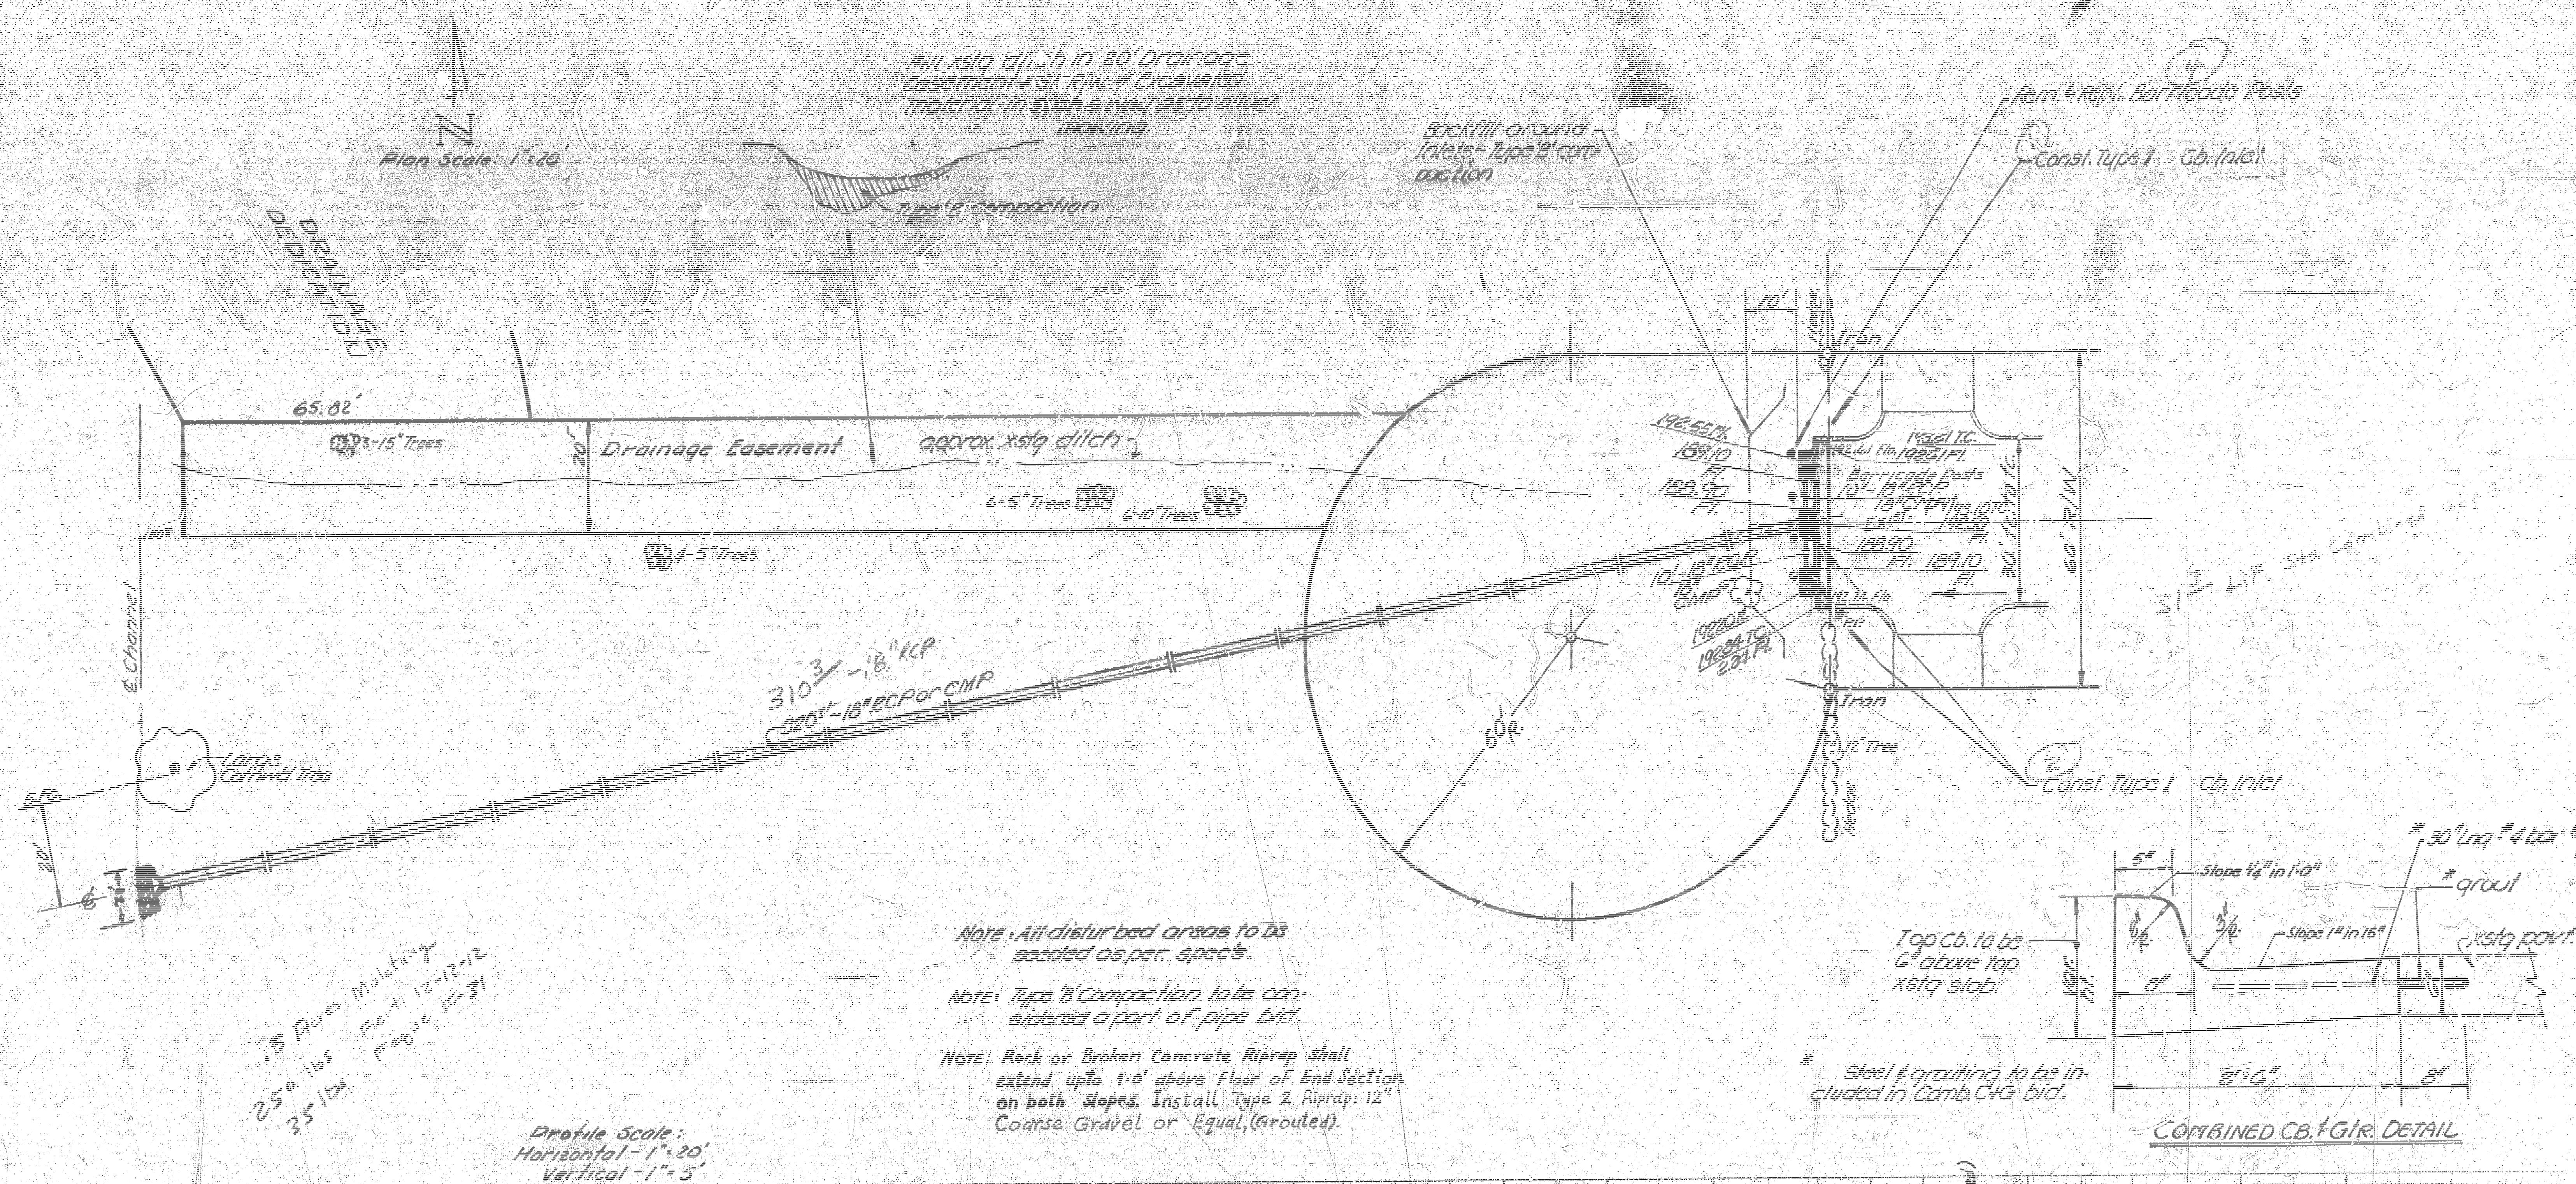

INCIDENTAL DRAINAGE IN
CONNECTION WITH
JACQUELINE COURT FROM
LIBRARY ADDⁿ TO AND
INCLUDING CUL-DE-SAC
CITY OF WICHITA, KANSAS
R.W. LINN CITY ENGINEER
DATE 4-27-PROJ. NO. DAKD 575073