

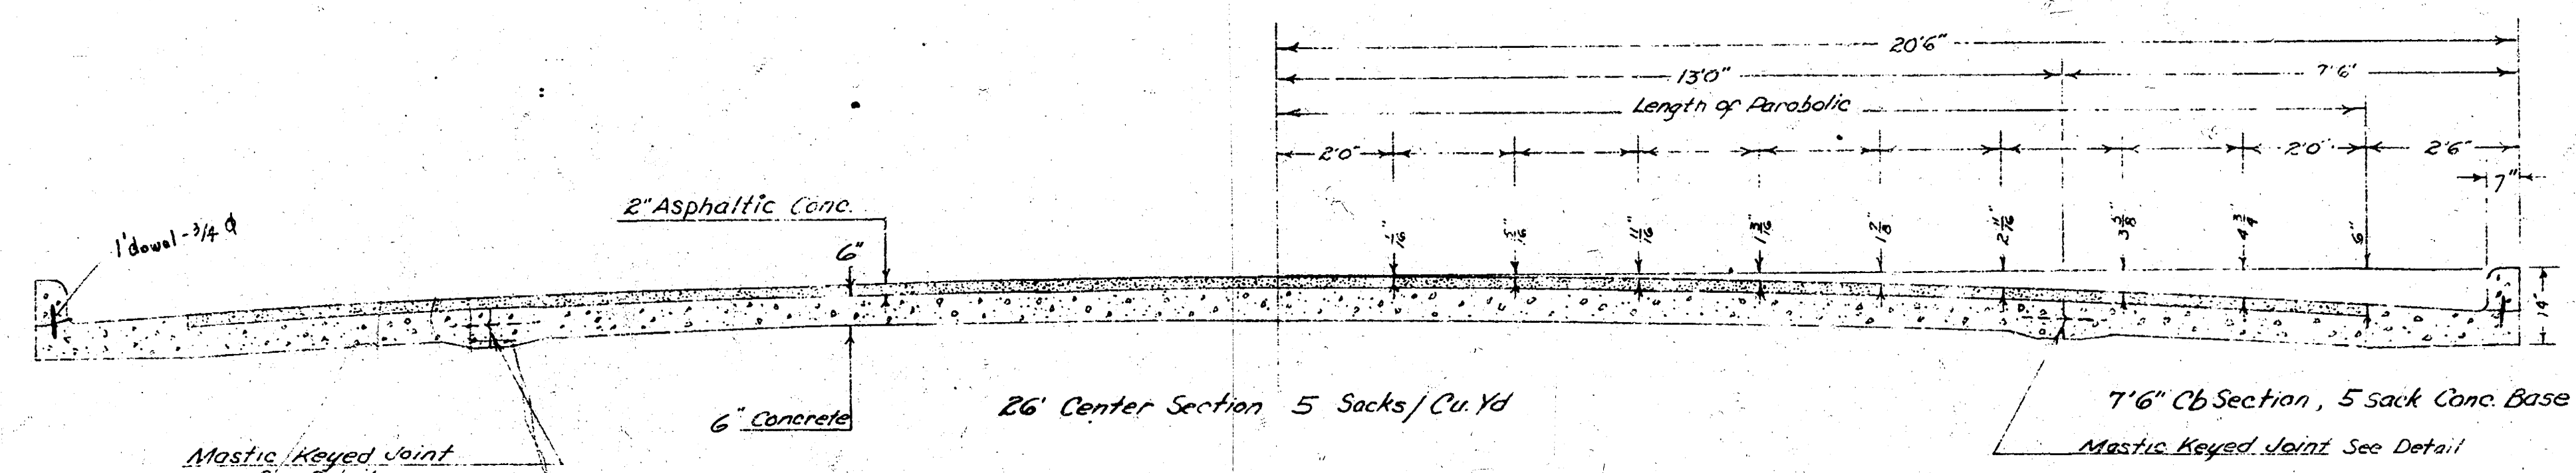


KANSAS
SL NORTHERN TO NL INDUSTRIAL

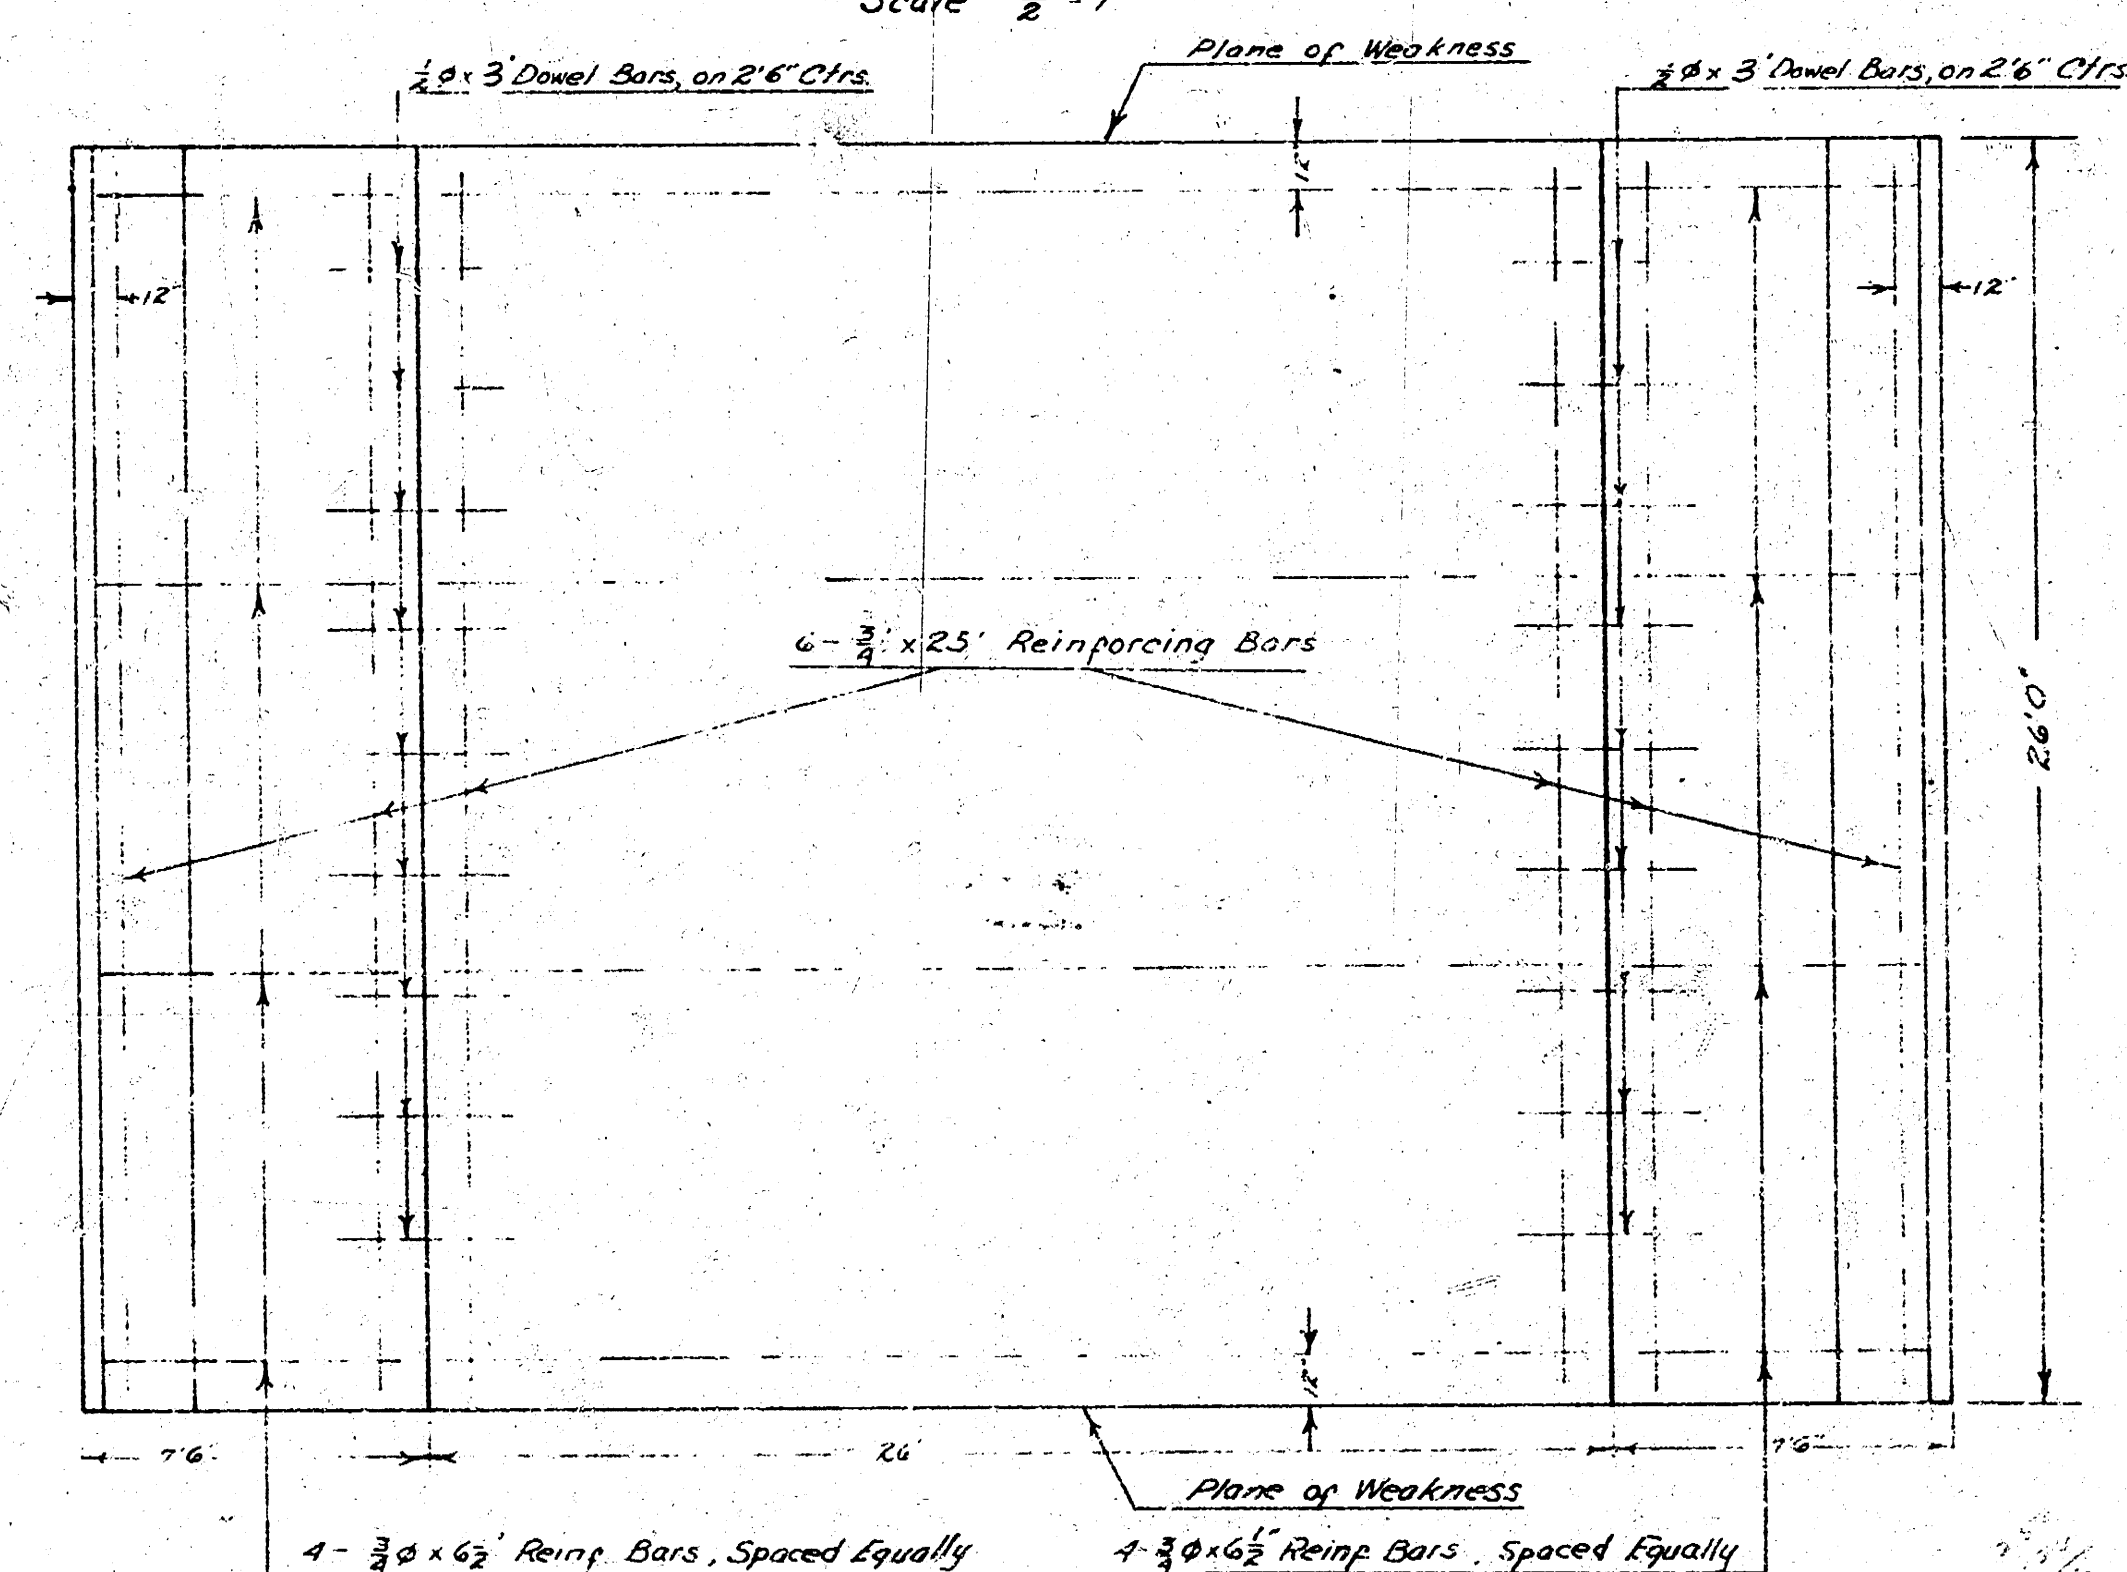


TYPICAL SECTION

Scale 1/2" = 1'

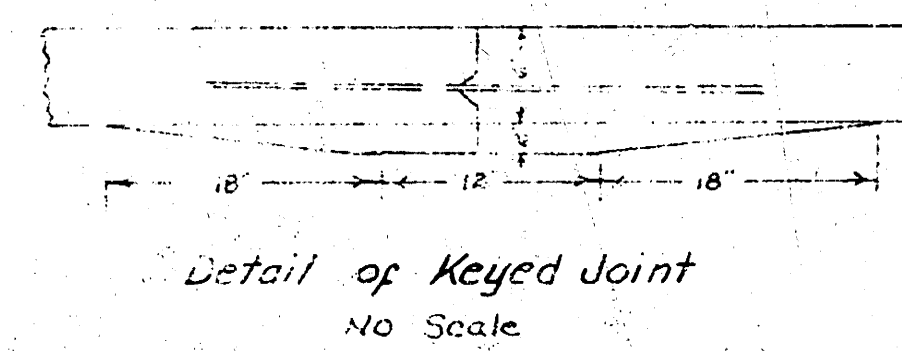



STEEL PATTERN

Scale 1" = 1'

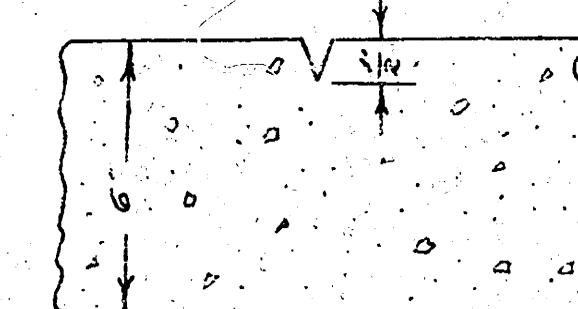


B.M. 95.43- HYDRAULIC NORTHERN 60" SINK L.S. PAUL S.E. CO.
B.M. 95.43- 12" IN RITCHIE S. END C. RETAIN KANSAS @ NORTHERN.

NOTE BASE LINE IS 6 KANSAS.

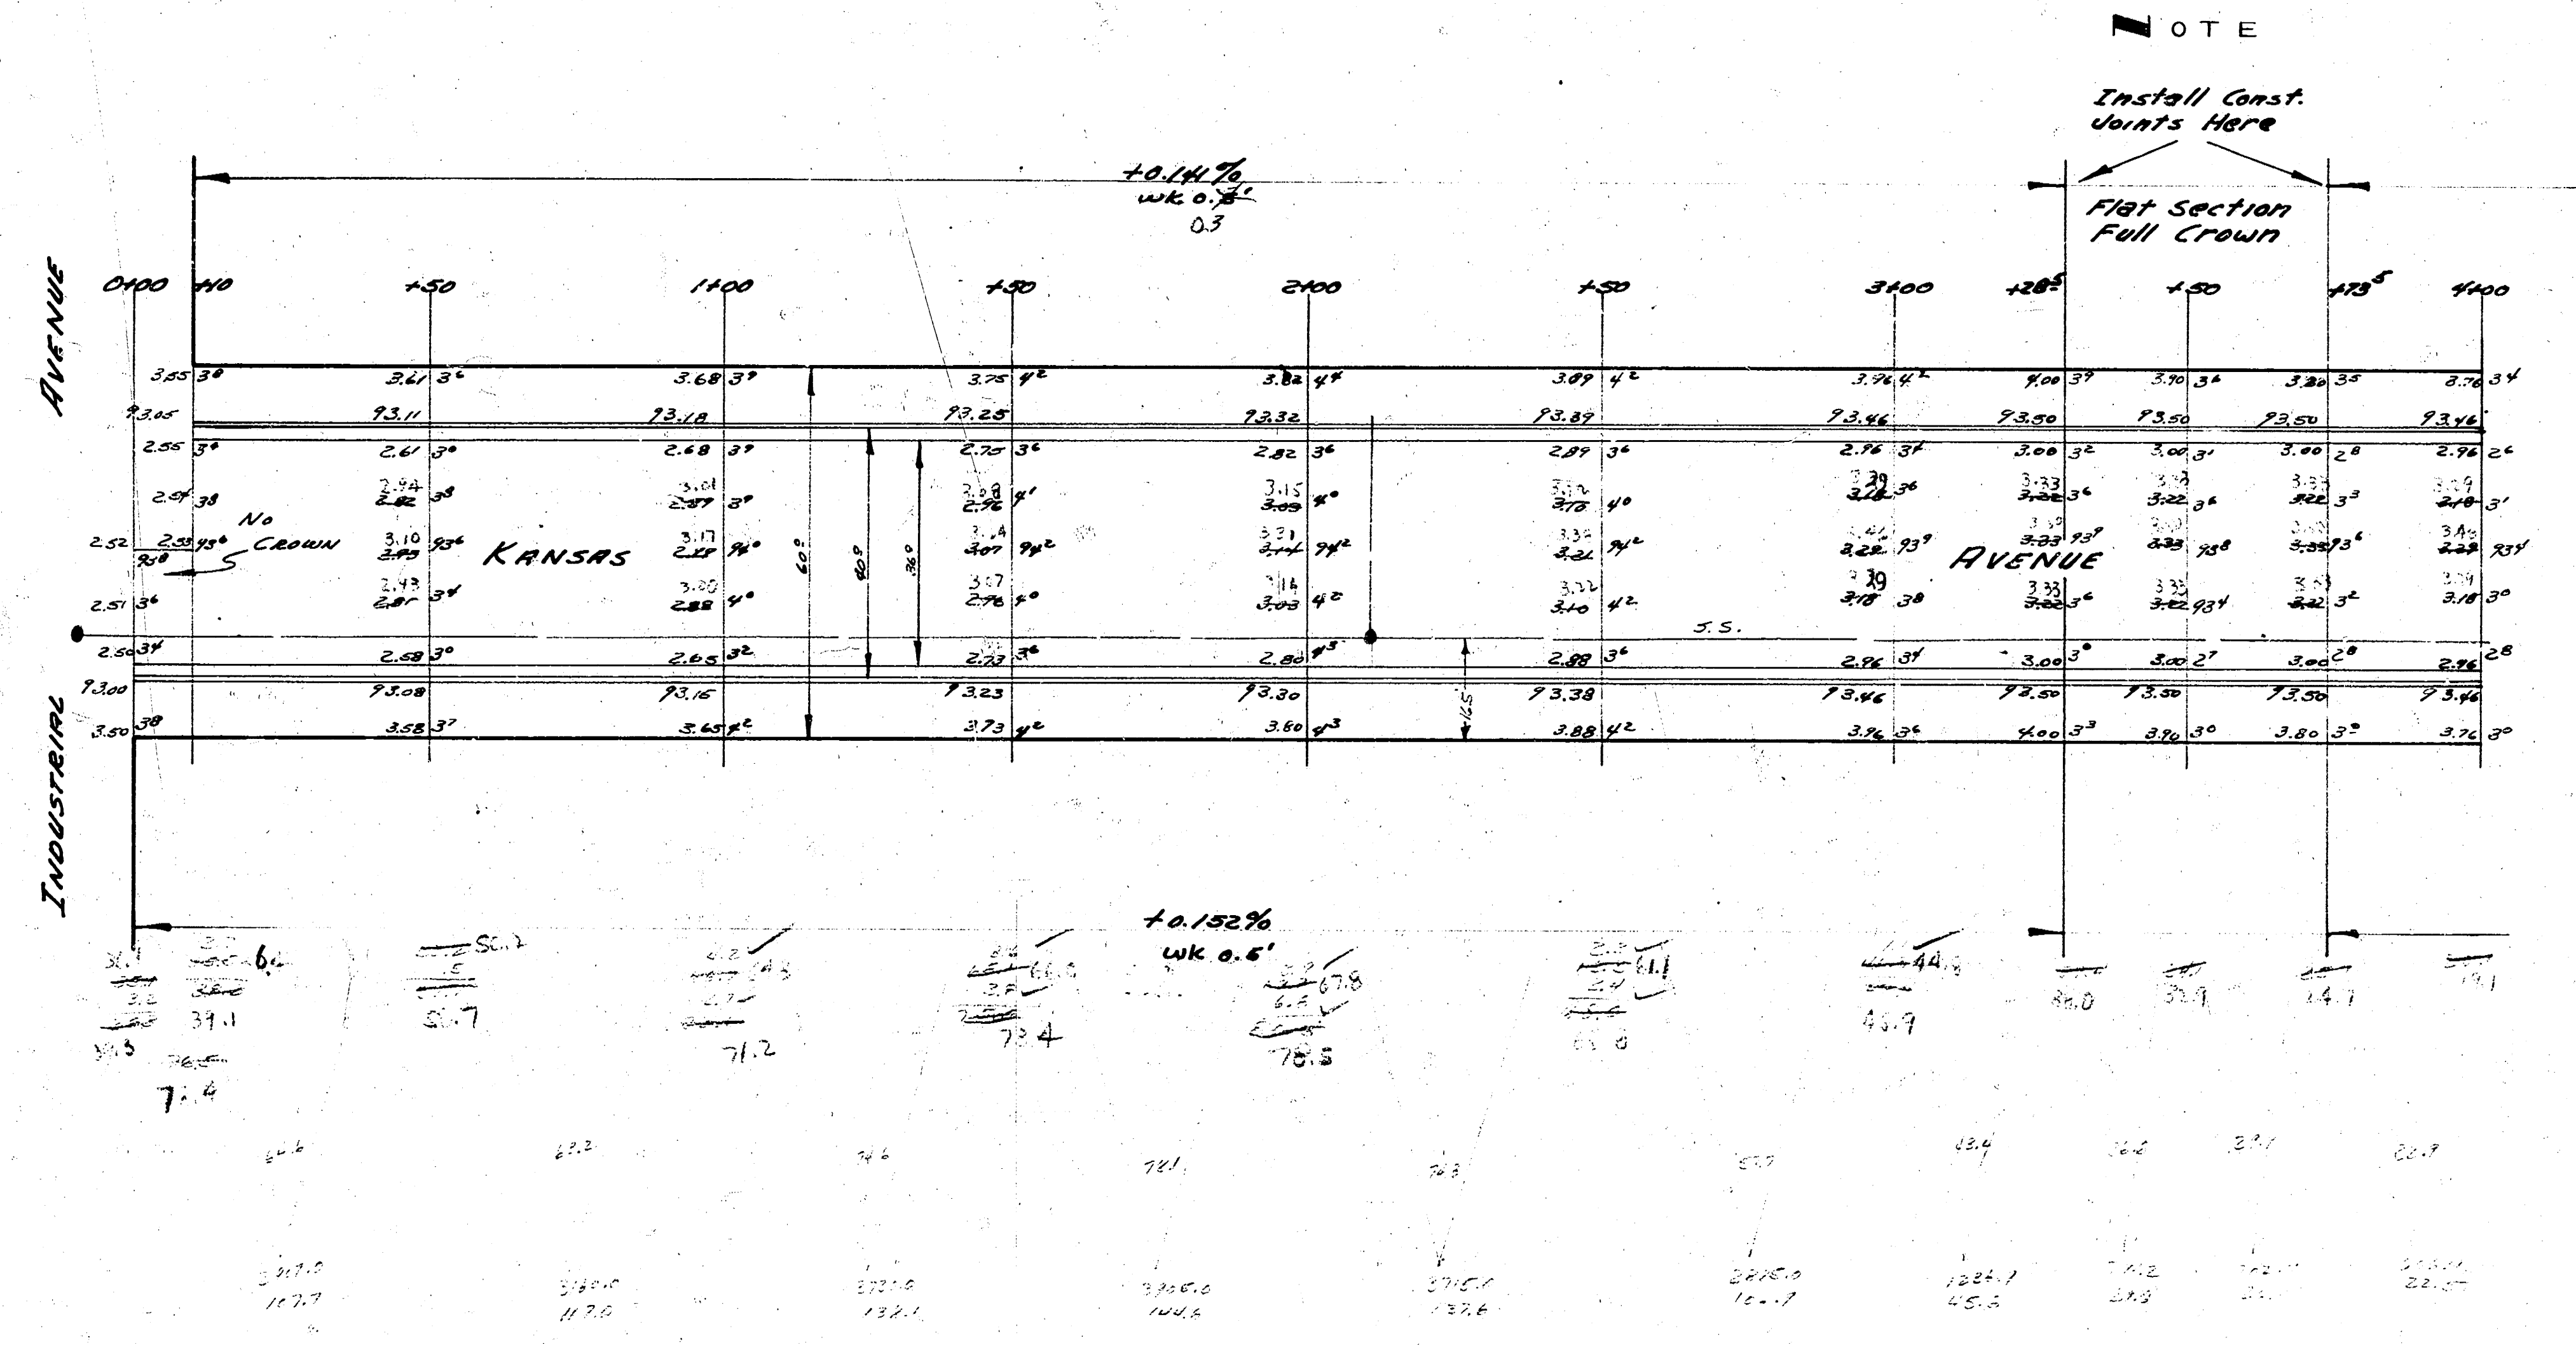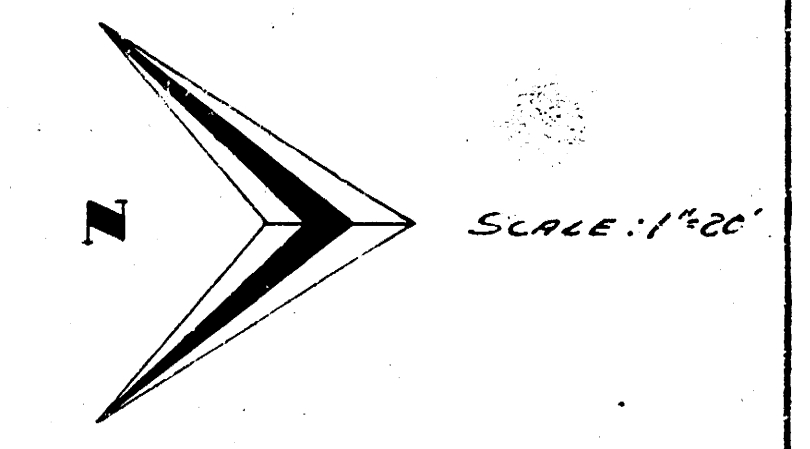

1/2

KANSAS
S.G. NORTHERN TO N.L. INDUSTRIAL
36-2-40 A.C.
CITY OF WICHITA, KANSAS
L.K. WHITE CITY ENGINEER
August 1952 Prod. No. C12-117

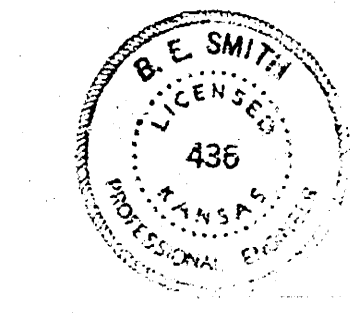

B.M. 12 1/2" R" IN RITCHIE S. END E. RETURN KANSAS / NORTHERN

NOTE: Base Line is @ KANSAS

