


INT. INCLUDED
ON 22ND ST
22ND

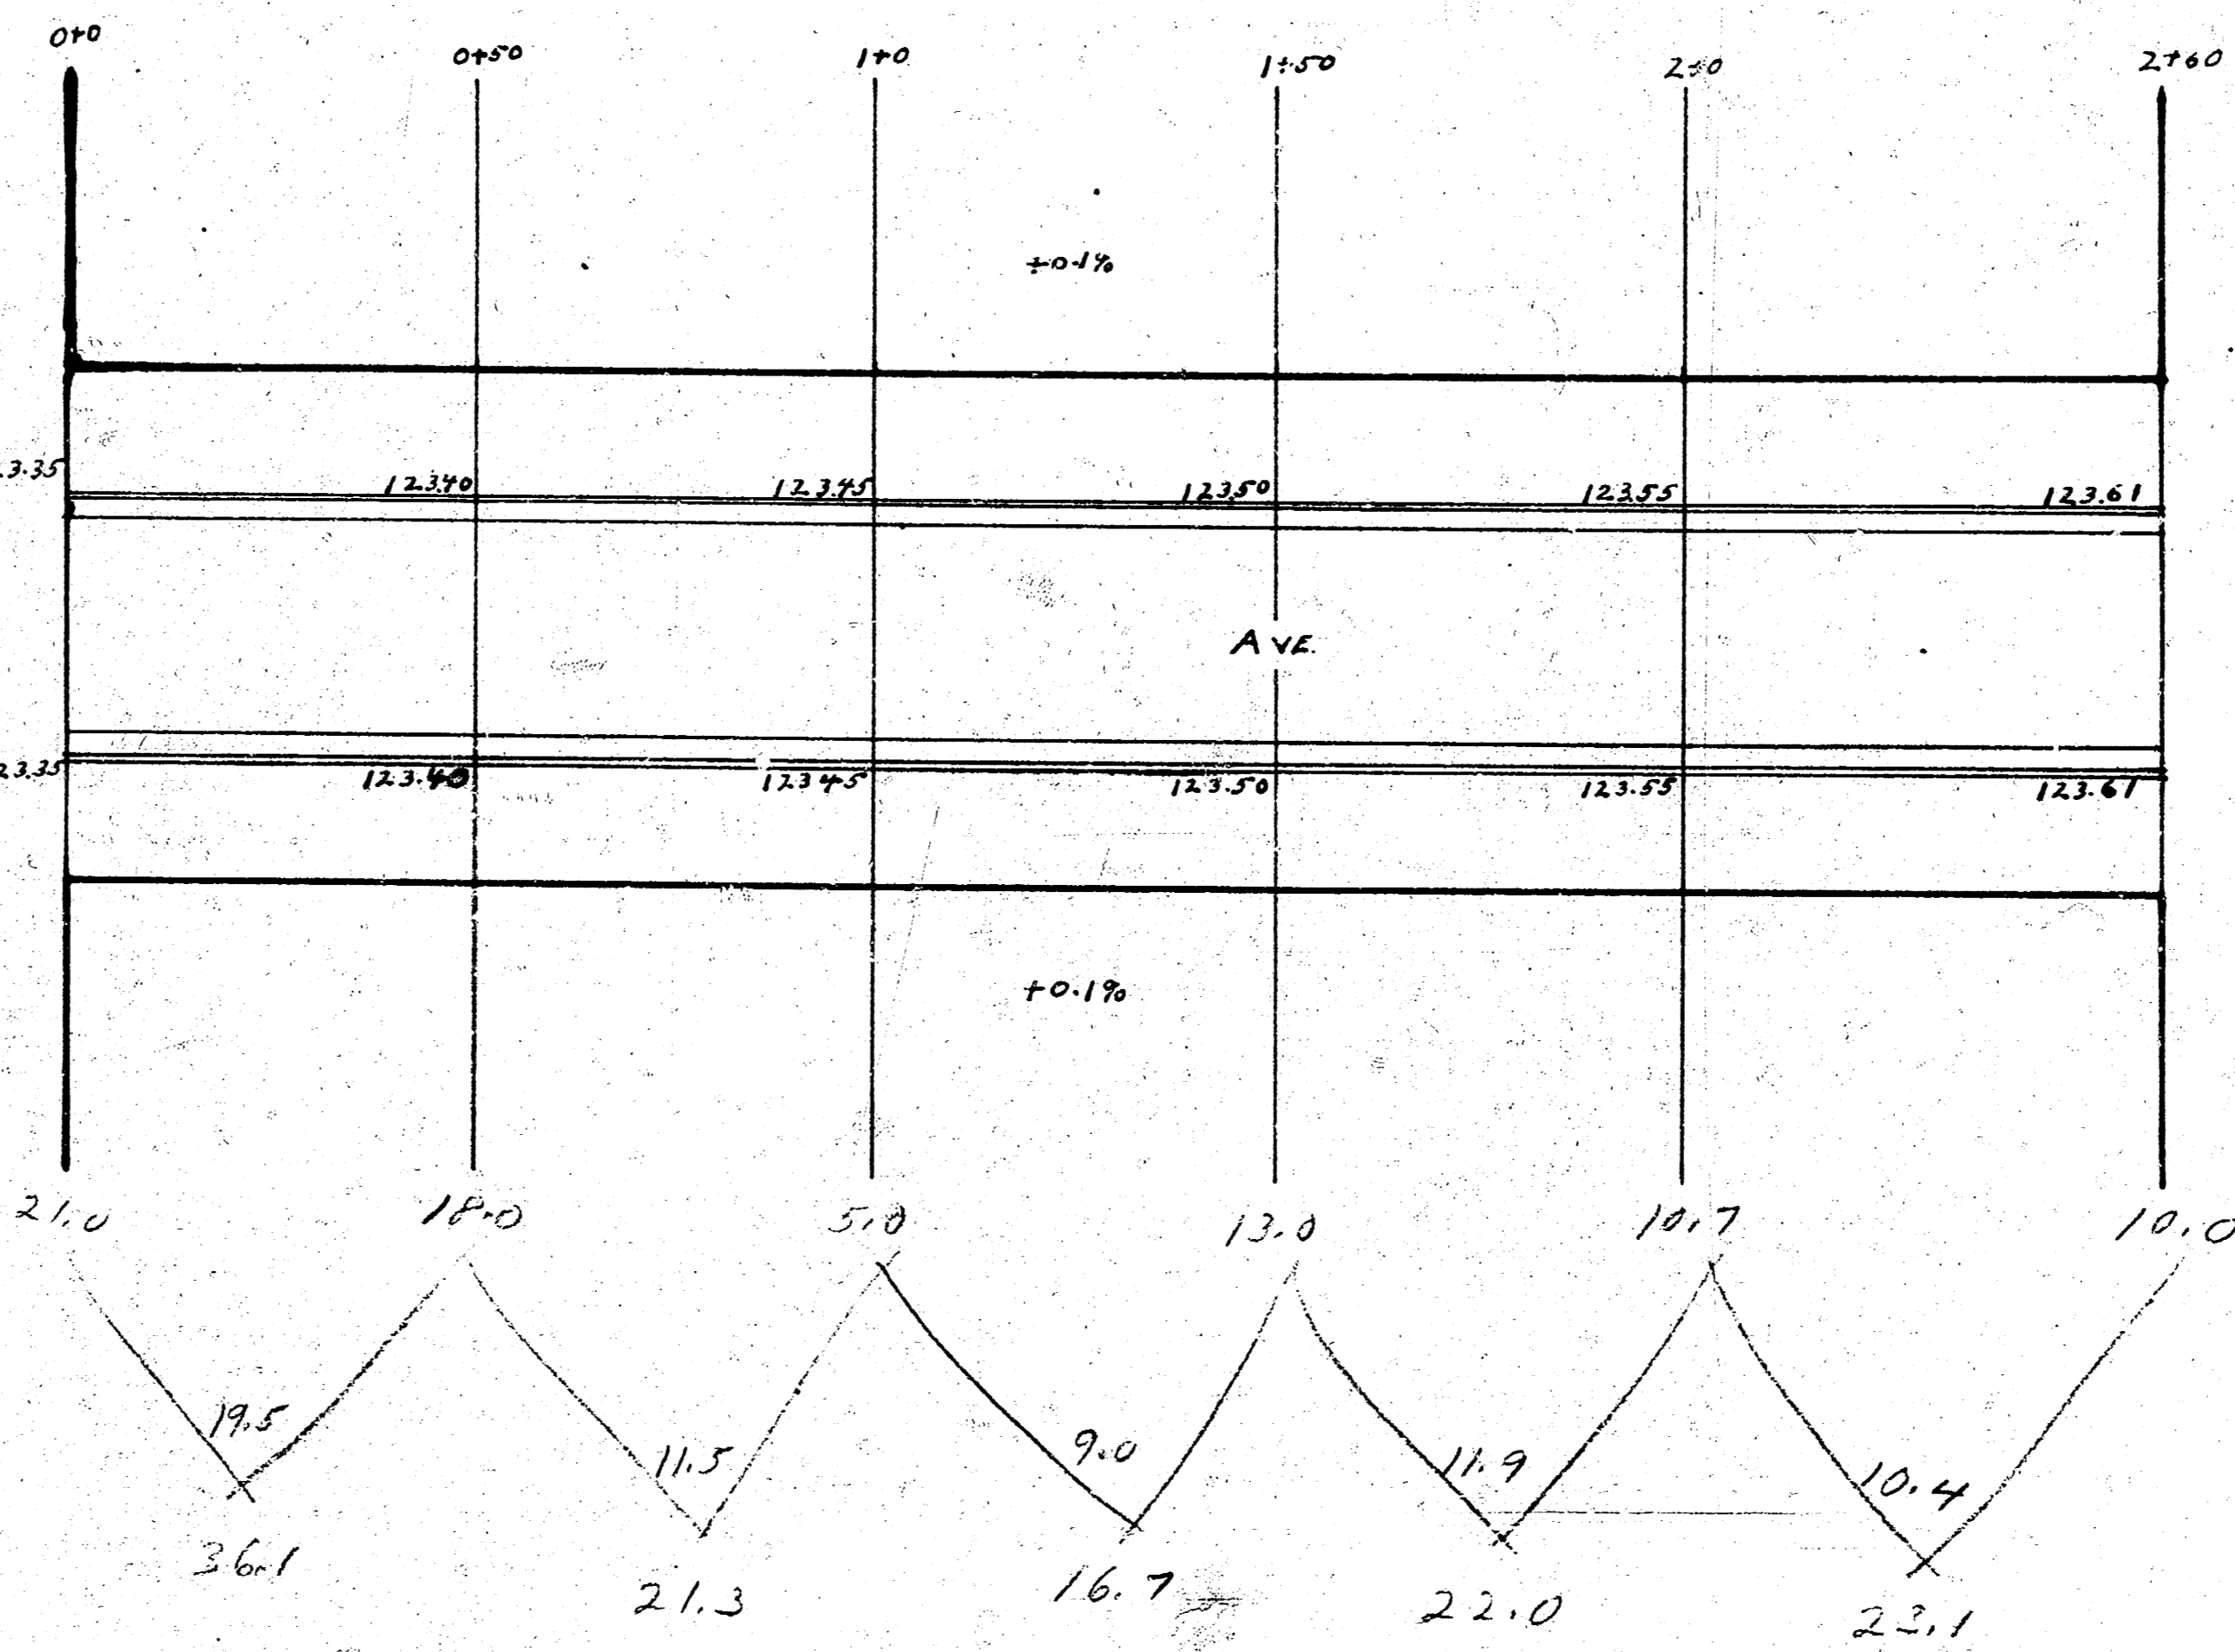

prop
47.2
51.9
61.1
36.1
21.3
15.7
22.0
23.1
279.4
+10% 27.0
307.4

1475