



BM- 123.43 SE cor conc. porch Ho #1943 N Kansas.
BM- 125.04 SE cor conc. porch Ho #2001 N Kansas.

NOTE: FIELD ENGINEER & CONTRACTOR:-
No record on file of a request for driveway grades.
Do not match drives.

Ties to Iron- & Kansas # 20th
54.15 NW to 'X' cut top W curb approx. 22' N of NL 20th.
54.14 NE to 'X' cut top E curb approx. 22' N of NL 20th.

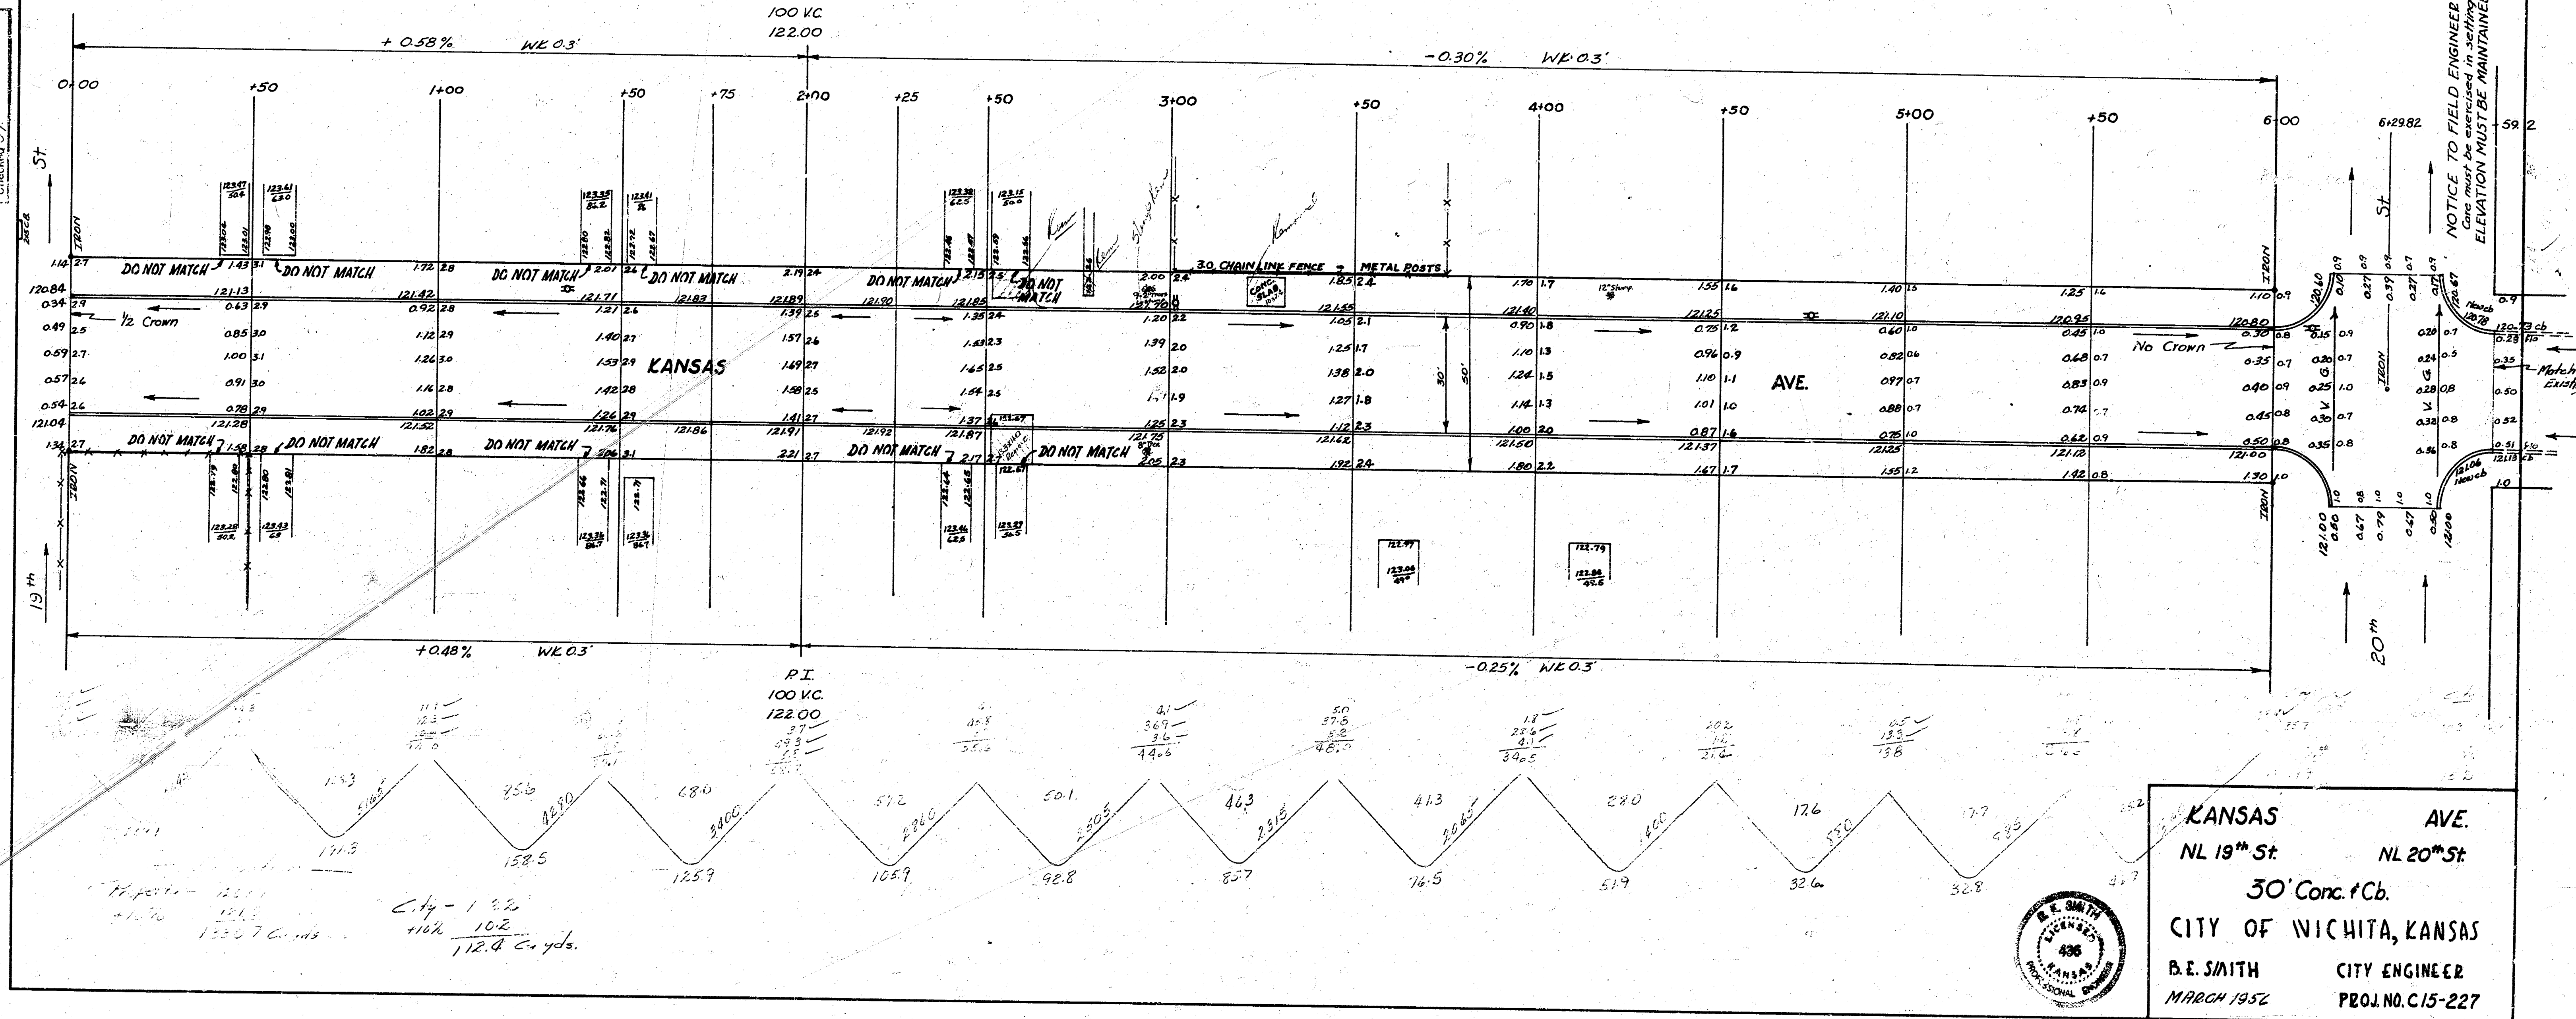

NOTICE TO FIELD ENGINEER & CONTRACTOR:-
One must be exercised in setting this corner. This grade
ELEVATION MUST BE MAINTAINED to get drainage West.

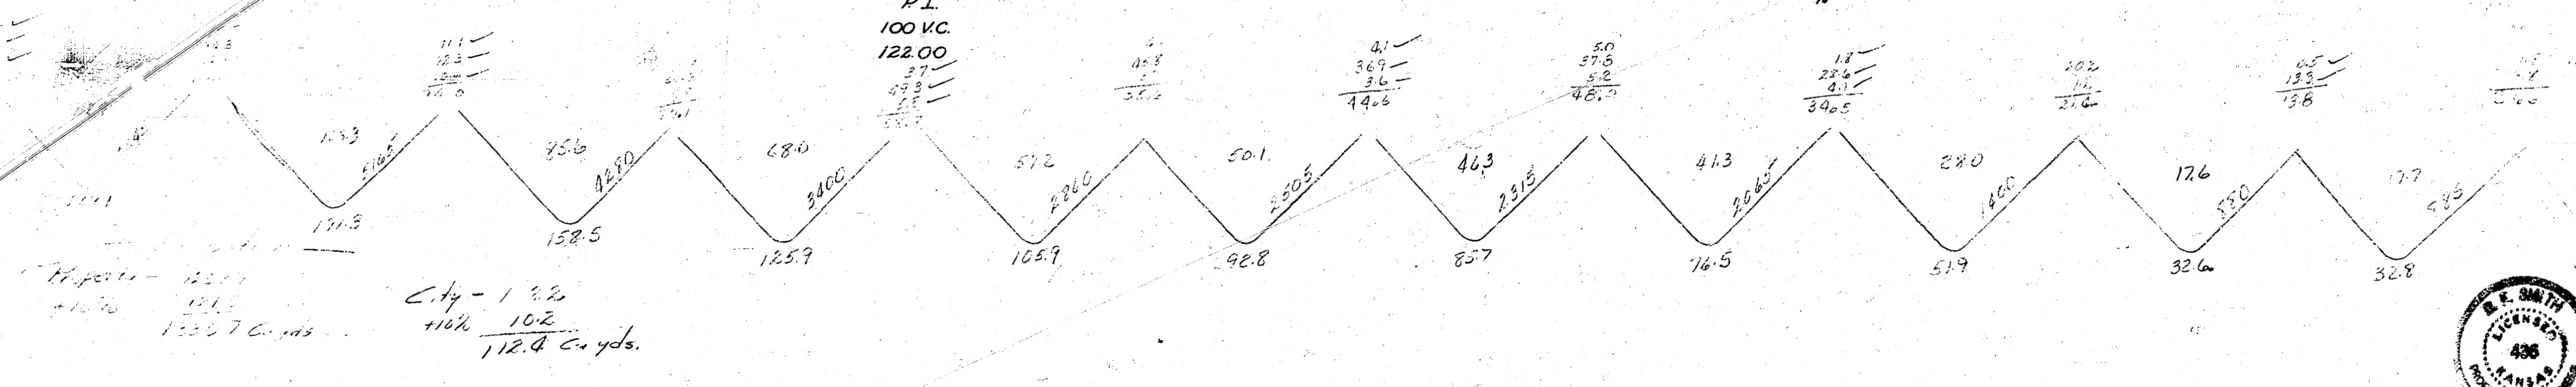

KANSAS AVE.
NL 19th St. NL 20th St.
30' Conc. 1 Cb.
CITY OF WICHITA, KANSAS
B.E. SMITH CITY ENGINEER
MARCH 1952 PROJ. NO. C15-227

