


Orme St. - W.L. Water to W.L. Wichita

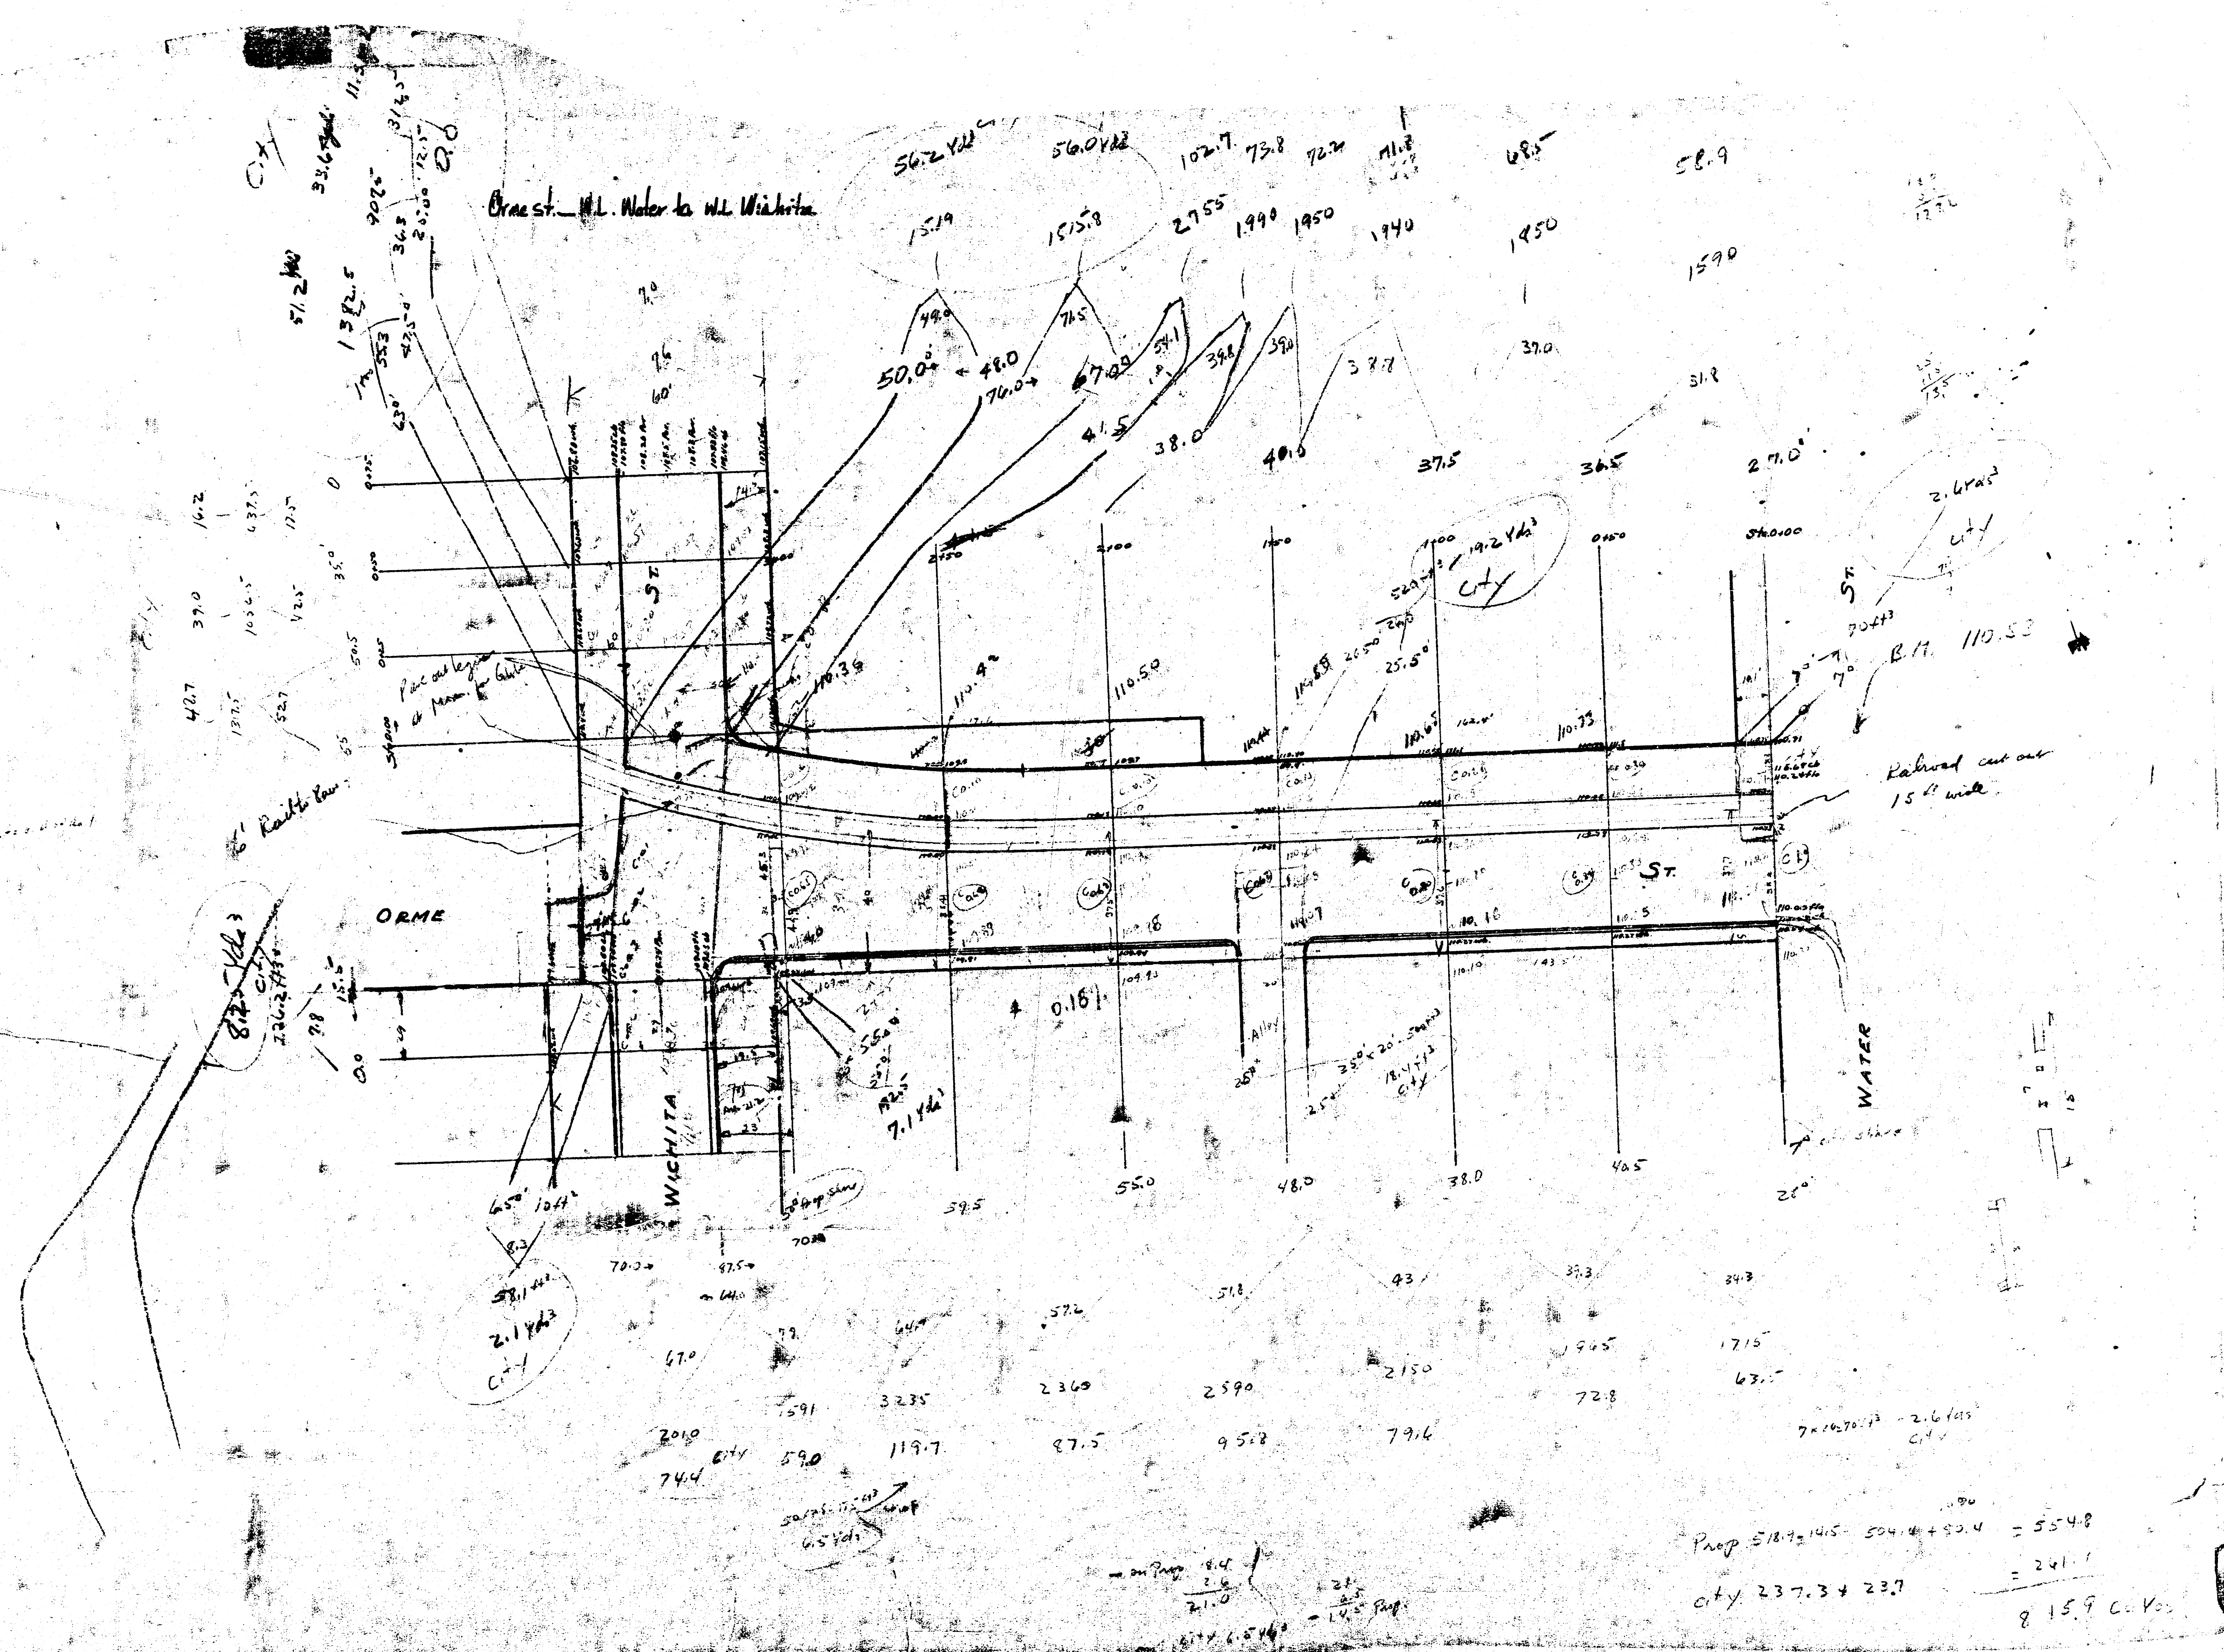

$$\begin{aligned}
 &= 21.0 \text{ Prop. } 8.4 \\
 &= 14.5 \text{ Prop. } 2.1
 \end{aligned}$$

$$\begin{aligned}
 \text{Prop. } 518.9 - 1415 - 504.4 + 52.4 &= 554.8 \\
 \text{City } 237.3 + 23.7 &= 261.0 \\
 &= 815.9 \text{ C.V.}
 \end{aligned}$$