


Orme St. - E.L. Greenwood to W.L. Hydraulic


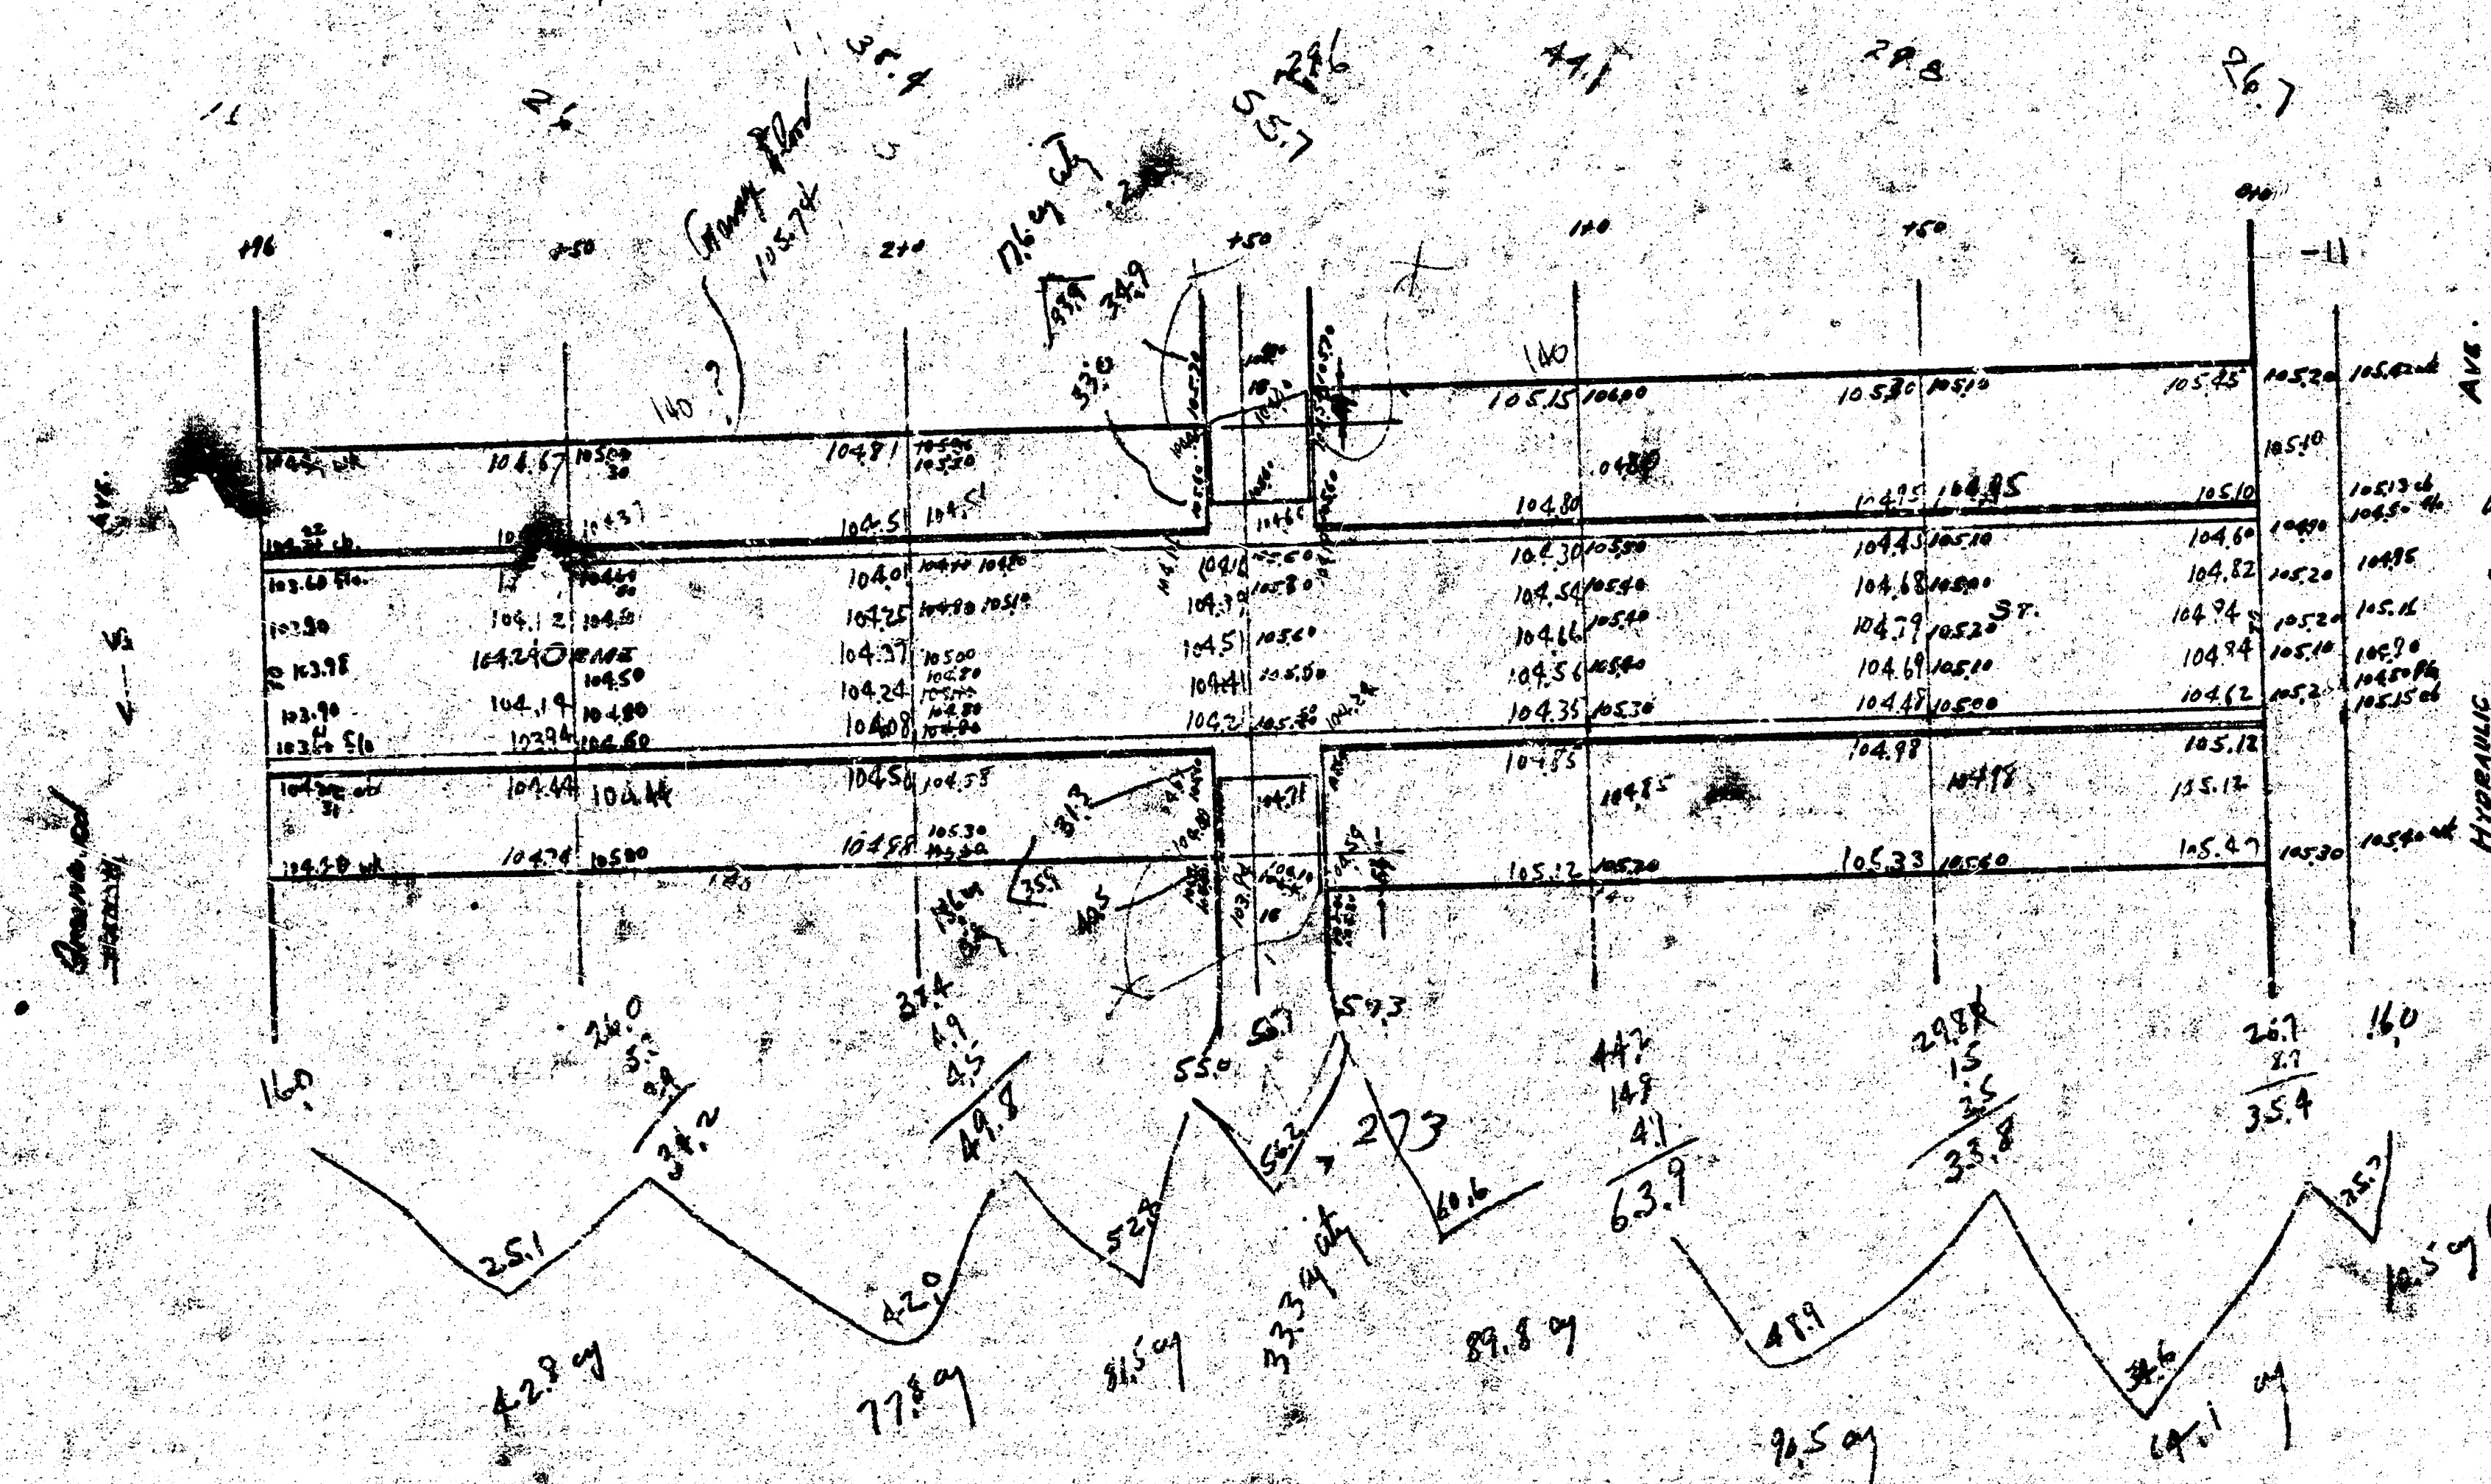

$$\begin{array}{r} \text{Comp} = 440.5 \\ + 107 = \underline{44.6} \\ \hline 491.1 \end{array}$$

$$\begin{array}{r} 80.0 \\ 8 \overline{) 640} \\ \underline{640} \\ 0 \end{array}$$