


B.M. Elev. 106.09 N in Summit chg of rd. S.W. Cor
 107.42 E. end of rd. S.E. Estelle + Orme

Orme St. - E.L. Estelle to W.L. Valutisa

26 - 2 - 30 Concrete

Final figures for excavation

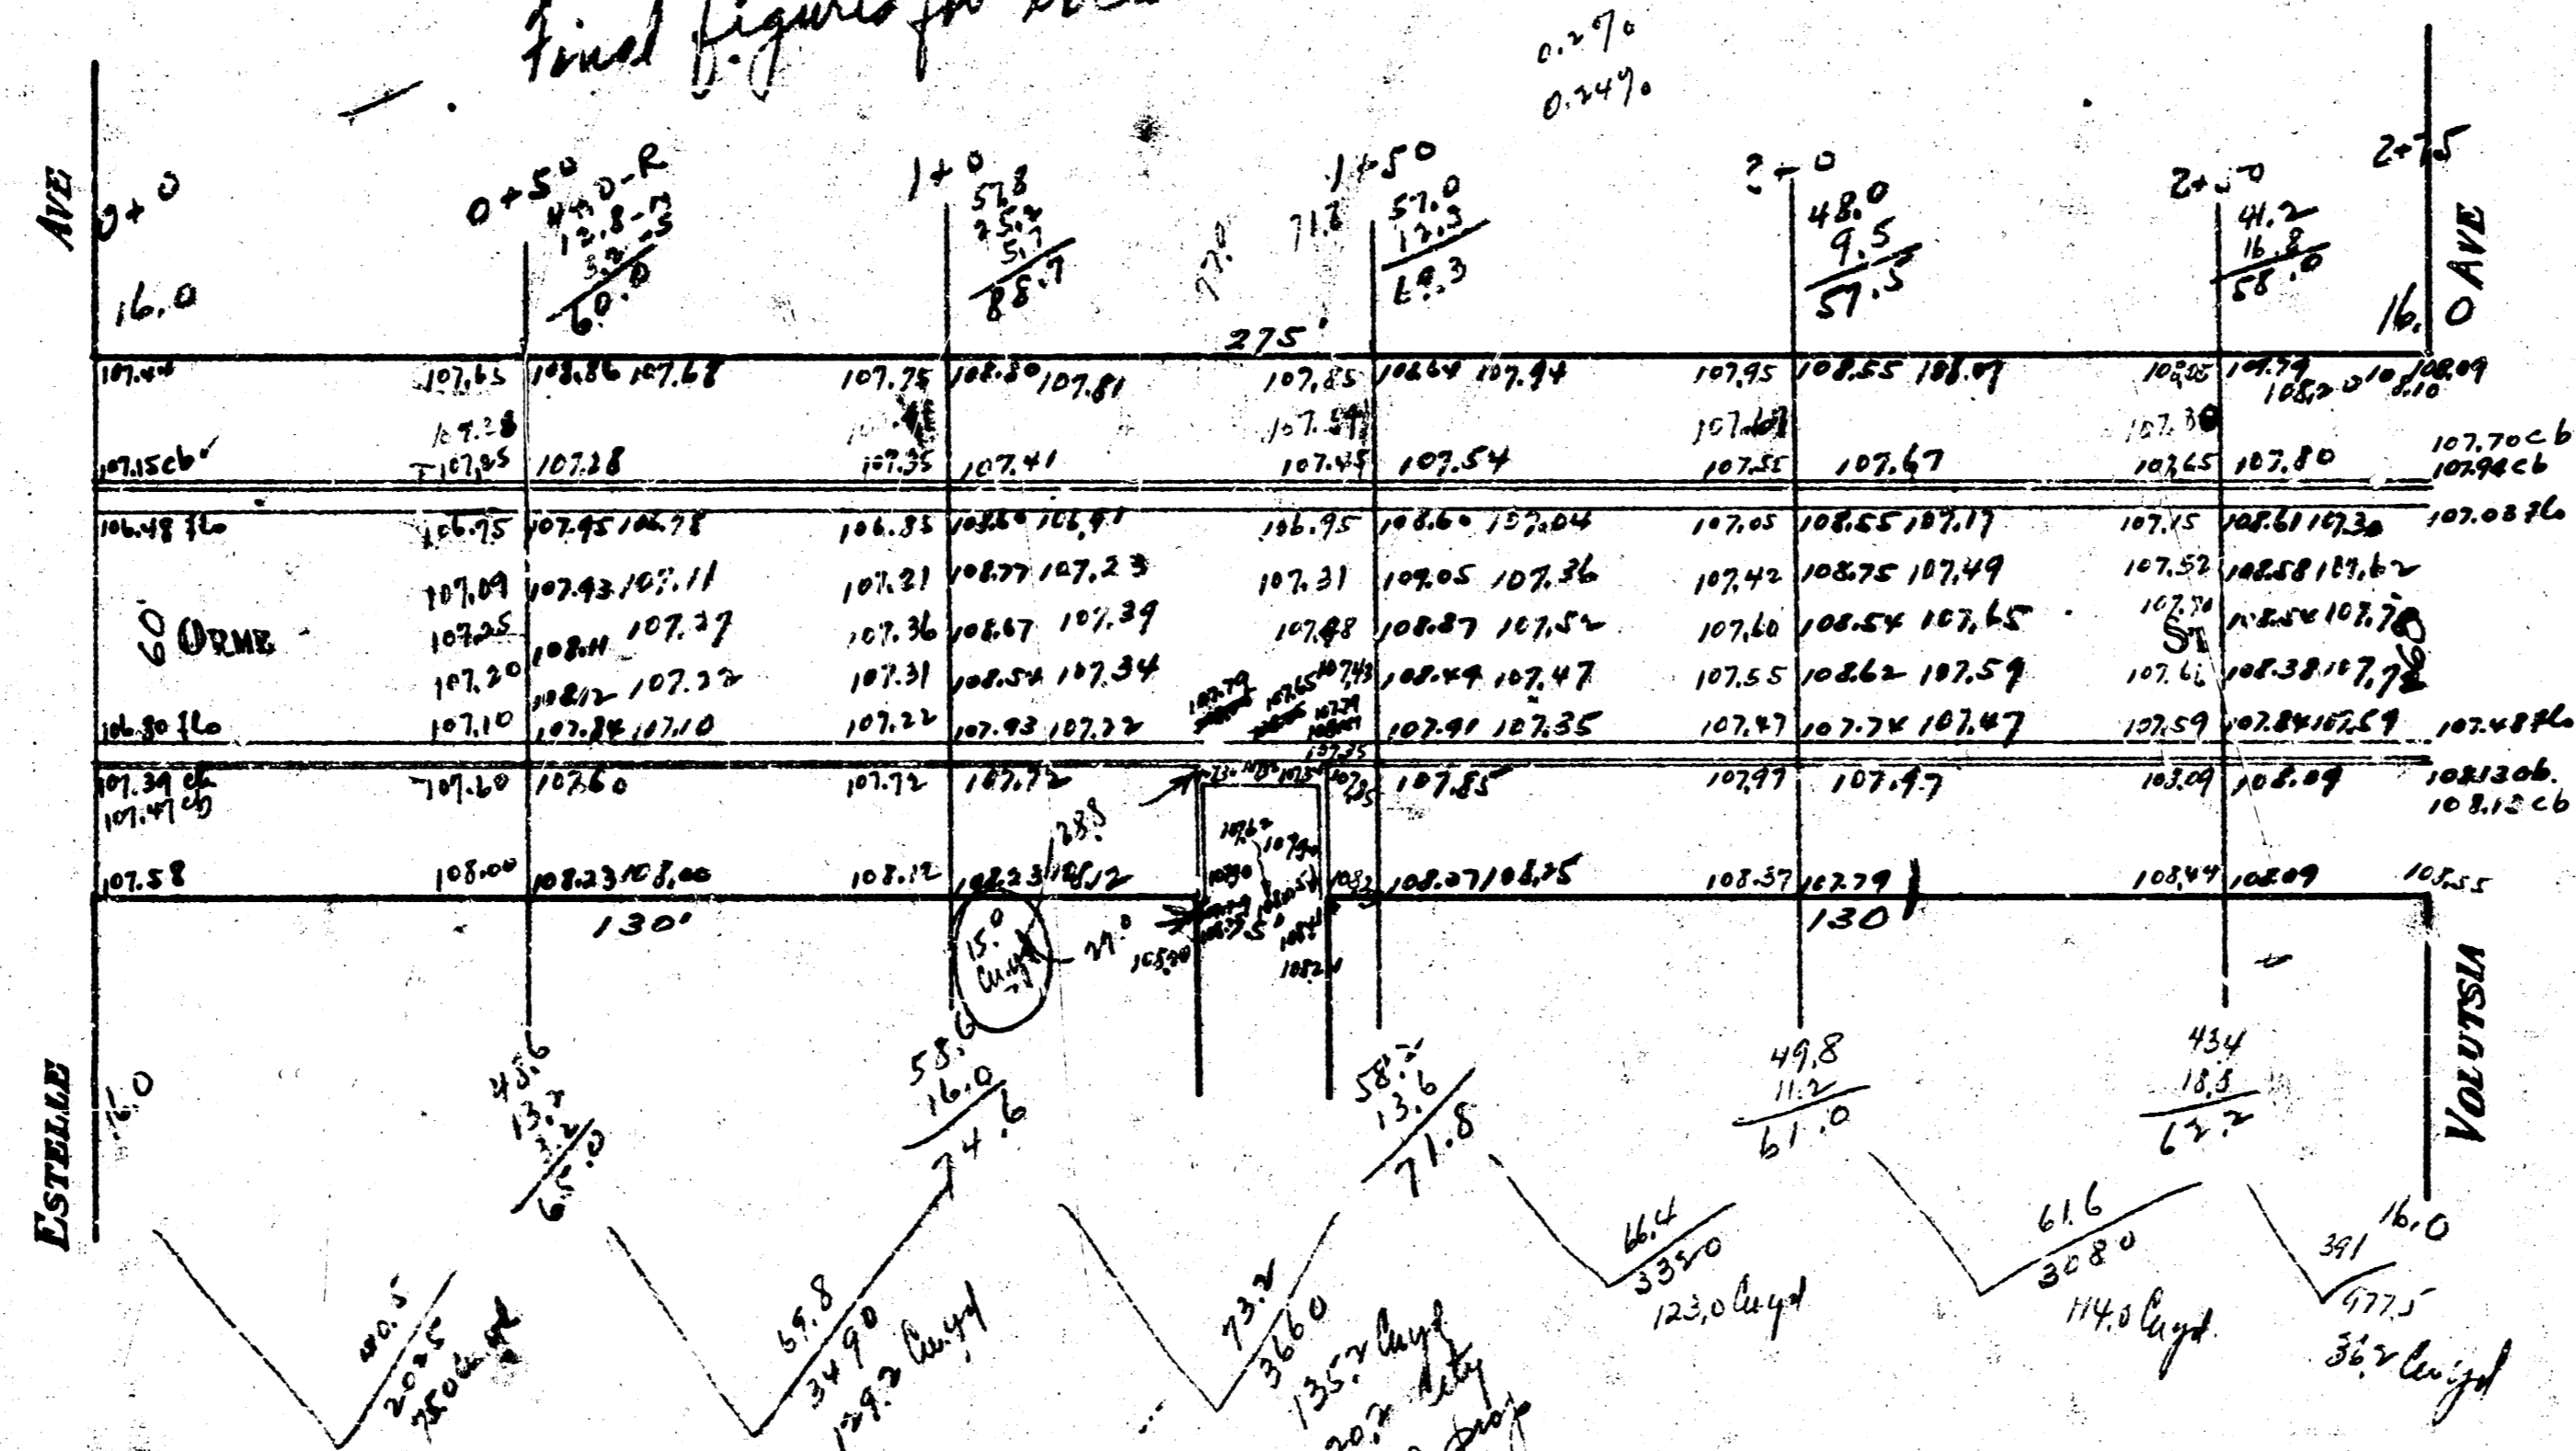

Prop = 5924 + 11070 = 650 cu yd
 cut = 357 + 1070 = 40 cu yd

Paving Plan
 1937
 Orme St
 E.L. Estelle
 W.L. Valutisa