
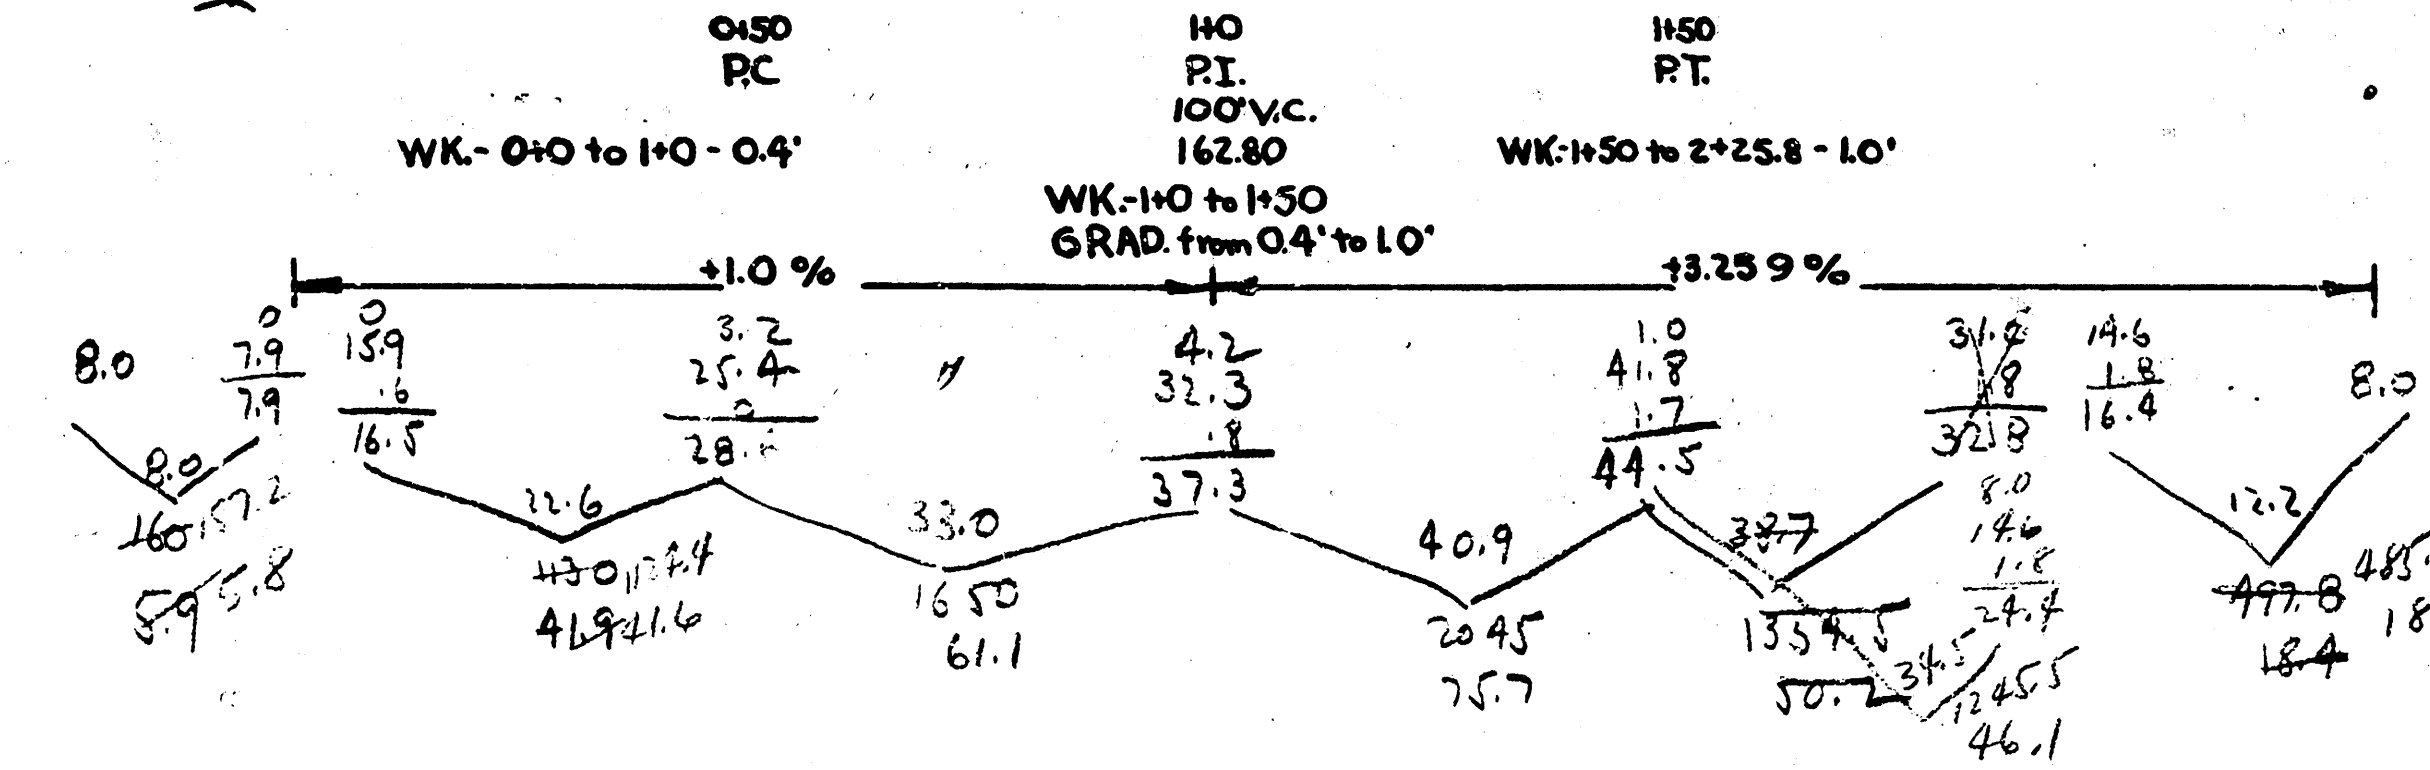


Plank 5  
JK

B.M. 155.40 "X" on cb W.S. Yale N.S. Orme

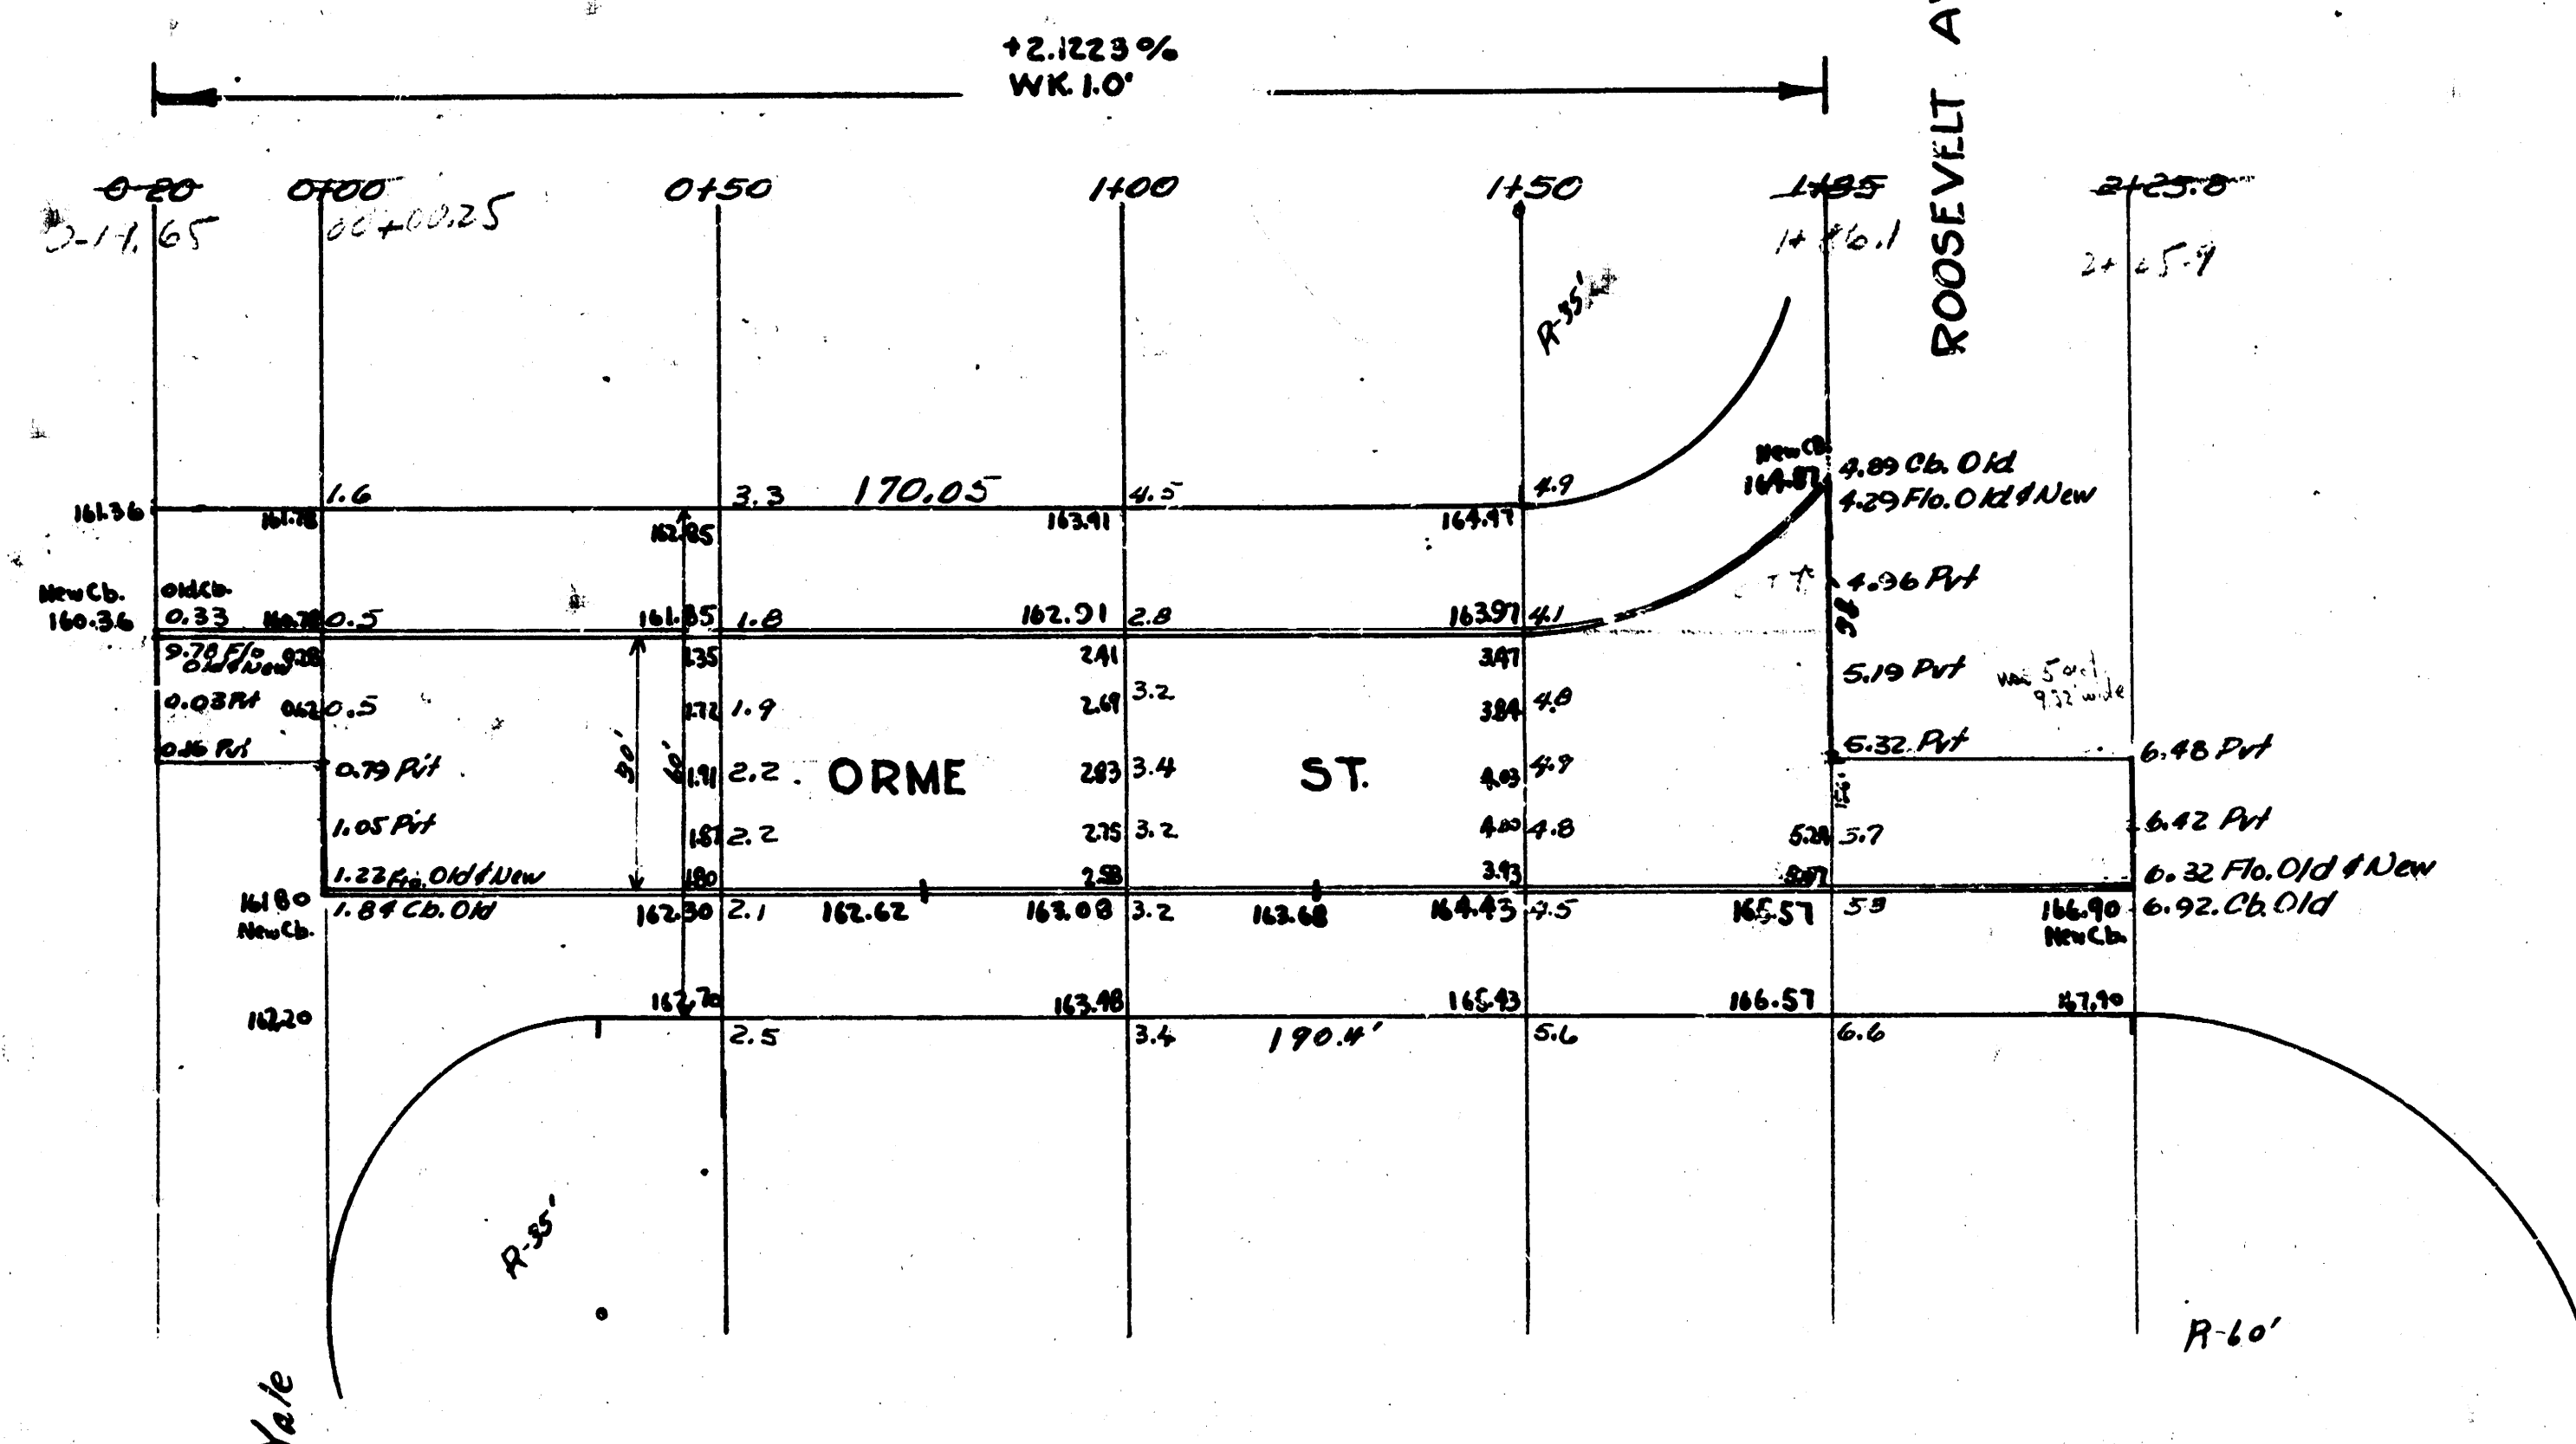

280  
59  
41.9  
61.1  
75.7  
50.2  
18.4  
233.2  
+0.0%  
278.5 cu yds

N

Orme ST.  
EL Yale WL Roosevelt  
30' One. \*Cb.  
City of Wichita, Kansas  
L.K. White City Engineer  
December 1947 Project 017-115